NOTES: + indicates cross cut in concrete 1.50 feet north of original primary building corners.
● indicates railroad spike set.
SCALE: 1"=15' FEBRUARY 1994

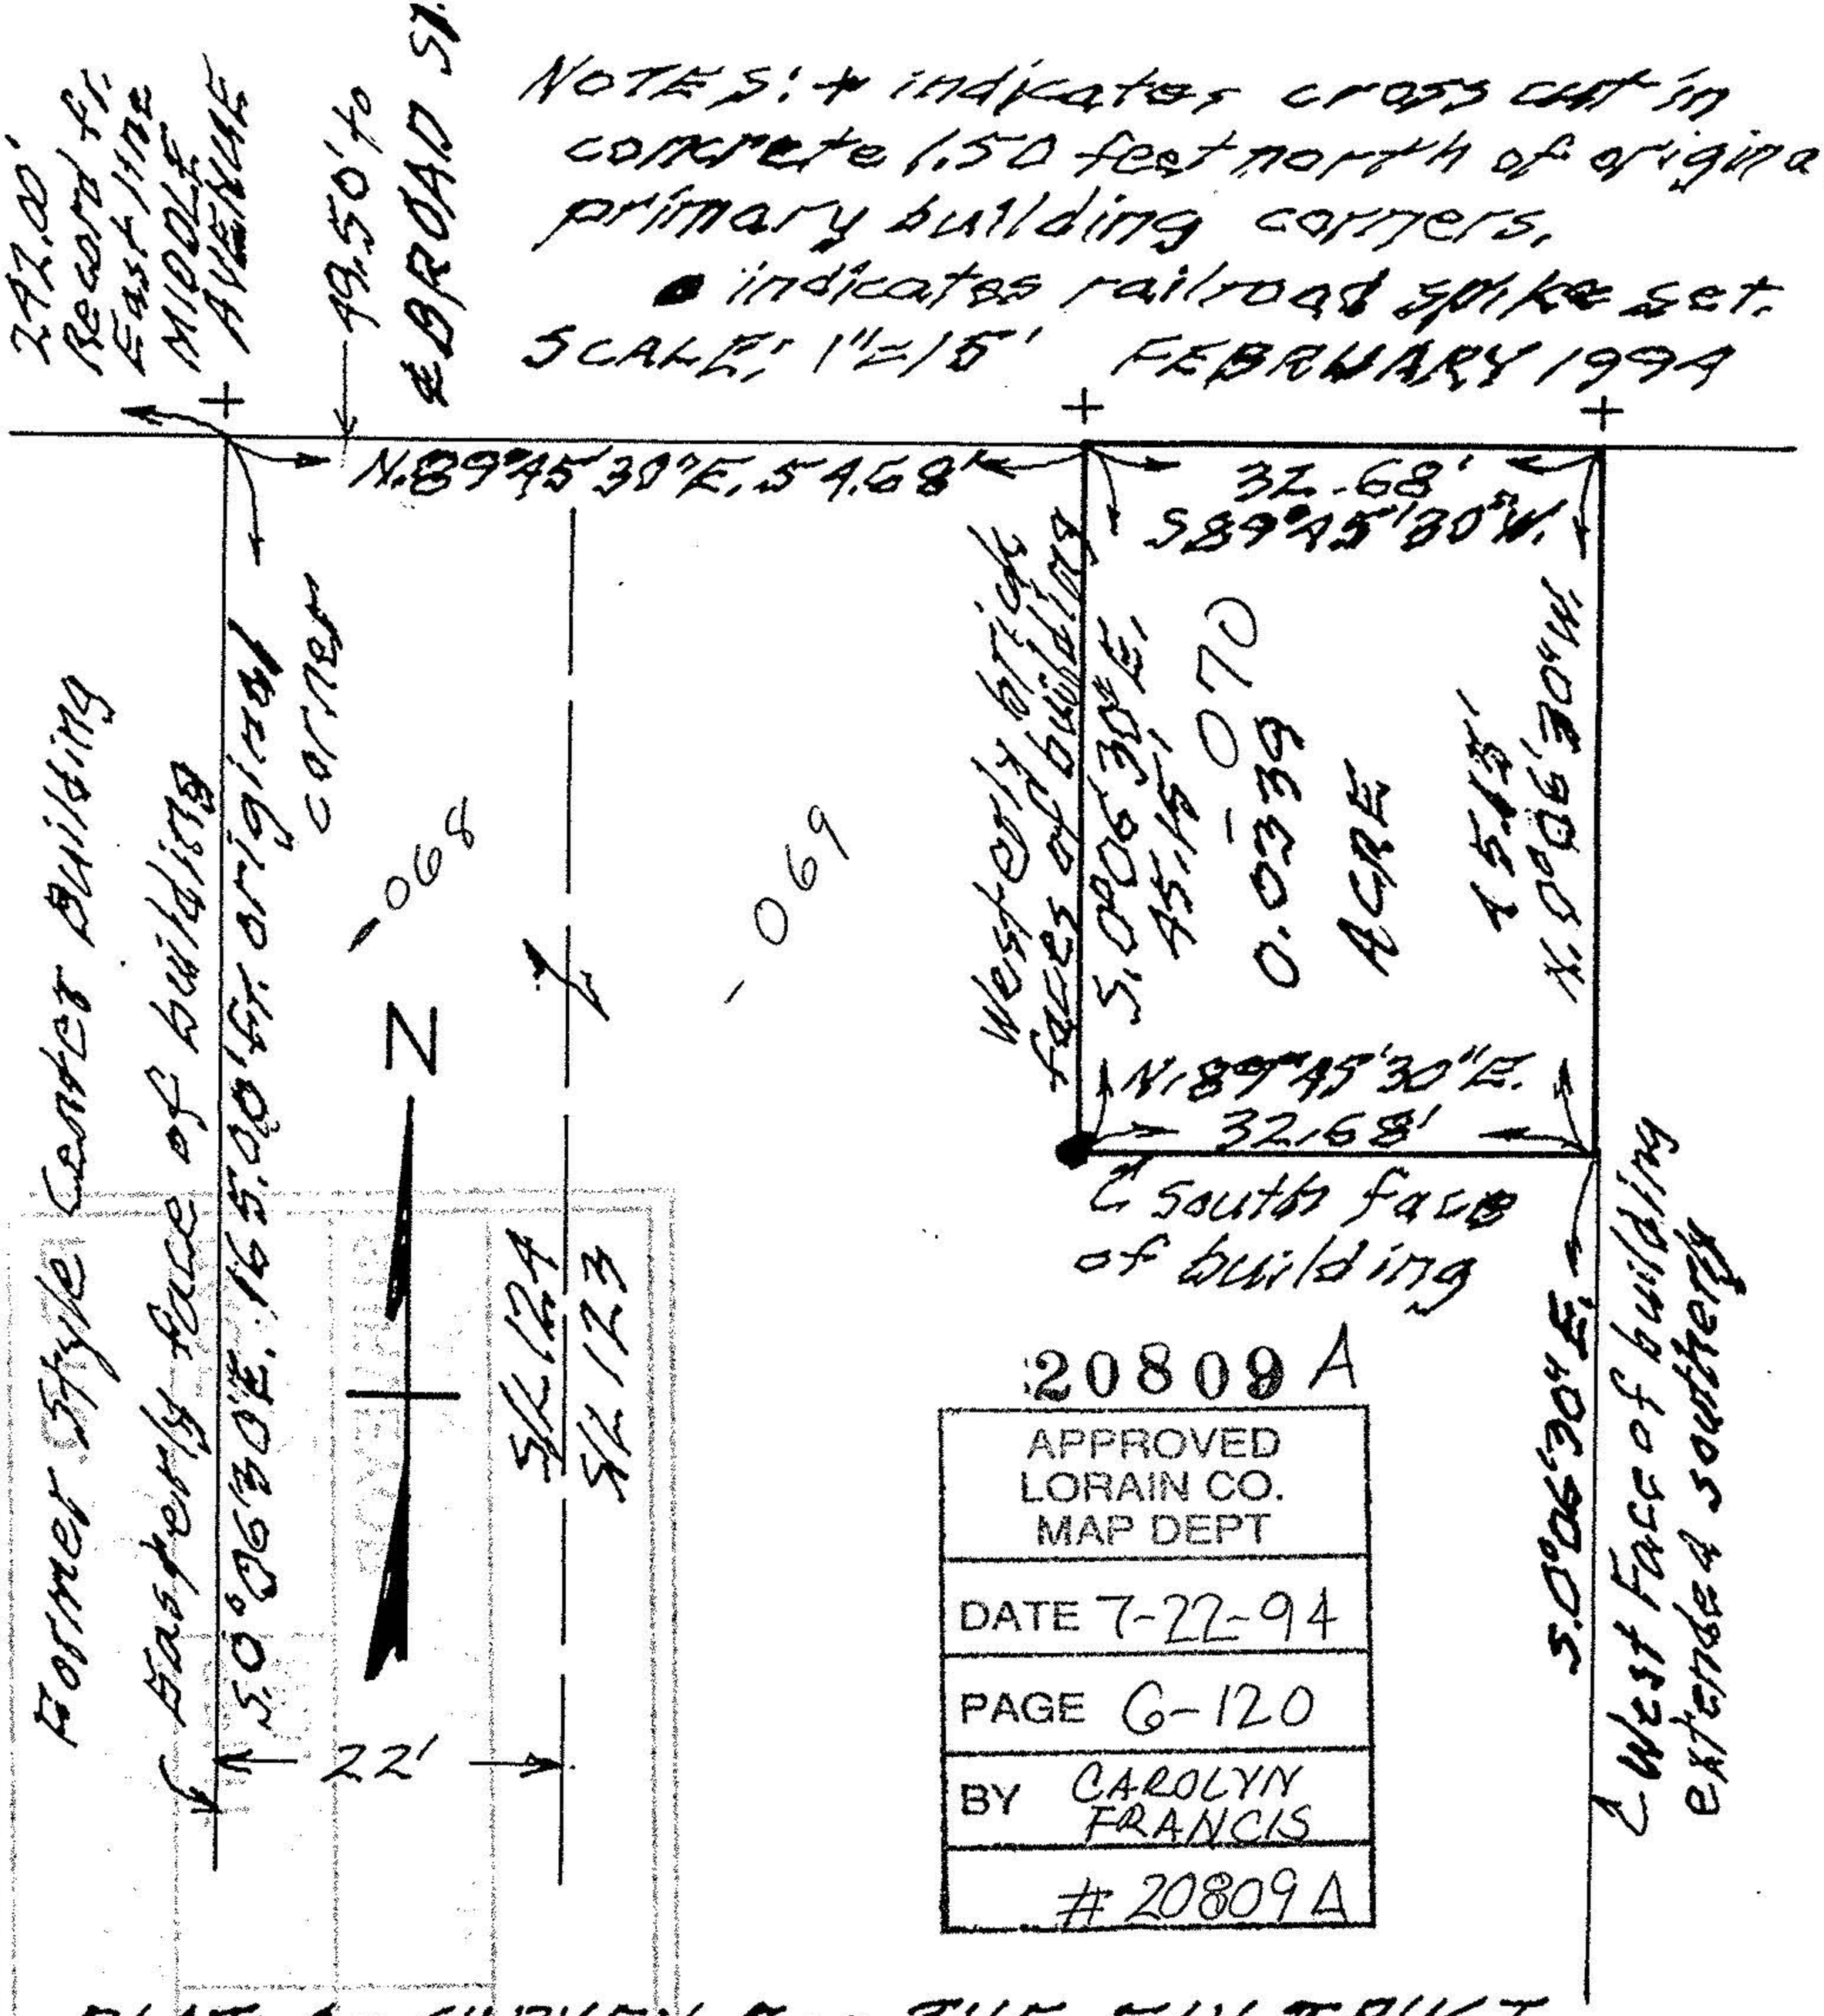

20809 A

APPROVED LORAIN CO. MAP DEPT
DATE 7-22-94
PAGE 6-120
BY CAROLYN FRANCIS
20809 A

PLAT OF SURVEY FOR THE ELY TRUST
C/O DAVID C. GEORGE, ATTORNEY
O.L. 63 BETWEEN THE BRANCHES, ELYRIA TWP.
& CITY — HEMAN ELY'S ORIG. PLAT VOL. 3 PG. 14
Gary E. Penfound — Reg. Surveyor No. 4957

06-26-063-000-070