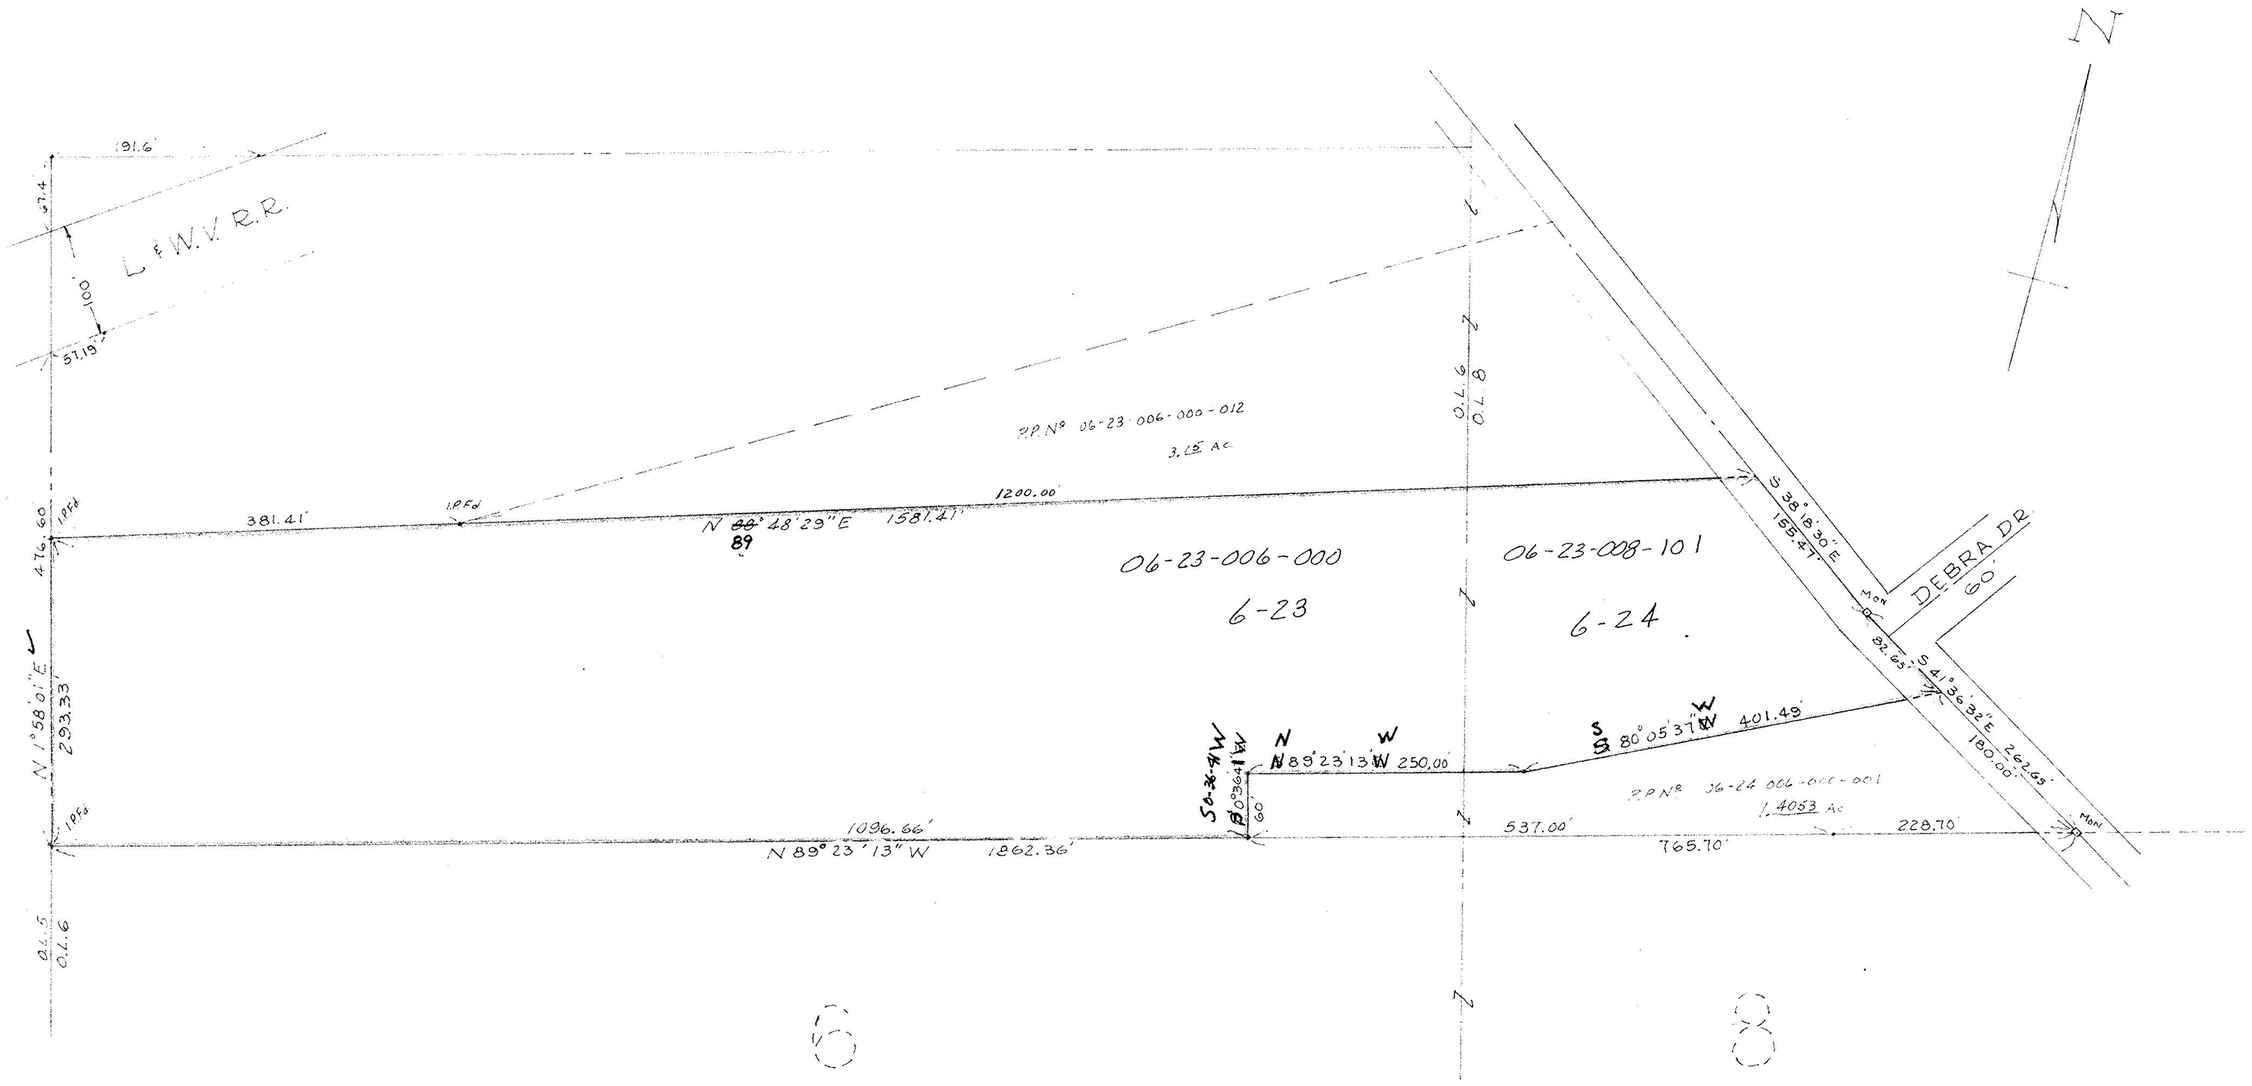

#11645
#11817

APPROVED LORAIN CO. MAP DEPT.
DATE
PAGE
BY
VOID AFTER

I.P.S. - Iron Pin Set
I.P.Fd. - Iron Pin Found
All dimensions are shown to nearest foot & hundredth.
Parcel Surveyed is shown Outlined in red.

STATE OF OHIO
ROBERT H. KRAUSE, JR.
4259
REGISTERED PROFESSIONAL SURVEYOR

PLAT OF SURVEY FOR OMAR & MAMIE KELLY ESTATE

P.P. Nº 06-23-006-000-002 - Parts of Original Elyria Township Lots 6 & 8, Brace Tract, Elyria Township, Lorain County, Ohio 10.6321 Ac.

ROY M. BENJAMIN ASSOC. INC.

SCALE 1" = 100'	DRAWN BY	JOB NO.	SHEET NO.
DATE 12-1977	CHECKED BY	FILE NO.	

Capitol Engr. Print Co. 10 5155 - 5526