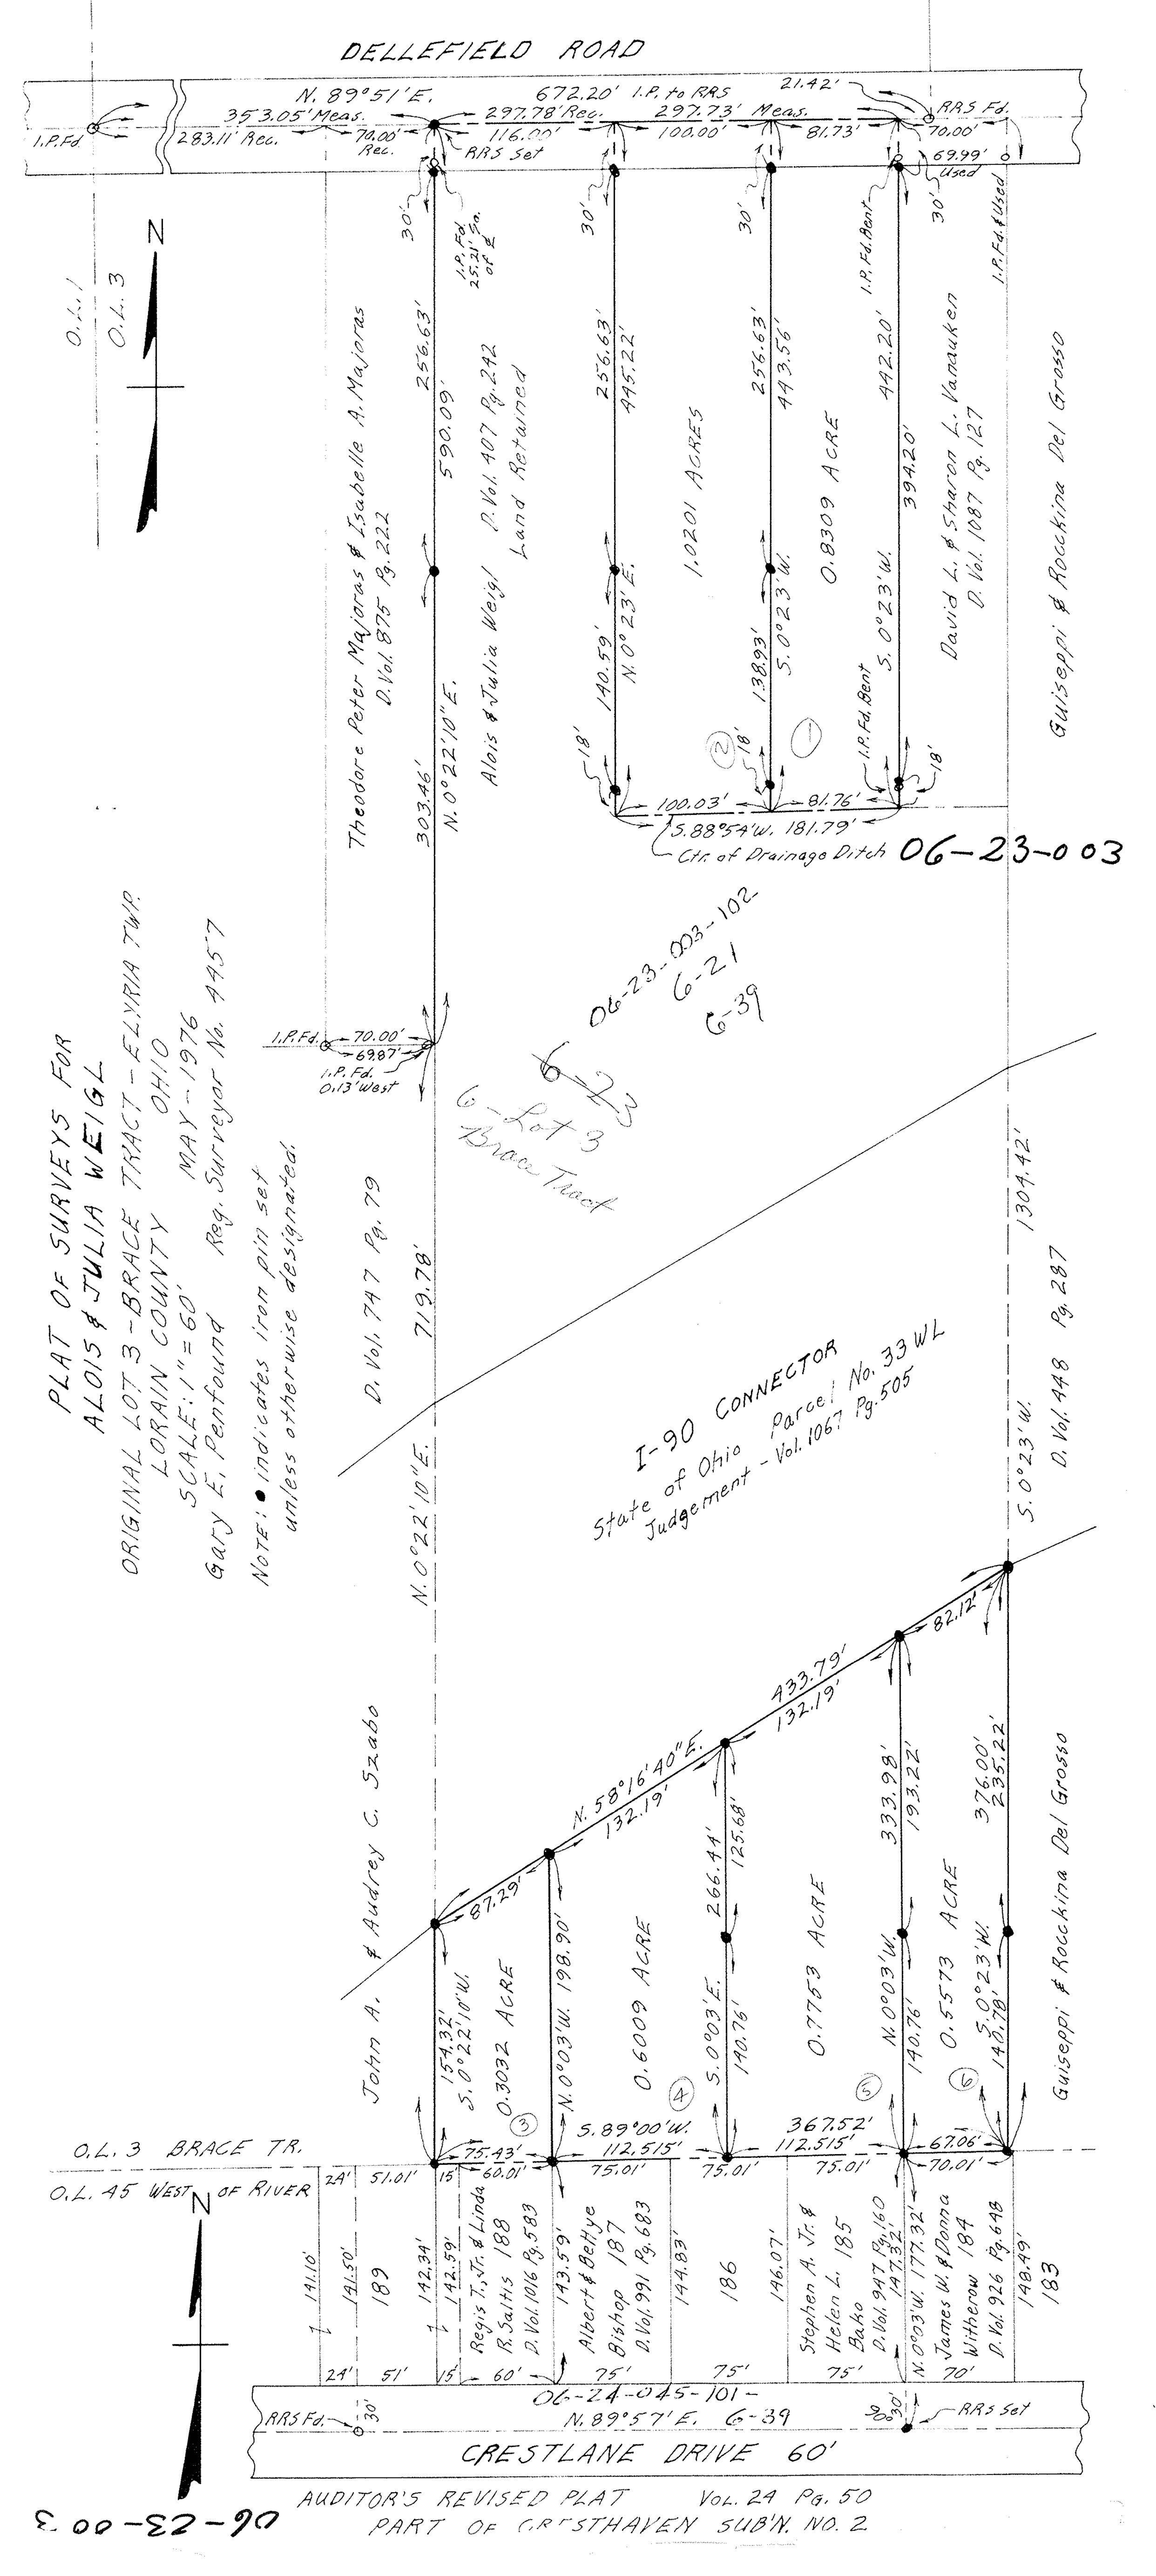
DELLEFIELD ROAD
N. 89°51'E.
353.05' Meas.
283.11' Rec.
I.P.Fd
70.00' Rec.
RRS Set
672.20' I.P. to RRS
297.78' Rec.
116.00'
297.73' Meas.
100.00'
81.73'
21.42'
RRS Fd.
70.00'
69.99' Used
30'
I.P.Fd. 25.21' S. of ℄
256.63'
590.09'
303.46'
N. 0°22'10"E.
Theodore Peter Majoras & Isabelle A. Majoras
D. Vol. 875 Pg. 222
Alois & Julia Weigl
P. Vol. 407 Pg. 242
Land Retained
1.0201 ACRES
256.63'
495.22'
140.59'
N. 0°23'E.
0.8309 ACRE
256.63'
443.56'
138.93'
S. 0°23'W.
I.P.Fd. Bent
442.20'
394.20'
S. 0°23'W.
David L. & Sharon L. Vanauken
D. Vol. 1087 Pg. 127
I.P.Fd. Used
Guiseppi & Rockina Del Grosso
18'
100.03'
81.76'
S. 88°54'W. 181.79'
Ctr. of Drainage Ditch
06-23-003
06-23-003-102
6-21
6-39
I.P.Fd.
70.00'
69.87'
I.P.Fd. 0.13' West
6-Lot 3 Brace Tract
PLAT OF SURVEYS FOR
ALOIS & JULIA WEIGL
ORIGINAL LOT 3 - BRACE TRACT - ELYRIA TWP.
LORAIN COUNTY OHIO
SCALE: 1" = 60'
MAY - 1976
Gary E. Penfound Reg. Surveyor No. 4457
NOTE: • indicates iron pin set
unless otherwise designated.
719.78'
D. Vol. 747 Pg. 79
N. 0°22'10"E.
I-90 CONNECTOR
State of Ohio Parcel No. 33 WL
Judgement - Vol. 1067 Pg. 505
1304.42'
S. 0°23'W.
D. Vol. 448 Pg. 287
John A. & Audrey C. Szabo
87.29'
N. 58°16'40"E.
132.19'
433.79'
132.19'
82.12'
154.32'
S. 0°22'10"W.
0.3032 ACRE
198.90'
N. 0°03'W.
0.6009 ACRE
266.44'
125.68'
S. 0°03'E.
140.76'
0.7763 ACRE
333.98'
193.22'
N. 0°03'W.
140.76'
0.5573 ACRE
376.00'
235.22'
S. 0°23'W.
140.78'
Guiseppi & Rockina Del Grosso
O.L. 3 BRACE TR.
O.L. 45 WEST OF RIVER
24'
51.01'
15'
75.43'
60.01'
5.89°00'W.
112.515'
75.01'
112.515'
75.01'
367.52'
75.01'
67.06'
70.01'
141.10'
141.50'
142.34'
142.59'
189
Regis T. Jr. & Linda R. Saiths 188
D. Vol. 1016 Pg. 583
143.59'
Albert & Bethye Bishop 187
D. Vol. 991 Pg. 683
144.83'
186
146.07'
Stephen A. Jr. & Helen L. Bako
D. Vol. 947 Pg. 160
147.32'
177.32'
N. 0°03'W.
James W. & Donna Witherow 184
D. Vol. 926 Pg. 648
148.49'
183
24'
51'
15'
60'
75'
75'
75'
70'
06-24-045-101
N. 89°57'E. 6-39
RRS Fd.
30'
30'
RRS Set
CRESTLANE DRIVE 60'
AUDITOR'S REVISED PLAT Vol. 24 Pg. 50
PART OF CRESTHAVEN SUB'N. NO. 2
06-23-003