


NORTH  
SCALE 1"=100'

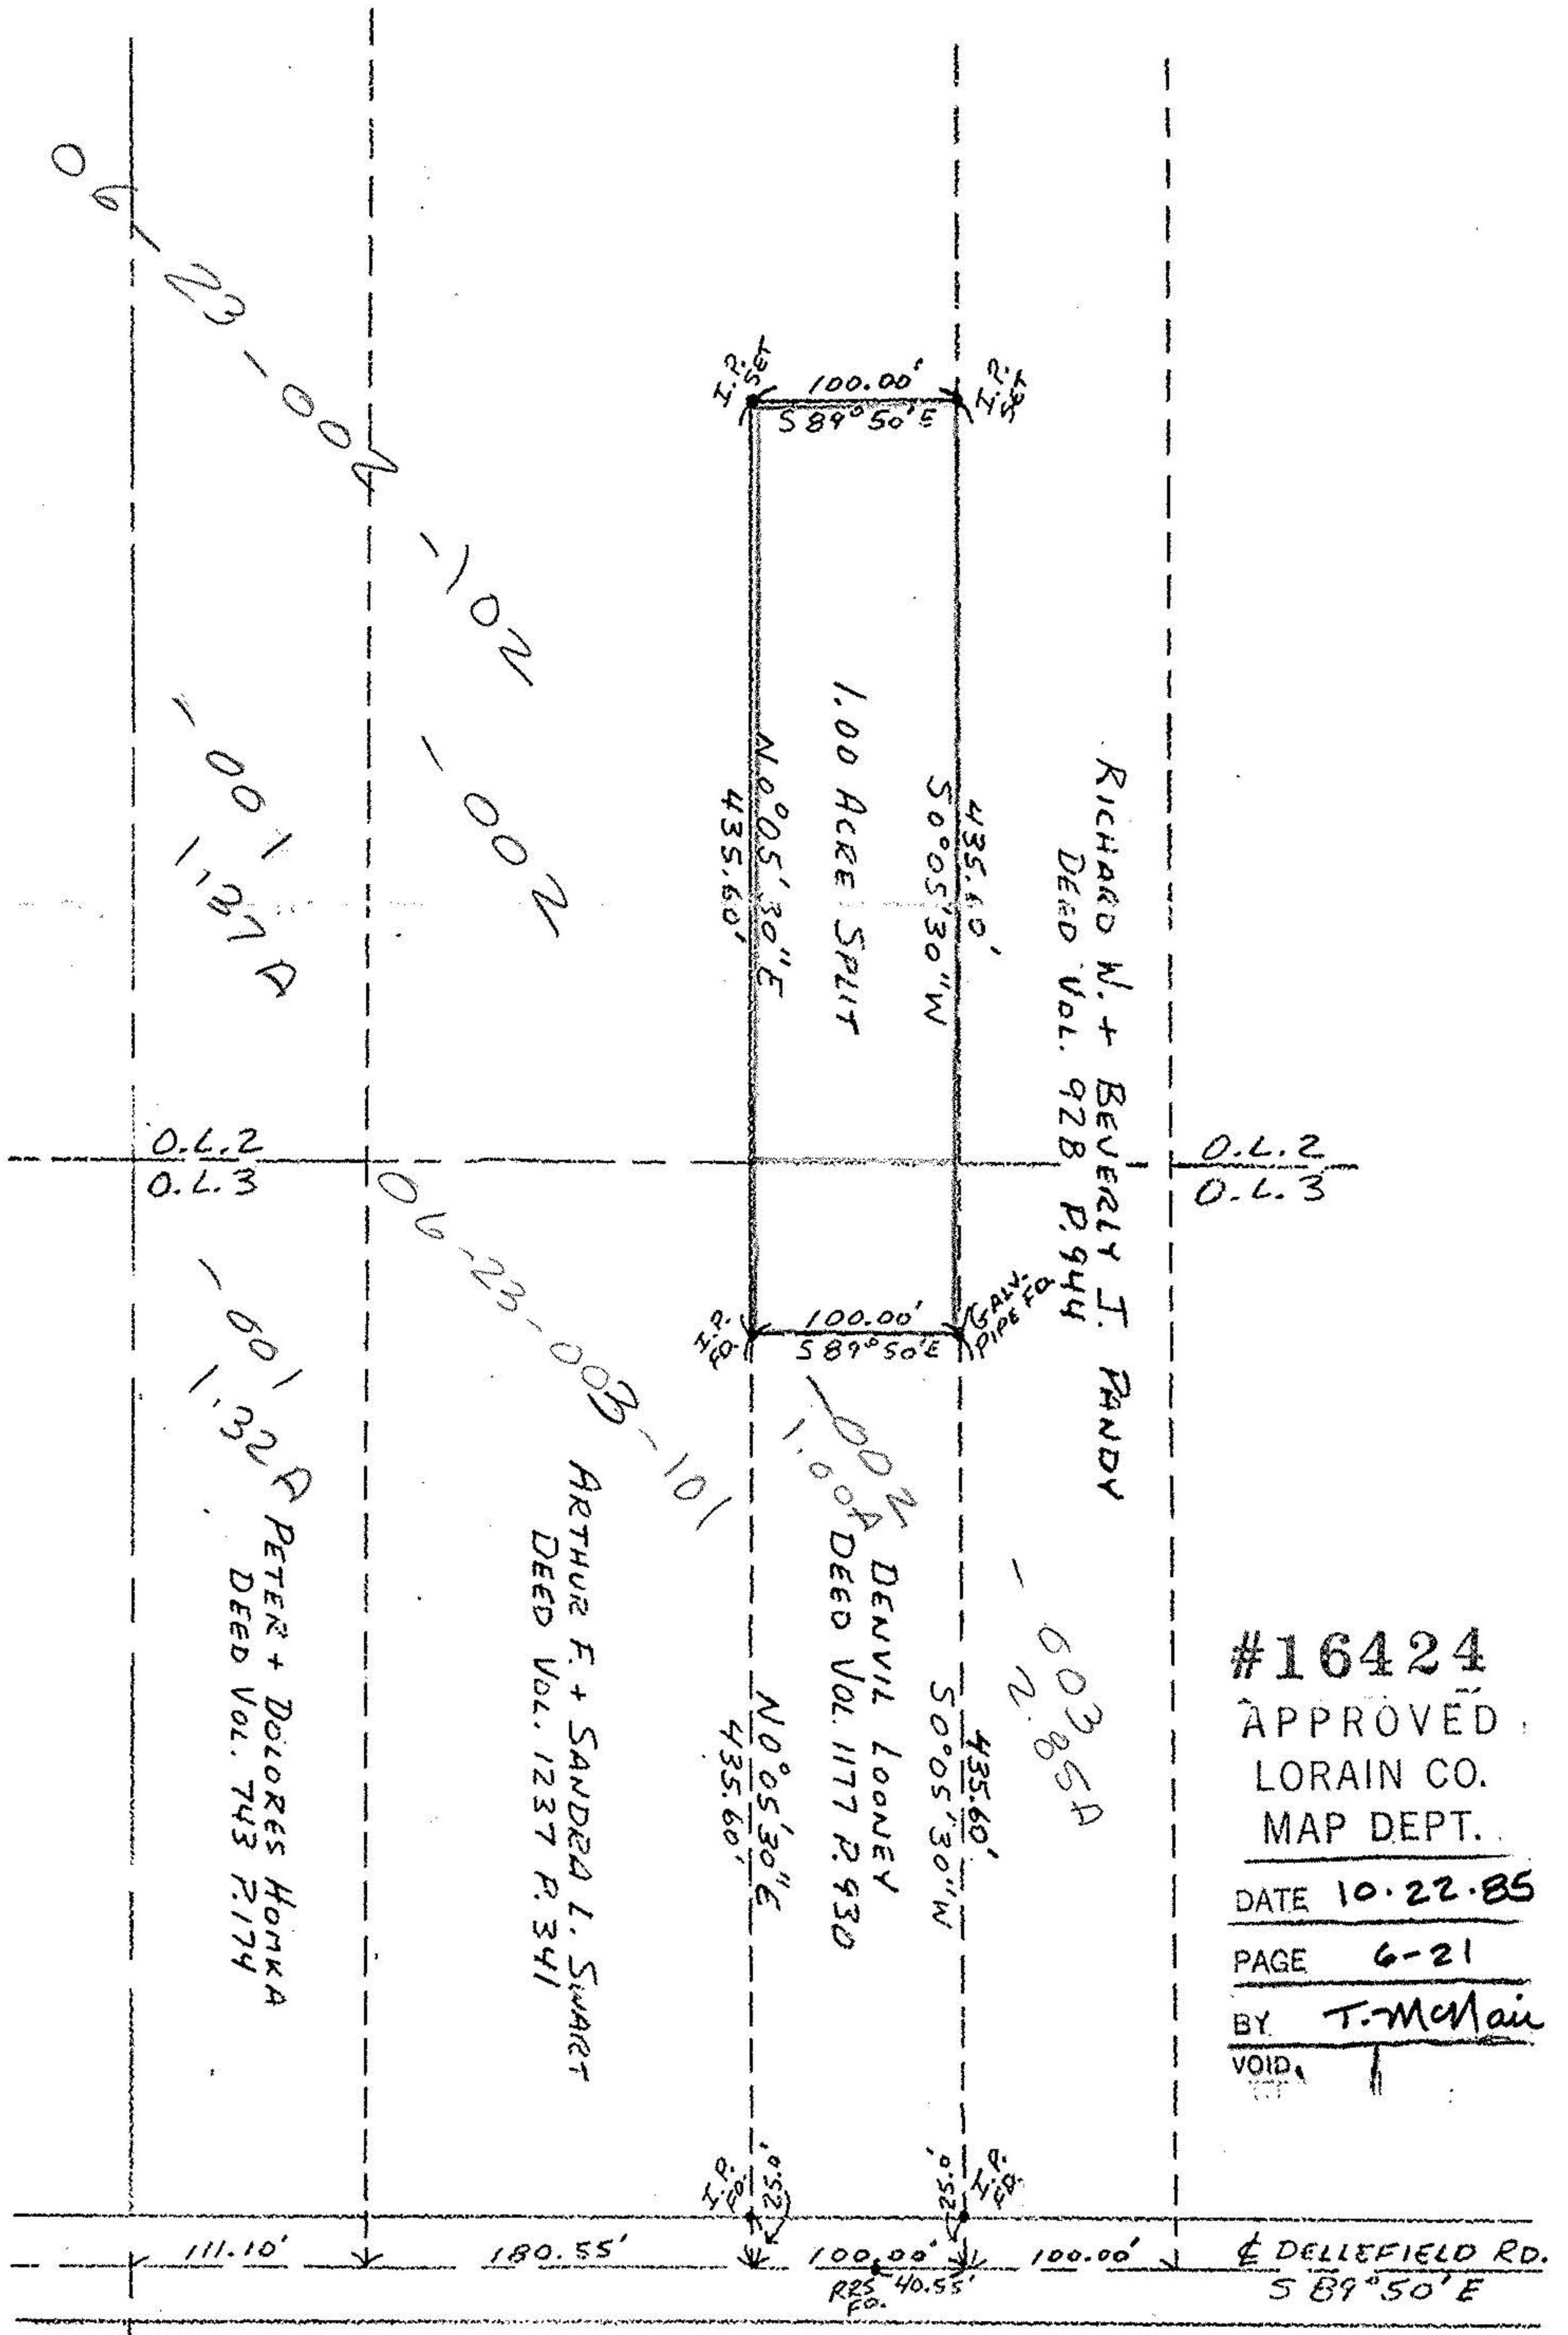

APPROVED BY THE LORAIN CITY PLANNING COMMISSION  
SECRETARY LORAIN CITY PLANNING COMMISSION

**APPROVED**  
AS TO DESCRIPTION ONLY

Date 10-16-85  
City of Lorain  
Per *James E. Linn*  
ENGINEER

#16424  
APPROVED  
LORAIN CO.  
MAP DEPT.  
DATE 10-22-85  
PAGE 6-21  
BY T. McMan  
VOID

SURVEY OF 1.00 ACRE SPLIT FOR DENVIL LOONEY  
ELYRIA TWP. O.L. #2 + #3  
DATE 6/15/85  
JOHN R. HAMILTON  
REG. SURV. #6861  
APPROVED BY: *JRH*  
DRAWN BY: *JRH*  
REVISED

DRAWING NUMBER