9261
6-21

PLAT OF SURVEY FOR
MRS. ELIZABETH BREZNAI
ORIGINAL LOTS 2&3 - BRACE TRACT - EL[illegible]IA TWP.
LORAIN COUNTY - OHIO
SCALE: 1" = 100' MARCH - 19[illegible]
Gary E. Penfound Reg. Surveyor N[illegible]4457

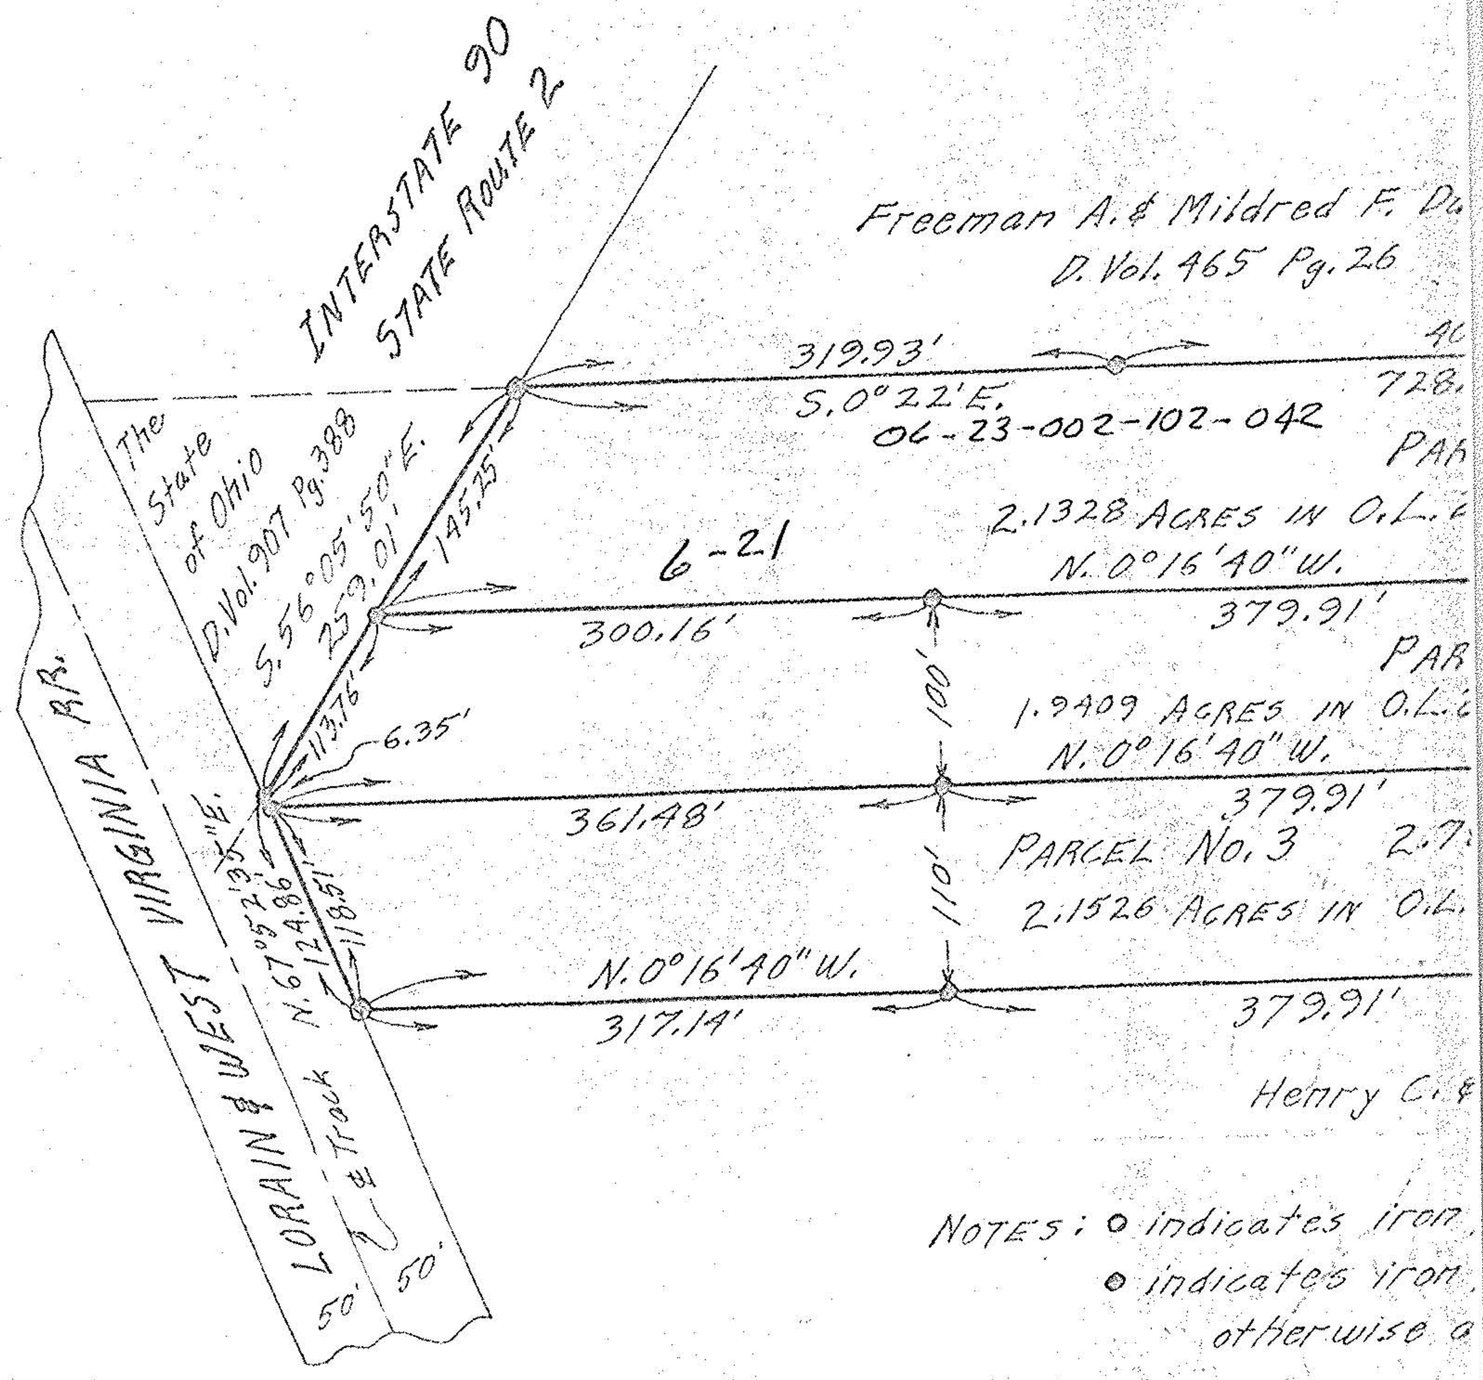

NOTES: ○ indicates iron [illegible] found.
● indicates iron [illegible] set unless otherwise [illegible]nated.

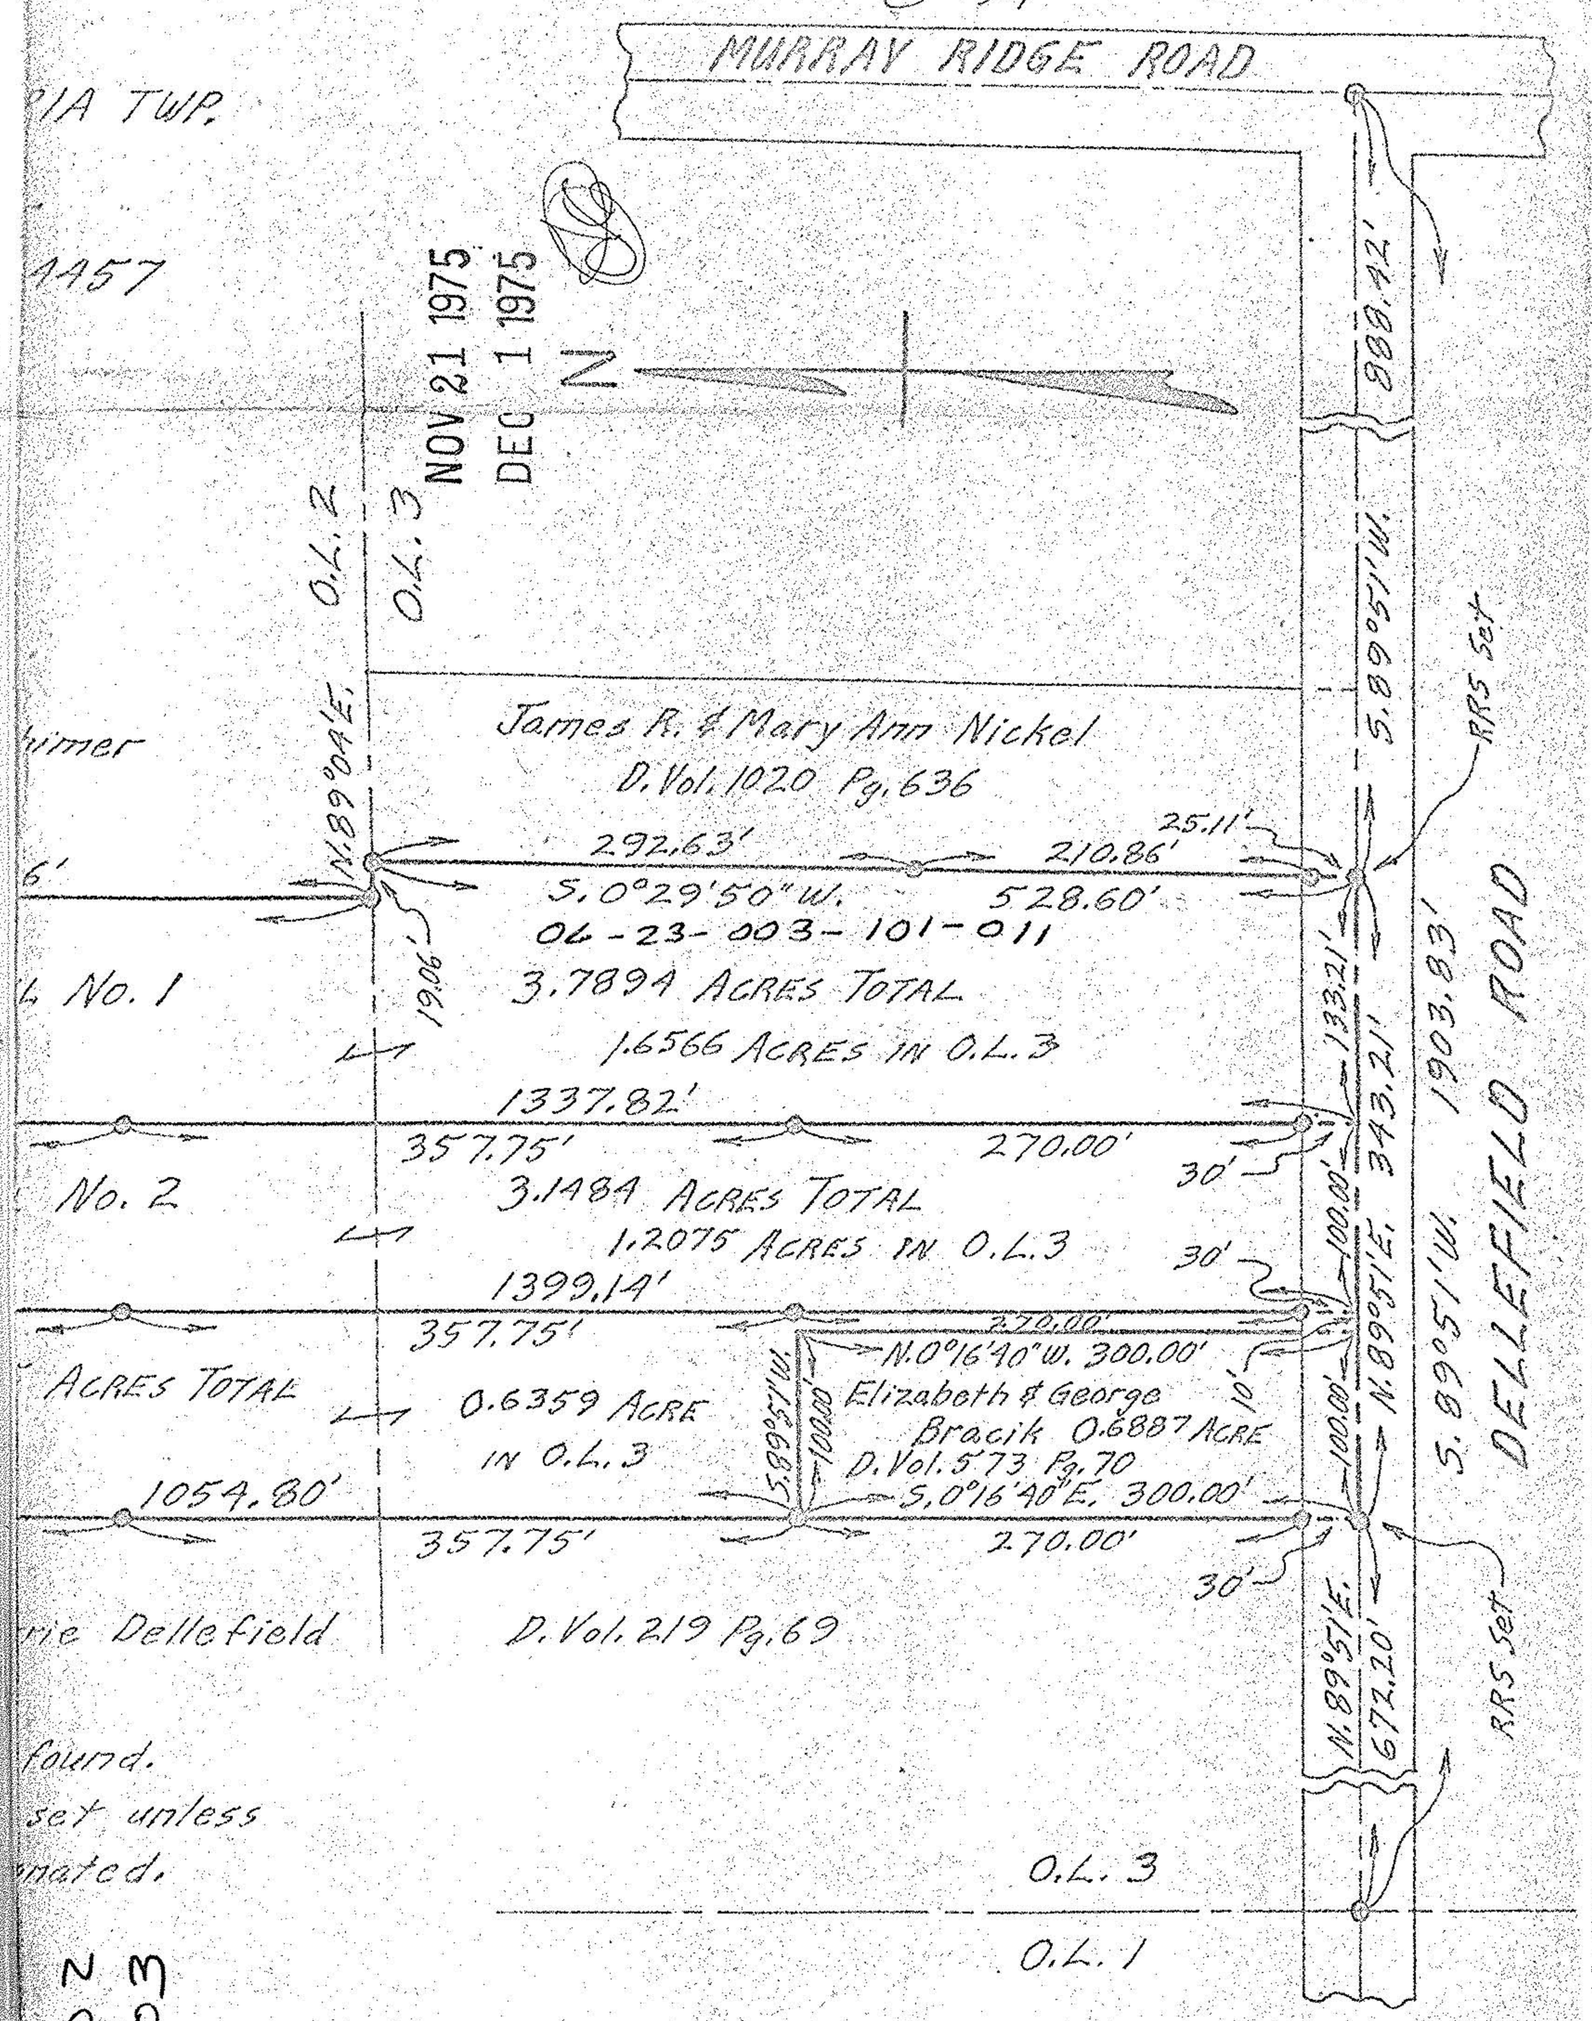

NOV 21 1975
DEC 1 1975

6-23-002
6-23-003