TOPOGRAPHICAL SURVEY OF PART OF ELYRIA TOWNSHIP
ORIGINAL LOTS Nos 1 & 6 WEST OF BLACK RIVER

TOWNSHIP OF ELYRIA
COUNTY OF LORAIN
STATE OF OHIO

SCALE: 1" = 100'

MAY 1970
REV. 3-11-78
REV. 4-11-80

PREPARED BY
JAMES H. SCHMIDT
REGISTERED SURVEYOR

NOTE: ADD 700.00 TO ELEVATIONS SHOWN

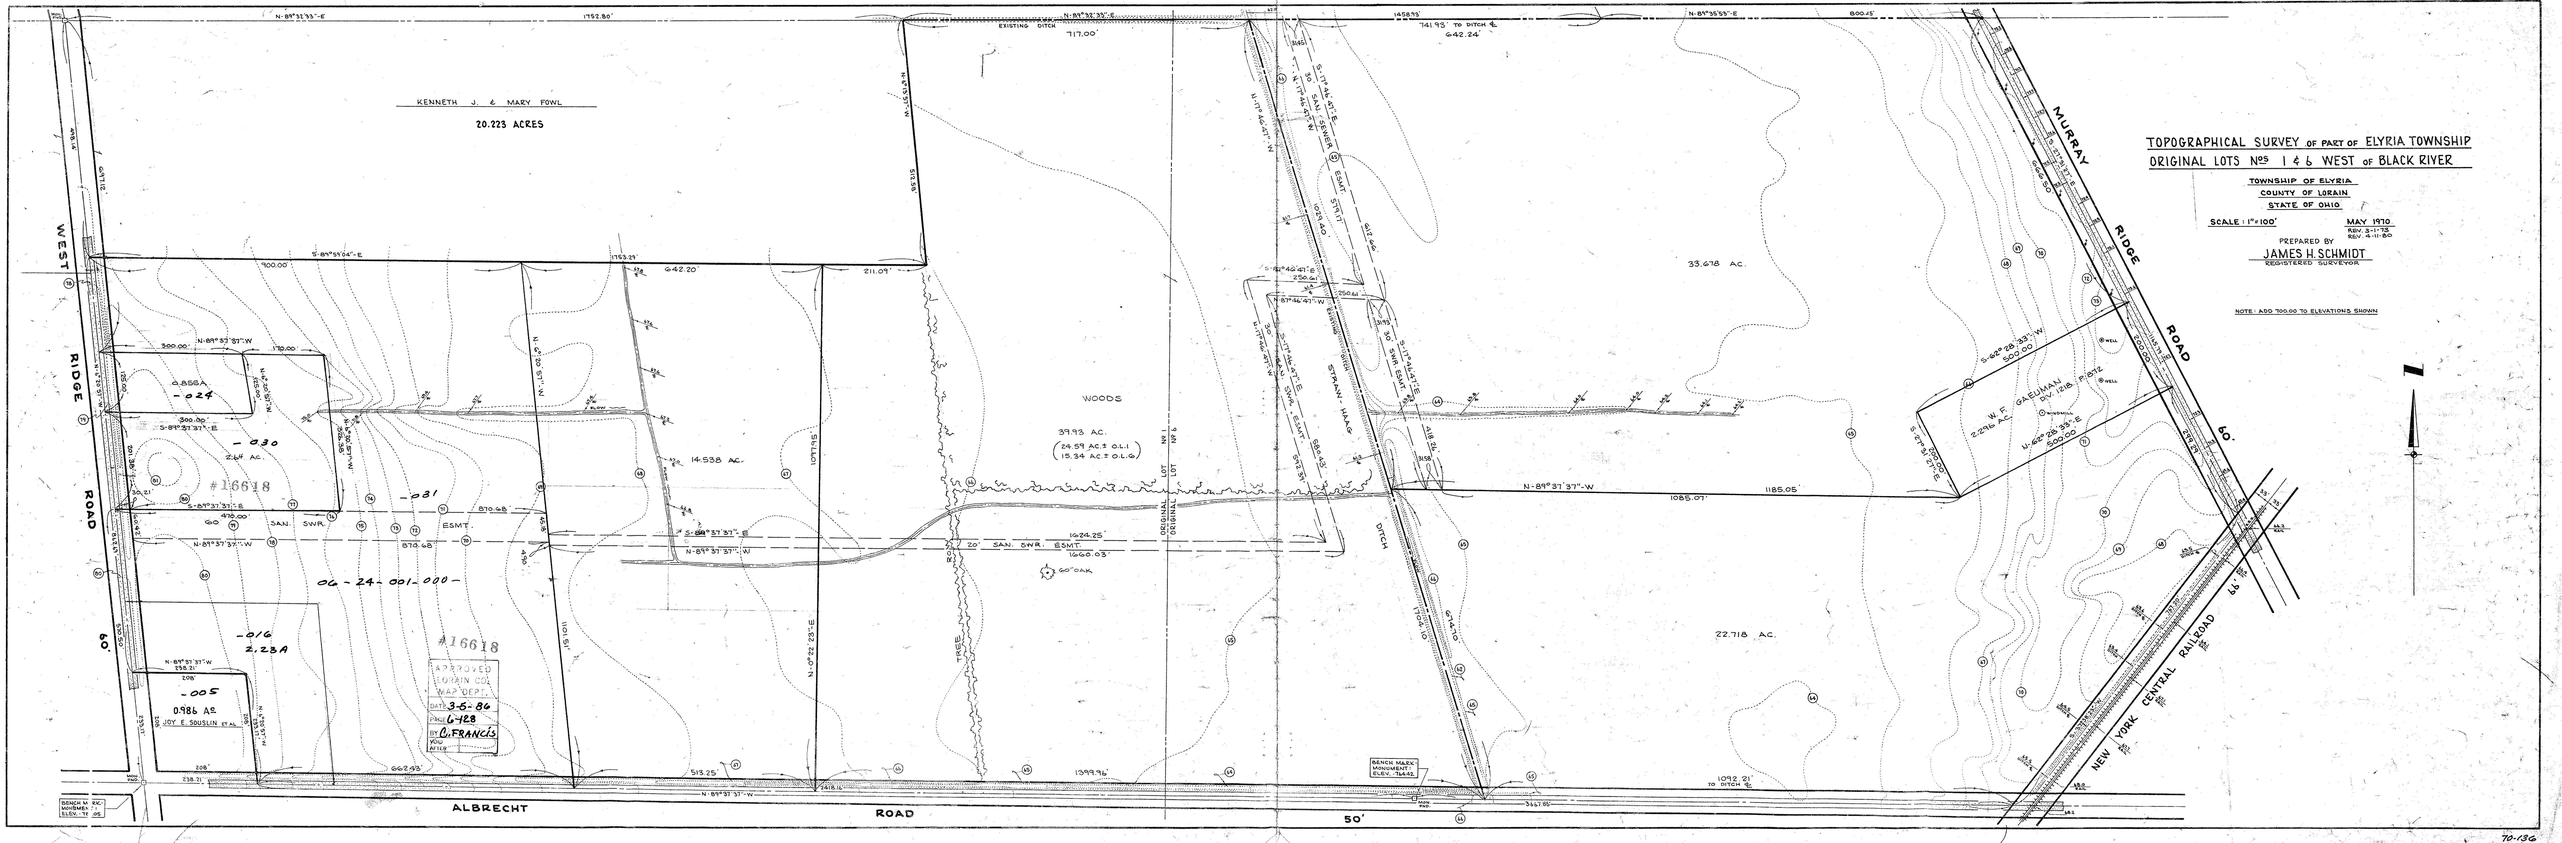

70-136