TOPOGRAPHICAL SURVEY OF PART OF ELYRIA TOWNSHIP
ORIGINAL LOTS Nos 1 & 6 WEST OF BLACK RIVER

TOWNSHIP OF ELYRIA
COUNTY OF LORAIN
STATE OF OHIO

SCALE: 1" = 100'

MAY 1970
REV. 3-11-78
REV. 4-11-80

PREPARED BY
JAMES H. SCHMIDT
REGISTERED SURVEYOR

NOTE: ADD 700.00 TO ELEVATIONS SHOWN

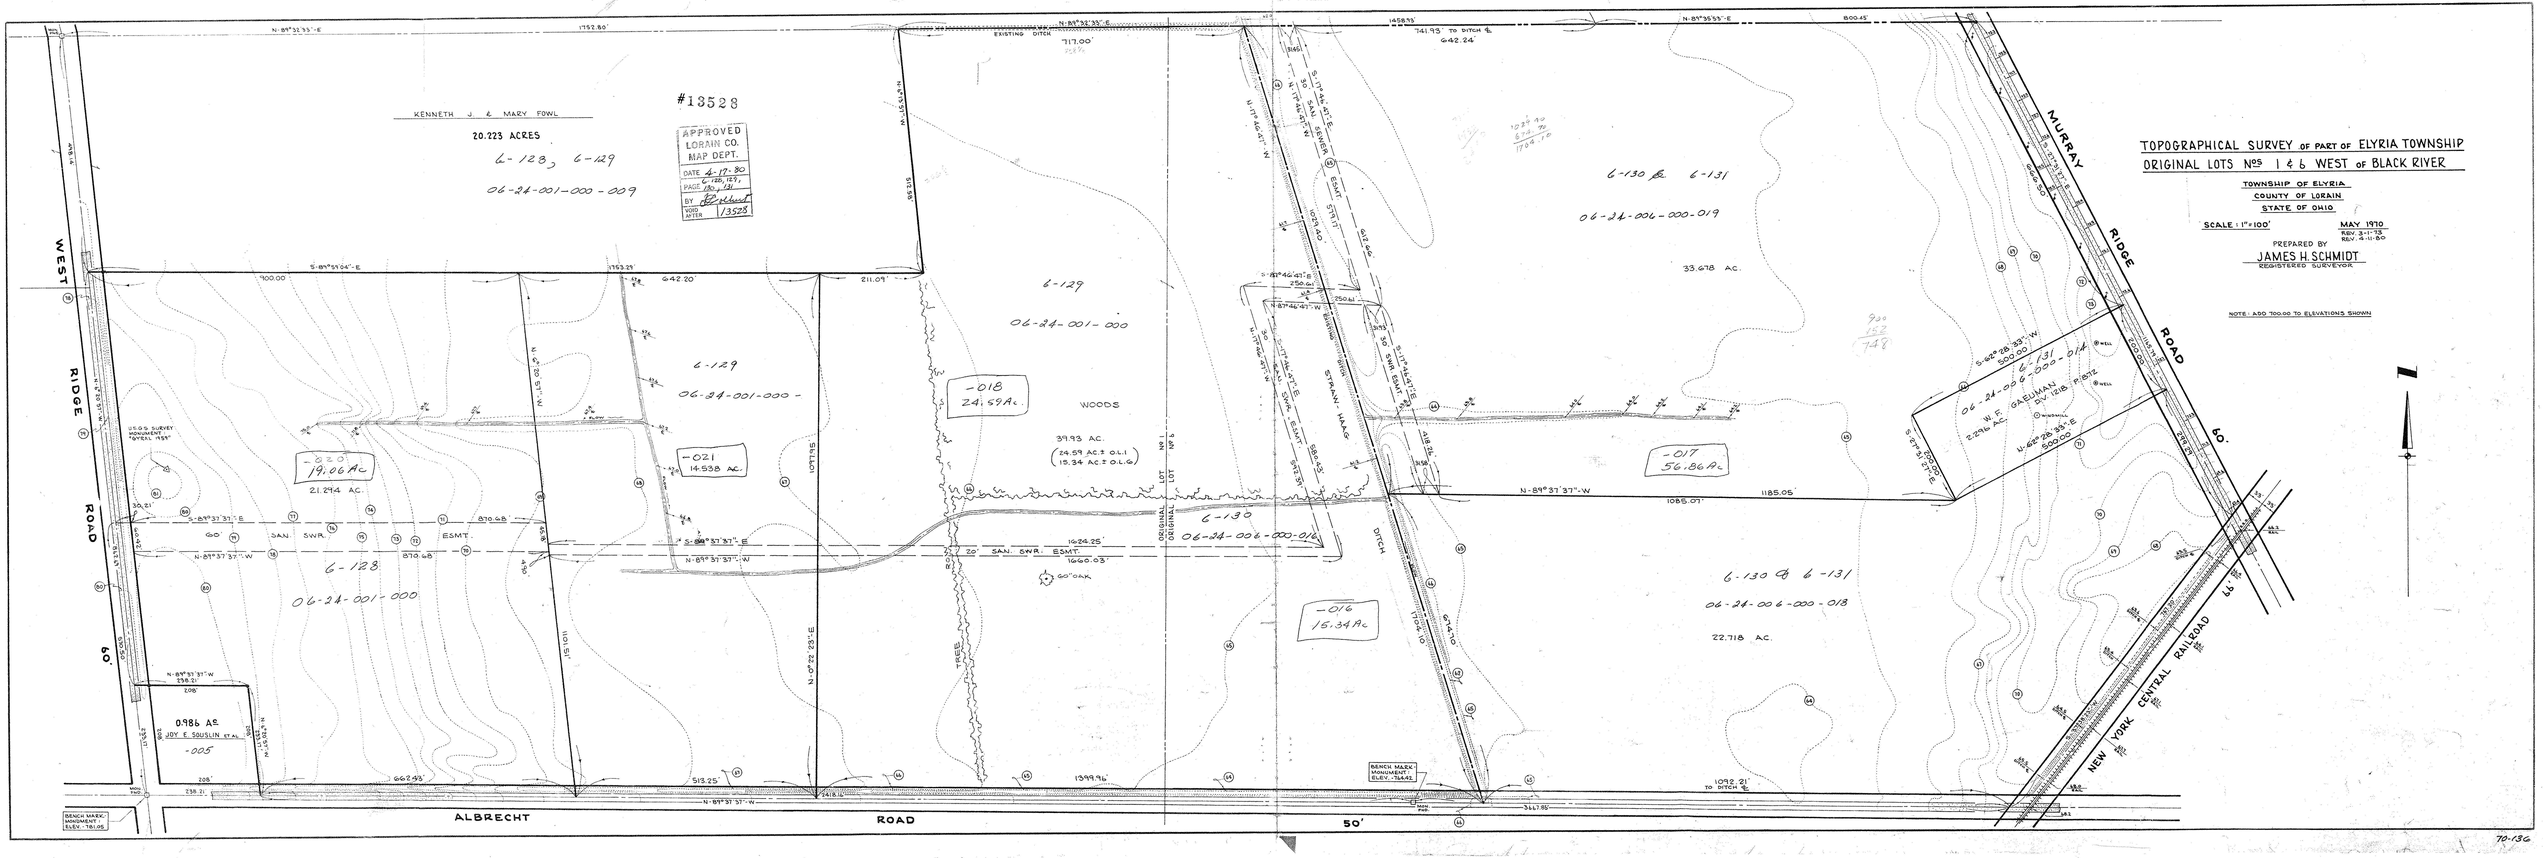
KENNETH J. & MARY FOWL
20.223 ACRES
6-128, 6-129
06-24-001-000-009
#13528
APPROVED
LORAIN CO.
MAP DEPT.
DATE 4-17-80
PAGE 128, 129
BY
VOID AFTER 13528
WEST RIDGE ROAD 60'
MURRAY RIDGE ROAD 60'
ALBRECHT ROAD 50'
NEW YORK CENTRAL RAILROAD
6-129
06-24-001-000
6-128
06-24-001-000
6-130
06-24-006-000-016
6-130 & 6-131
06-24-006-000-018
22.718 AC.
6-130 & 6-131
06-24-006-000-019
33.678 AC.
6-131
06-24-006-000-014
W. F. GAEUMAN
22.216 AC.
-020
19.06 Ac
21.294 AC.
-021
14.538 AC.
-018
24.69 Ac
-017
56.86 Ac
-016
16.34 Ac
-005
0.986 AC.
JOY E. SOUSLIN ET AL
WOODS
39.93 AC.
(24.59 AC. ± O.L.1
15.34 AC. ± O.L.6)
STRAN-MAAG DITCH
ORIGINAL LOT No 1
ORIGINAL LOT No 6
20' SAN. SWR. ESMT.
60' SAN. SWR. ESMT.
BENCH MARK MONUMENT ELEV.-781.05
BENCH MARK MONUMENT ELEV.-784.42
U.S.G.S. SURVEY MONUMENT "GRAFTON 1935"
60" OAK
N-89°32'33"-E
N-89°36'55"-E
S-89°51'04"-E
N-89°37'37"-W
S-89°37'37"-E
N-0°22'23"-E
S-0°22'23"-E
S-62°28'33"-W 500.00
N-62°28'33"-E 500.00
1552.80'
1458.93'
800.45'
741.93' TO DITCH ℄
642.24'
717.00'
900.00'
1753.29'
642.20'
211.09'
870.68'
1624.25'
1660.03'
1185.05'
1088.01'
1092.21' TO DITCH ℄
1399.96'
513.25'
662.93'
238.21'
208'
1317.85'
1418.16'
1704.10'
1704.10'
1704.10