6-128

06-24-001-000-

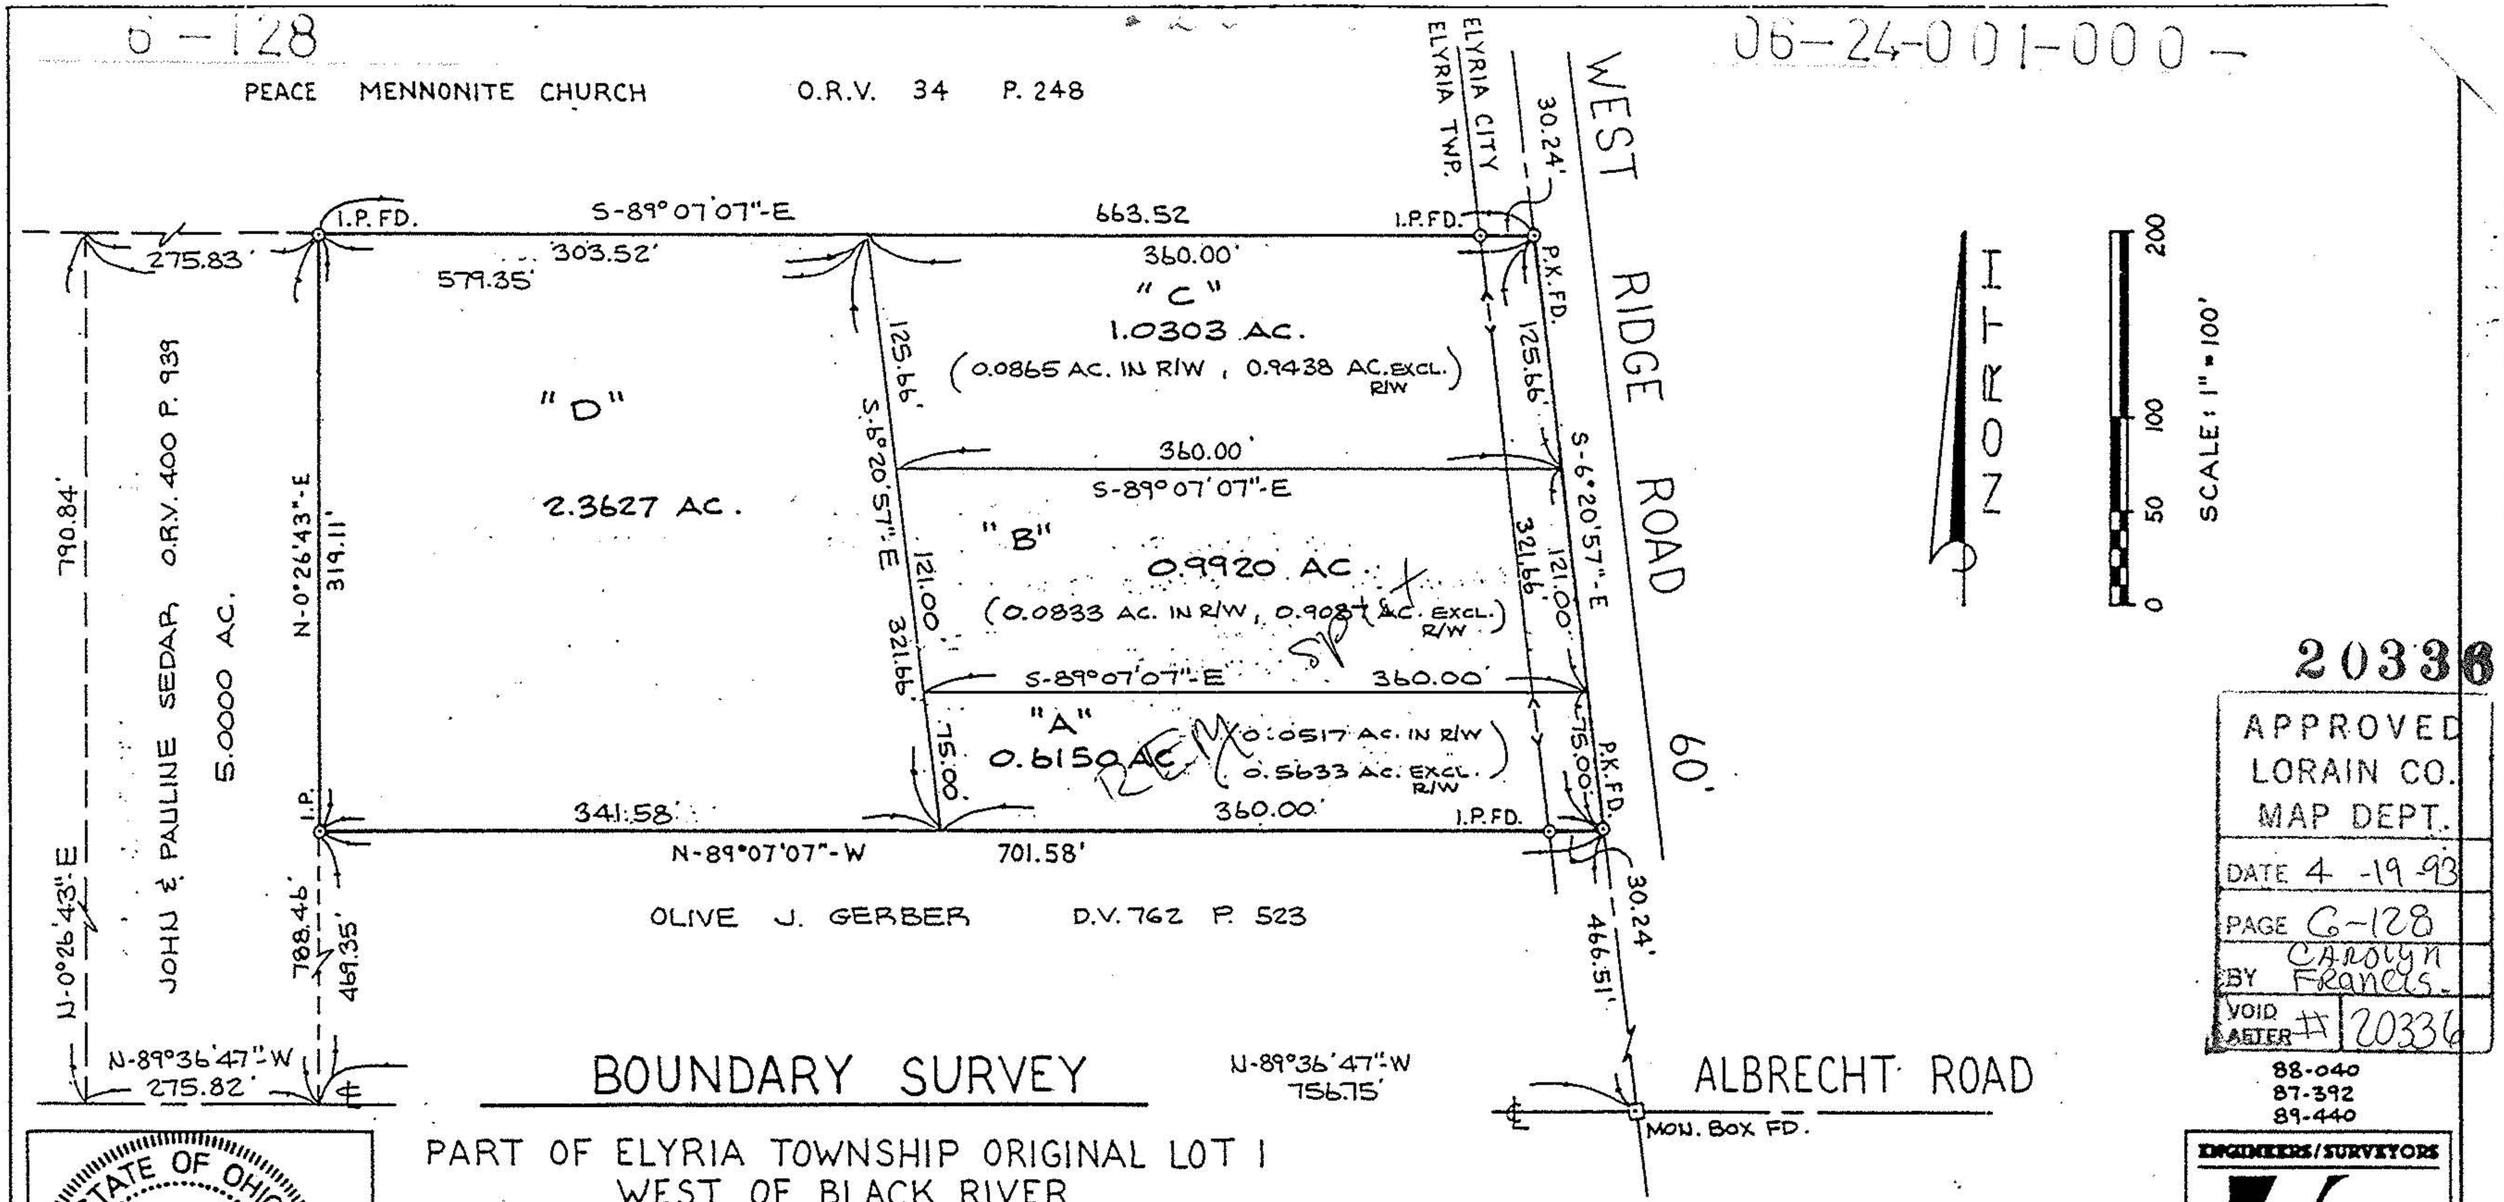

20336

APPROVED
LORAIN CO.
MAP DEPT.
DATE 4-19-93
PAGE 6-128
BY Carolyn Francis
VOID AFTER # 20336

88-040
87-392
89-440

BOUNDARY SURVEY

PART OF ELYRIA TOWNSHIP ORIGINAL LOT 1
WEST OF BLACK RIVER
CITY & TOWNSHIP OF ELYRIA
COUNTY OF LORAIN
STATE OF OHIO

STATE OF OHIO
DAVID L. ELWELL
6333
REGISTERED
SURVEYOR

5-24-91
7-31-91
12-31-91
3-23-92
1-29-93

David L. Elwell

DAVID L. ELWELL REG. SURV. NO. 6333

ENGINEERS/SURVEYORS
KS
ASSOCIATES
INCORPORATED

91-241