

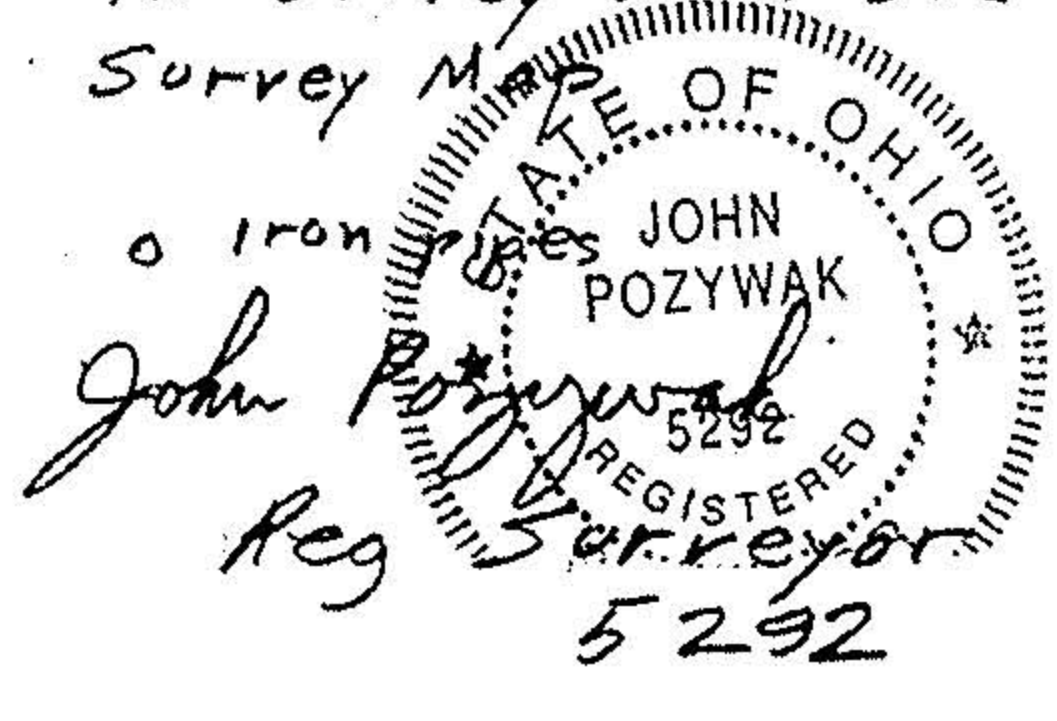




For survey data see
Survey Map

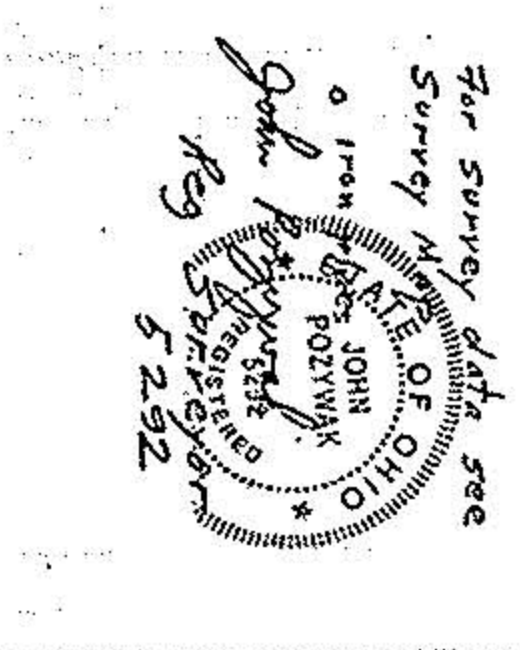


Building Locations on the
Gerald Burrel property
Original Elyria Township Lot 3
West of Black River
City of Elyria
Lorain County Ohio
Scale 1"=60' Nov 7, 1998

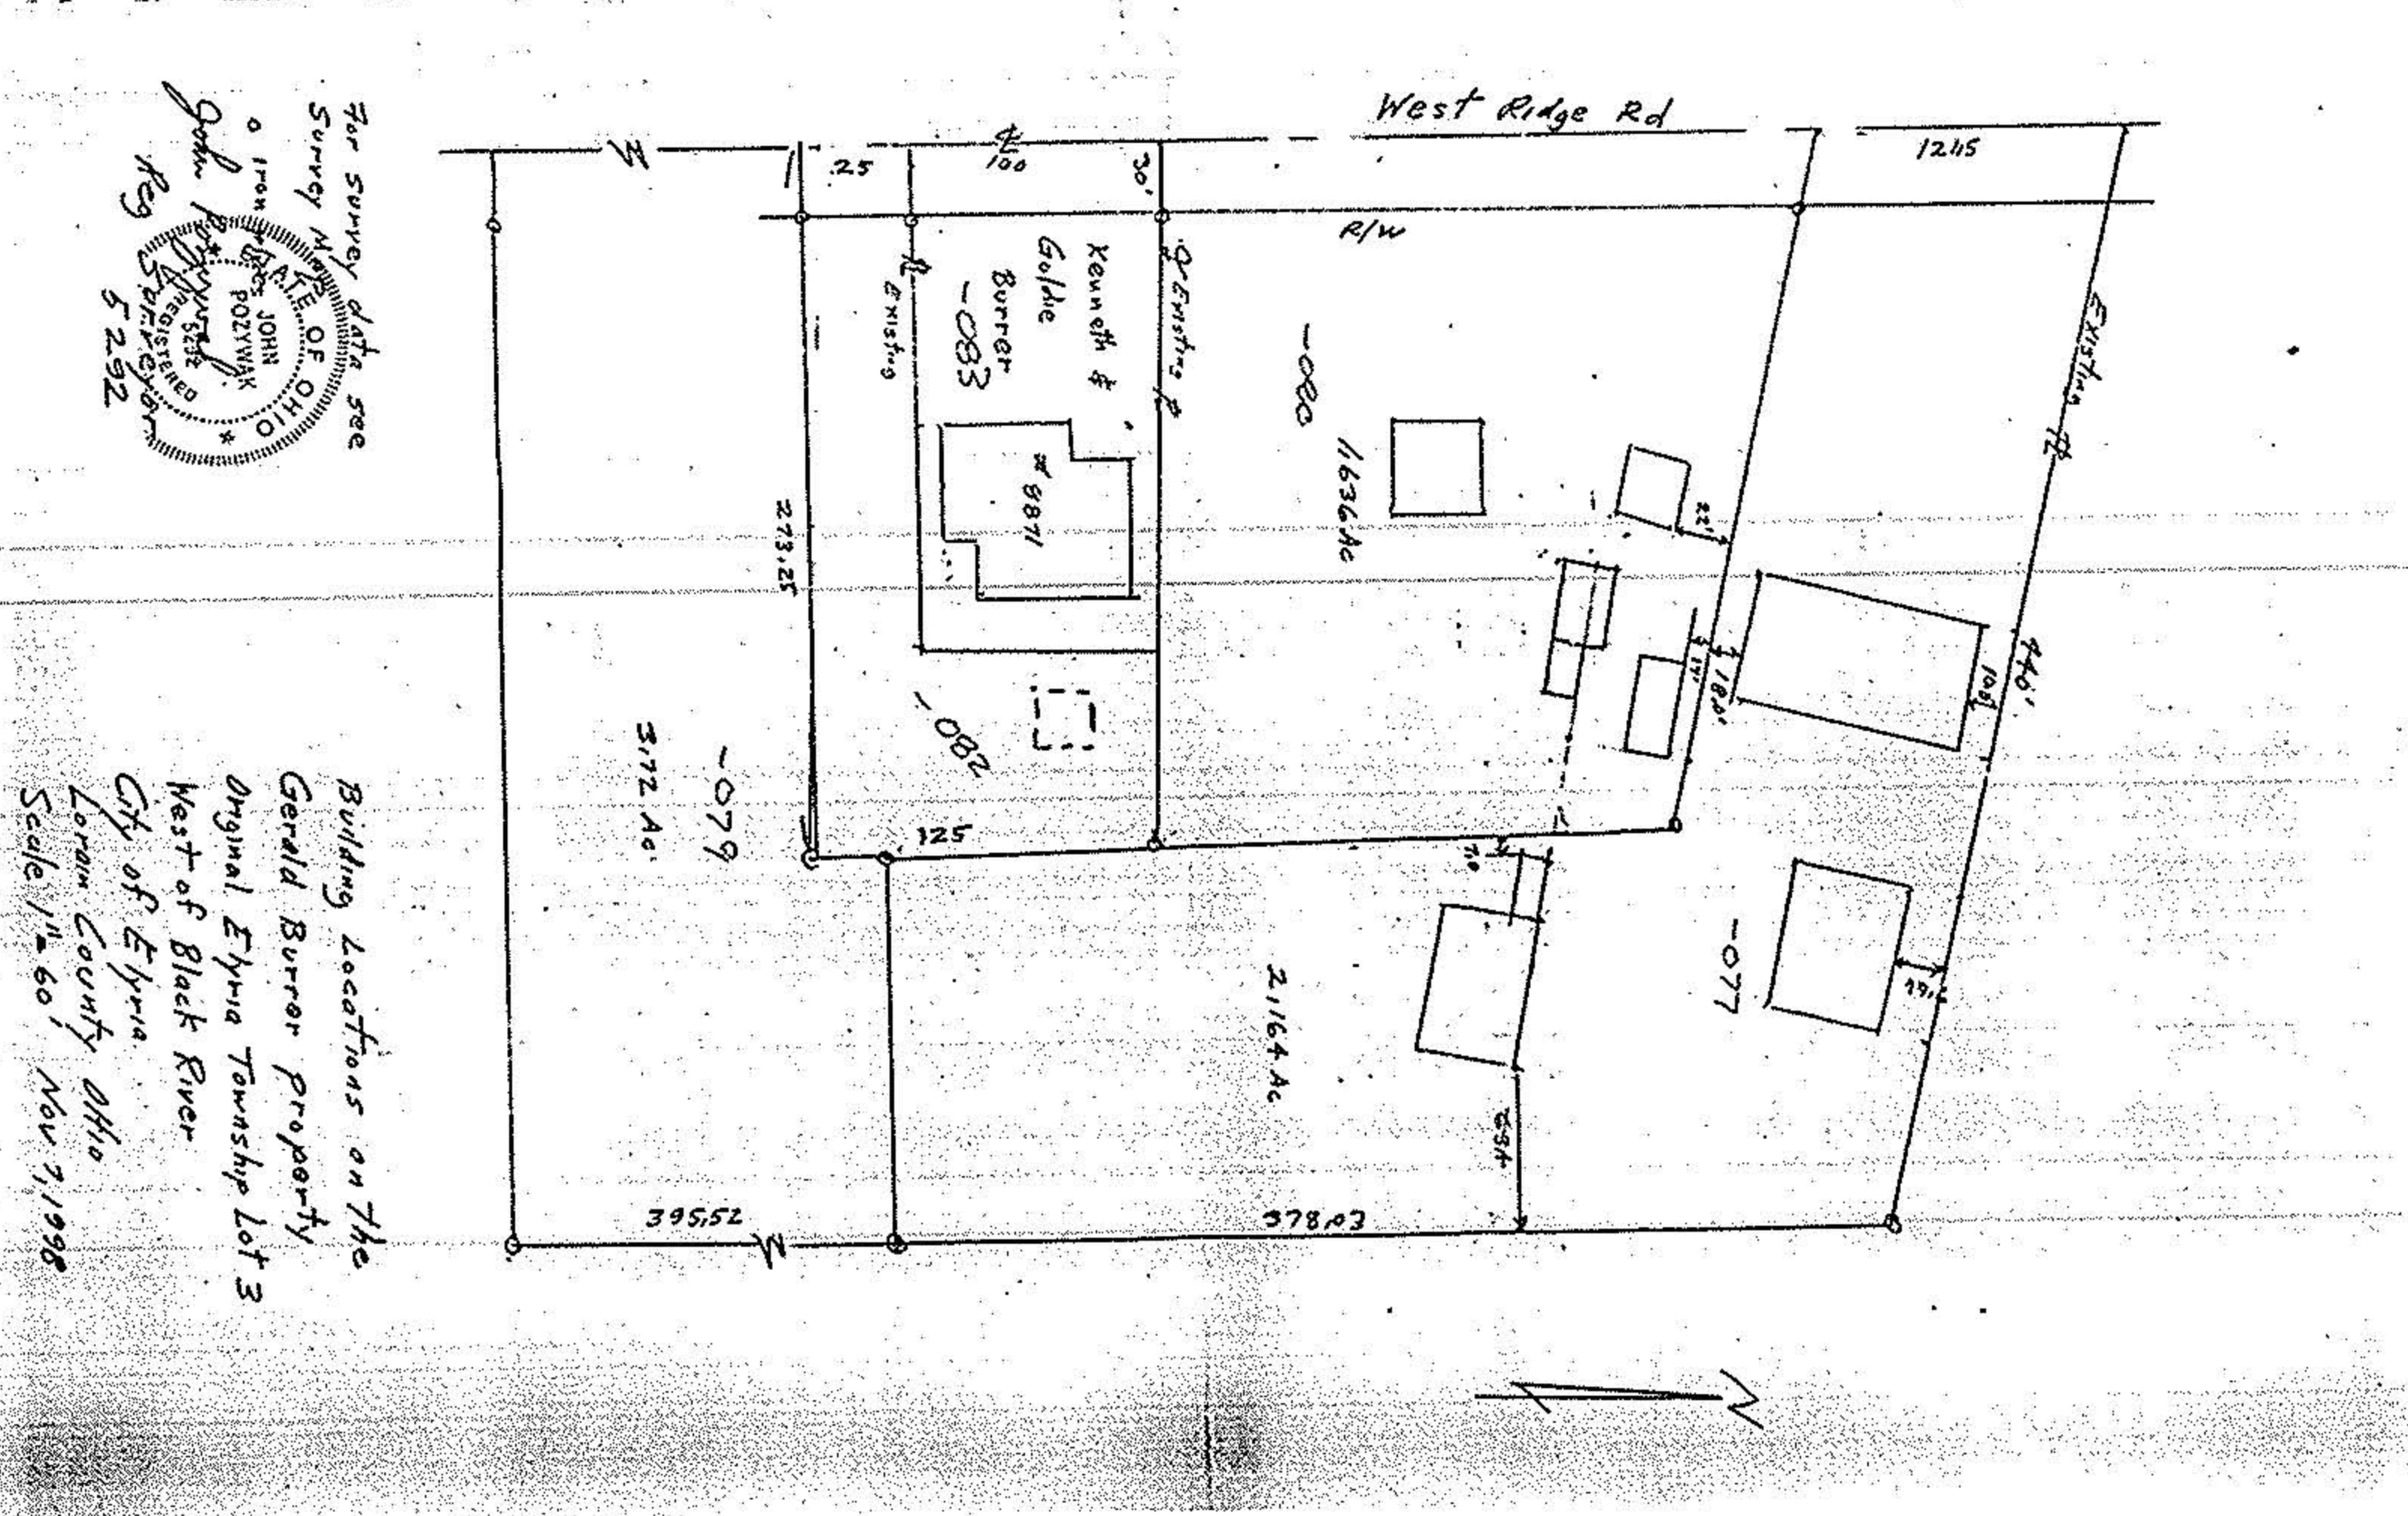

Building Locations on the
Gerald Burrel property
Original Elyria Township Lot 3
West of Black River
City of Elyria
Lorain County Ohio
Scale 1"=60' Nov 7, 1998

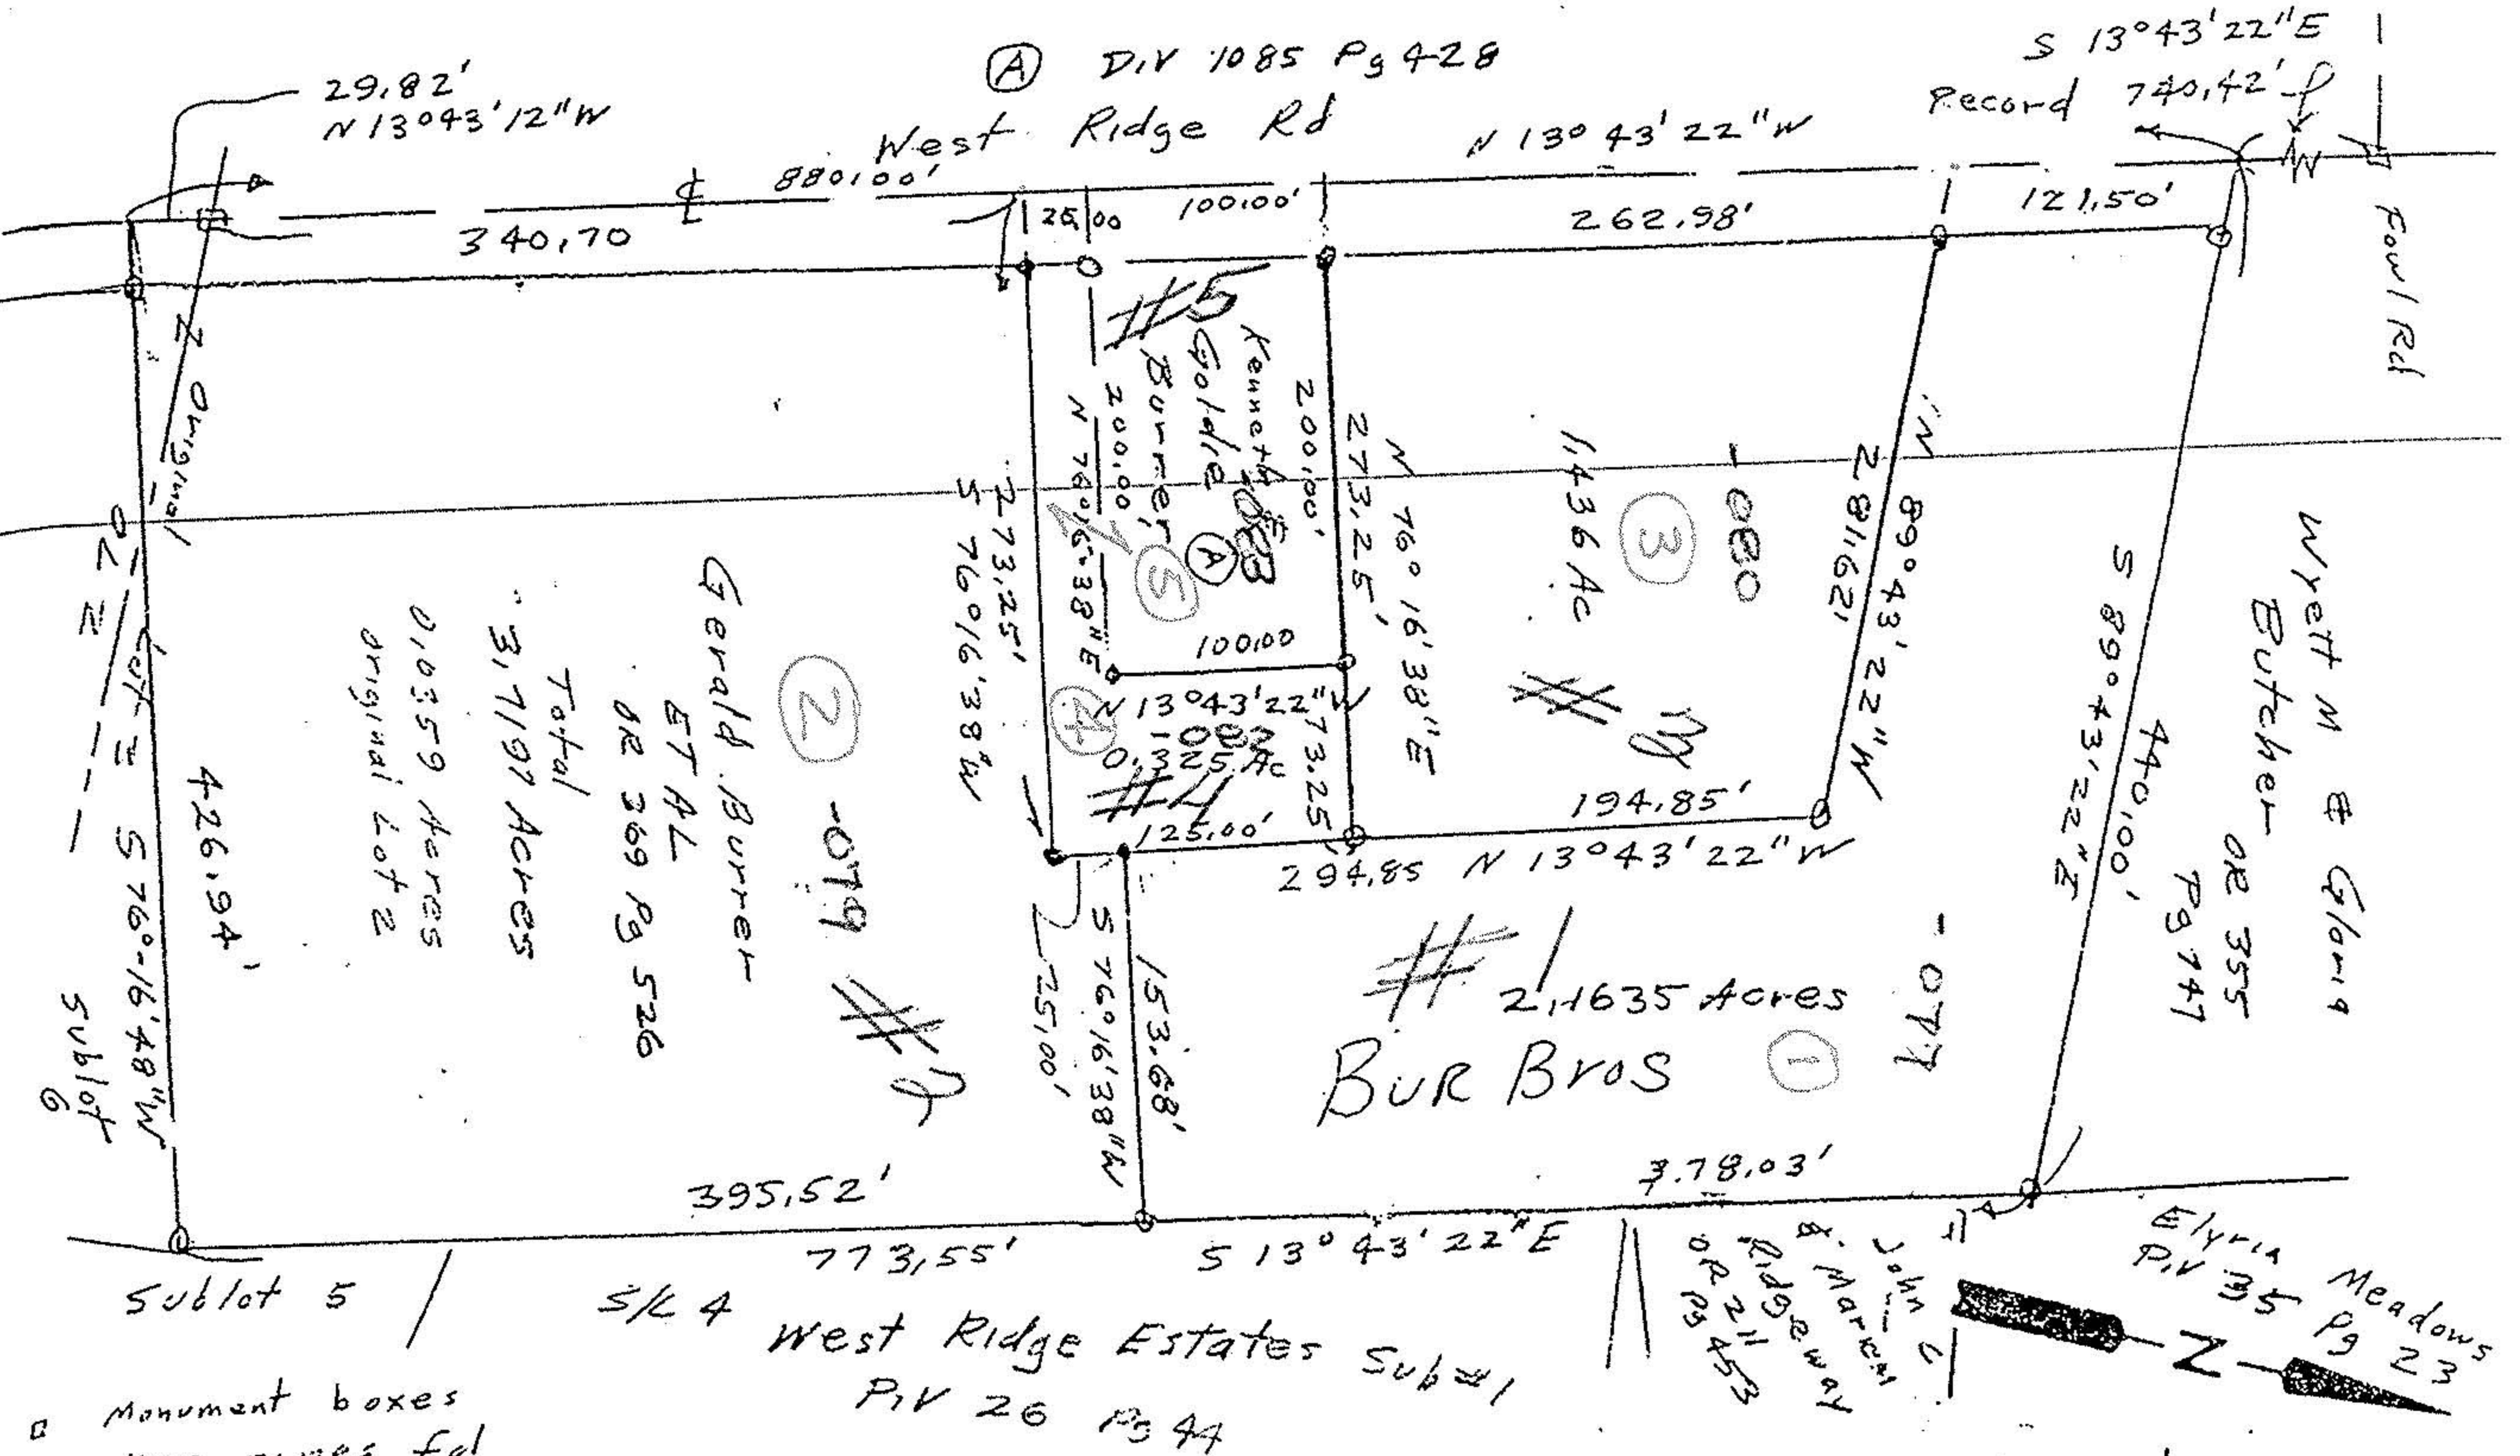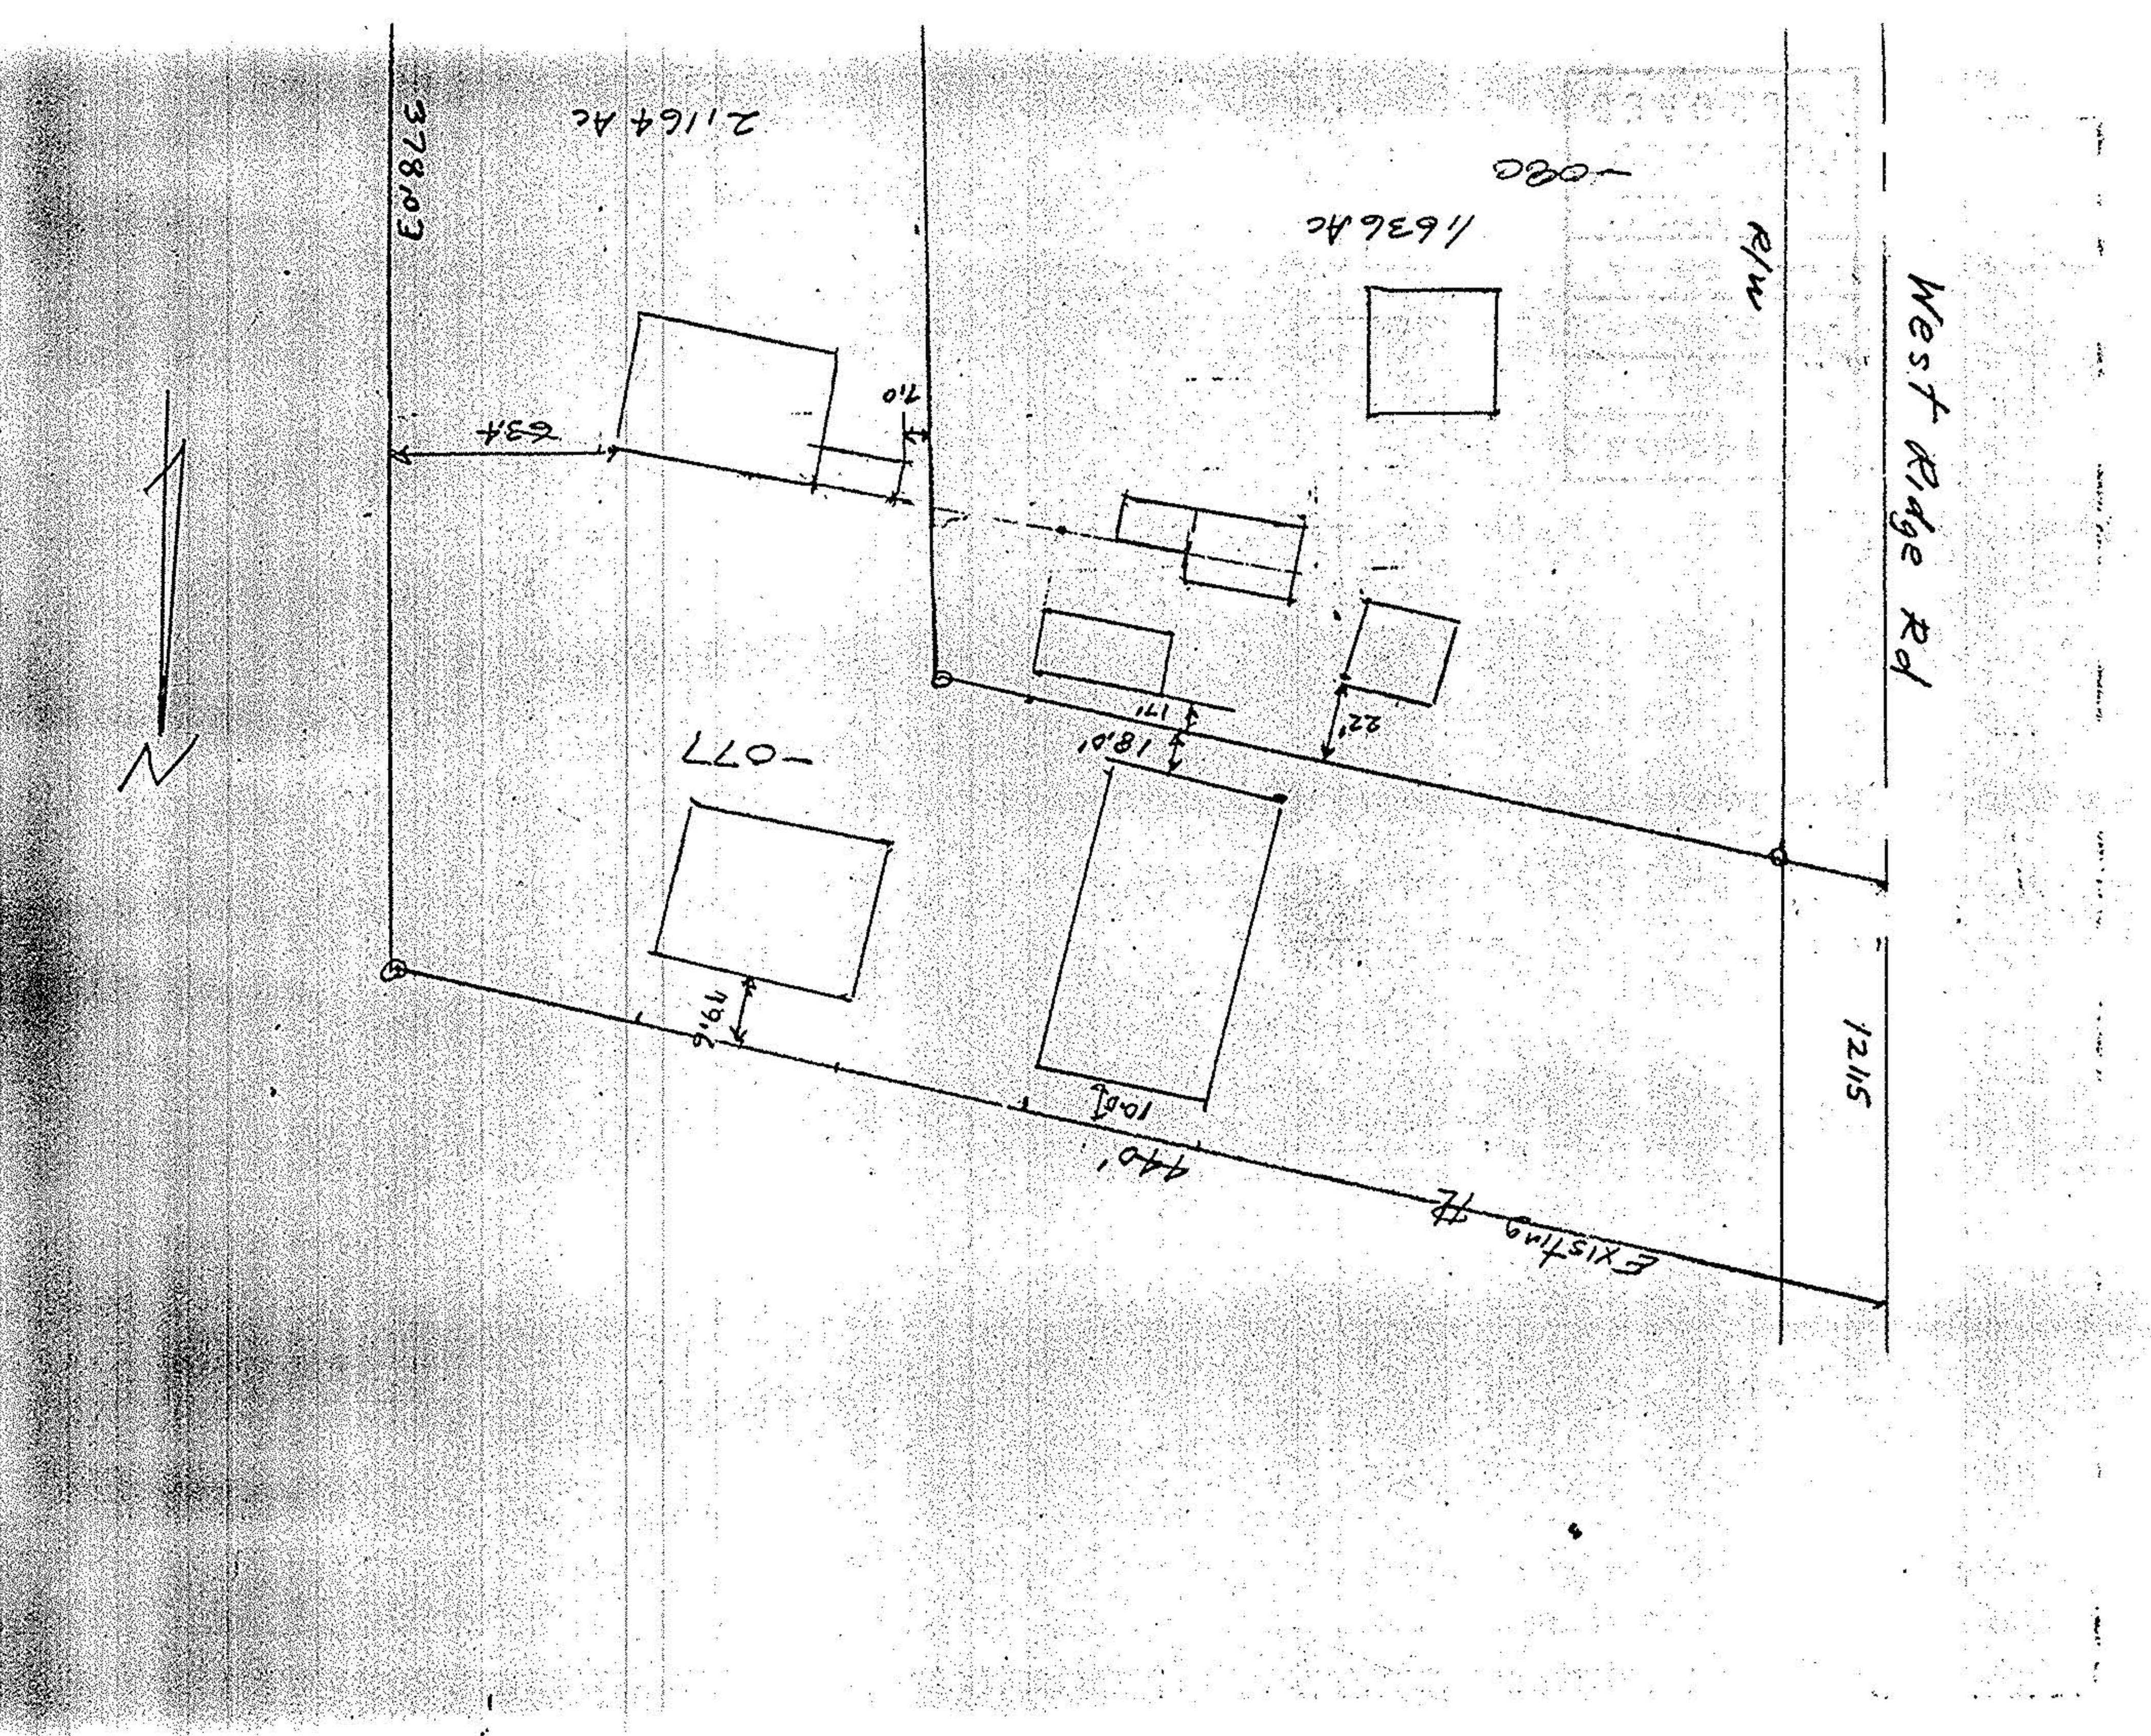

Monument boxes
Iron pipes for
Iron pipes set
Bearings from
recorded Plat
John Pozywak

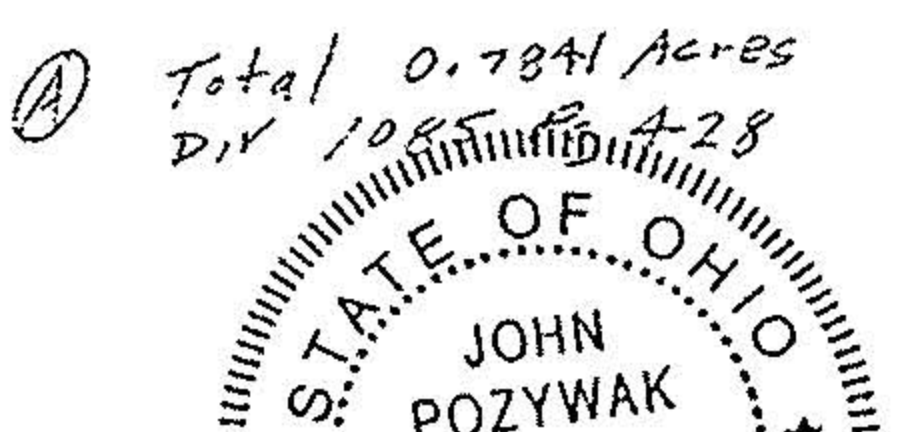

Survey of Parcel Splits
Original Elyria Township Lot 3
West of Black River
City of Elyria
Ohio