

6-109

KS ASSOCIATES, INC.

424 Middle Ave. P.O. Box 89
ELYRIA, OHIO 44036
(216) 322-6317

JOB 21256

SHEET NO. _____ OF _____


CALCULATED BY _____ DATE 8-3-87

CHECKED BY _____ DATE _____

SCALE 1" = 40'

REV. 8-18-87

06-24-003-102-054

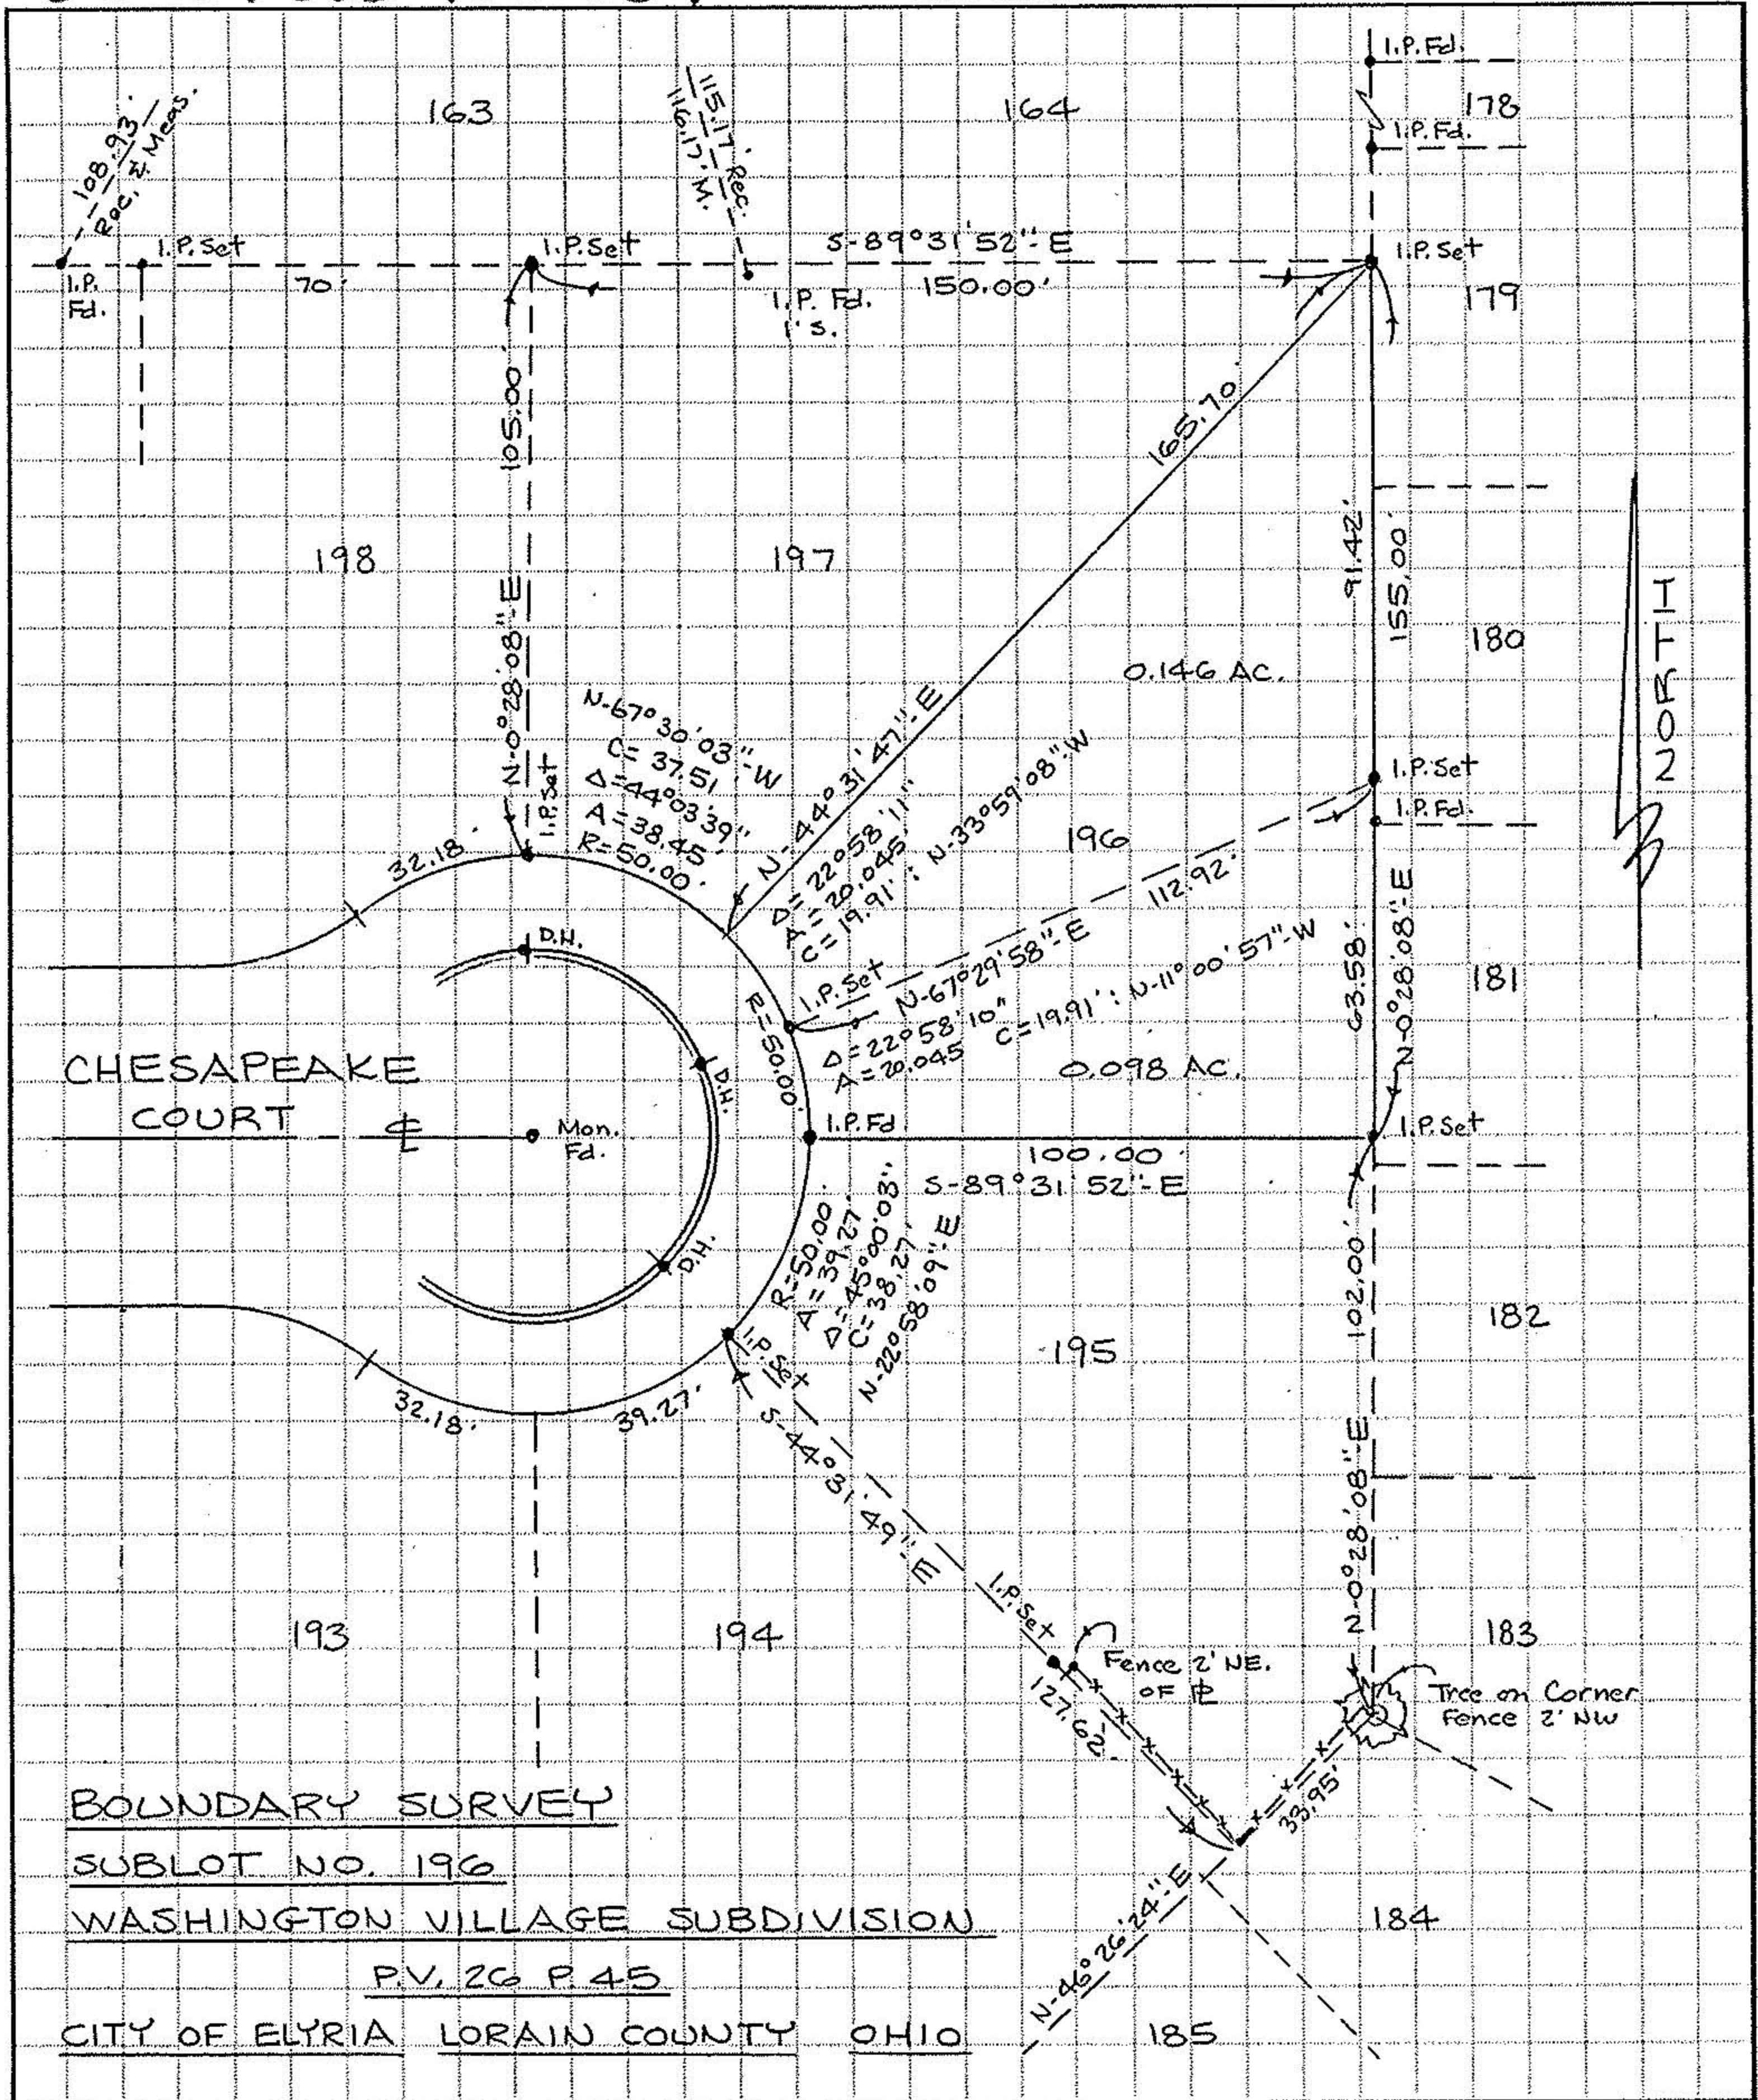

BOUNDARY SURVEY

SUBLOT NO. 196

WASHINGTON VILLAGE SUBDIVISION

P.V. 26 P. 45

CITY OF ELYRIA LORAIN COUNTY OHIO