6-135 #16335 06-24-007-104-

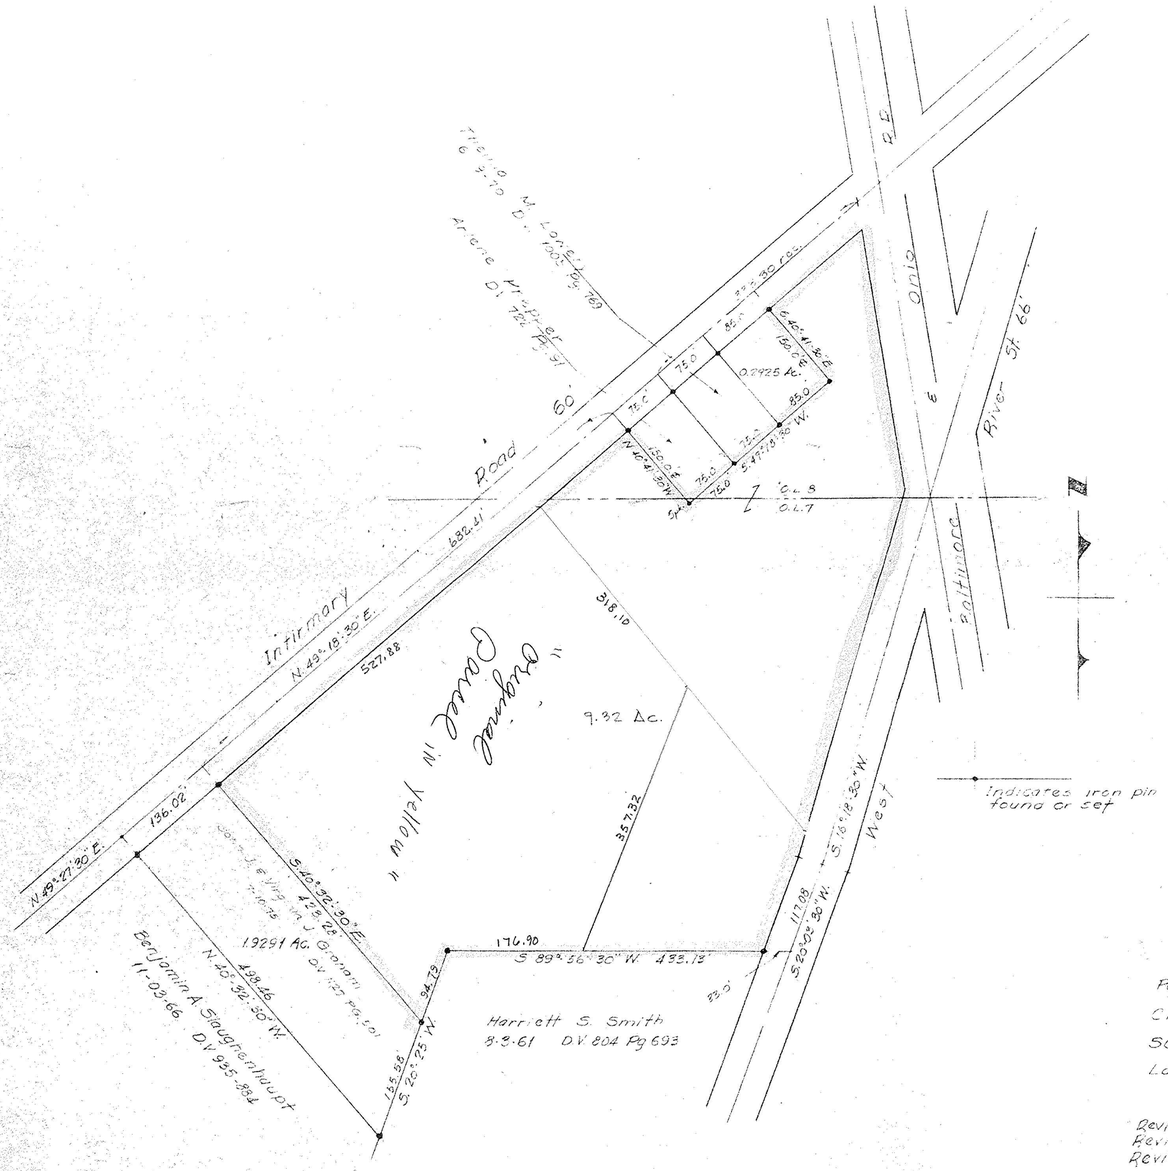

RECEIVED
SEP 05 85
BUILDING DEPARTMENT
ELYRIA, OHIO
Per

#16335

APPROVED
LORAIN CO.
MAP DEPT.
DATE 9-16-85
PAGE 6-135
BY C. FRANCIS
VOID AFTER

Survey for Fred Wallread et al
Part of O.L.'s 7 & 8 W. of River Elyria Twnp.
City of Elyria Lorain County, Ohio
Scale 1"=100' October, 1972
Lourdot · Simon · Conl & Assoc.
Engineers & Surveyors

Revised 9-5-85 Deletions
Revised 1-14-82 Job No 82-1078
Revised 6-30-76 " " 76-506 Job No 72-31 FB. 180 Pg. 7

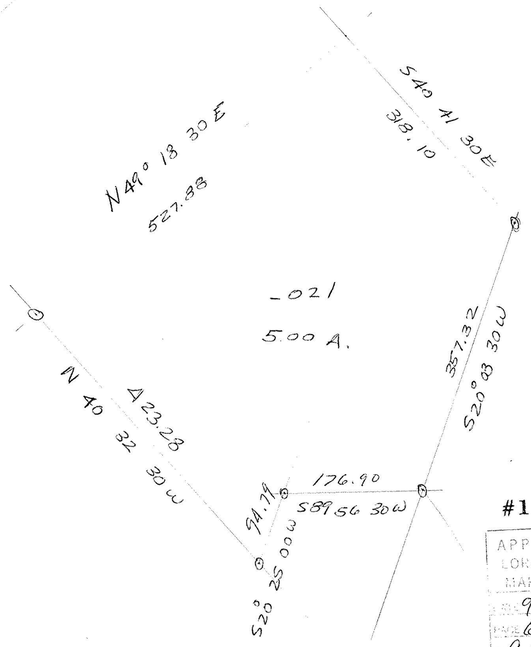

#16335

APPROVED
LORAIN CO.
MAP DEPT.
DATE 9-16-85
PAGE 6-135
BY C. FRANCIS

06-24-007-104-021