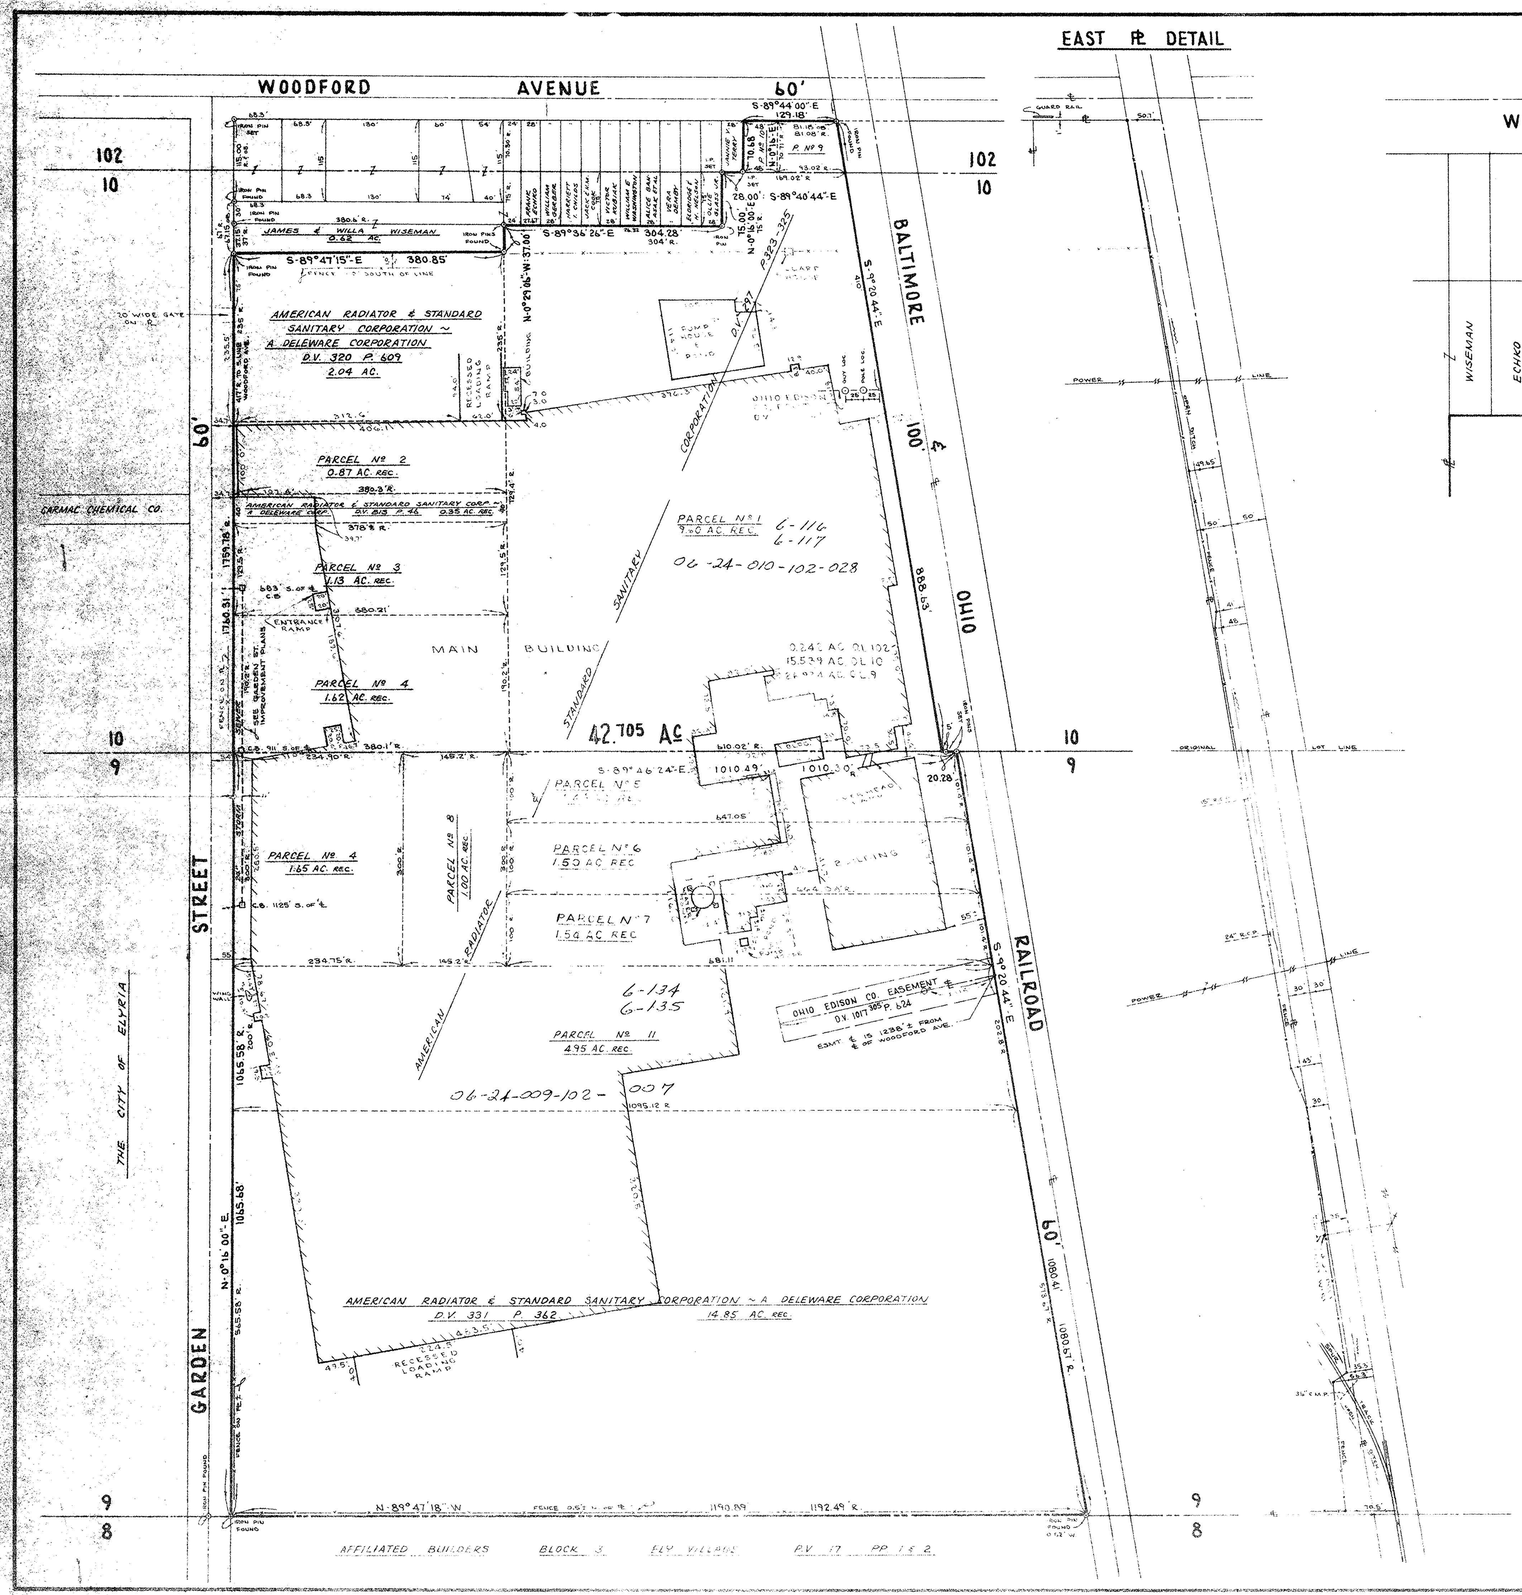

EAST R/R DETAIL

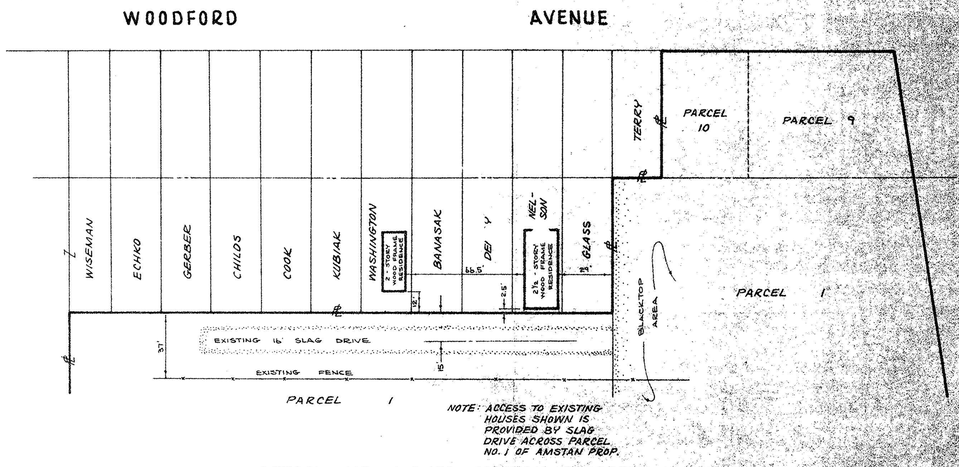

NOTE: ACCESS TO EXISTING HOUSES SHOWN IS PROVIDED BY SLAG DRIVE ACROSS PARCEL NO. 1 OF AMSTAN PROP.

DETAIL NE. CORNER AMSTAN PROPERTY

SCALE: 1" = 40'

THIS IS TO CERTIFY THAT THIS SURVEY WAS MADE FOR AND AT THE INSTANCE OF THE TAPPAN COMPANY, AMERICAN STANDARD INC., AND LAWYERS TITLE INSURANCE CORPORATION

James H. Schmidt
REGISTERED SURVEYOR Nº 4846

SURVEY OF

AMERICAN STANDARD INC. PROPERTY

PART OF ORIGINAL ELYRIA TOWNSHIP LOTS NOS. 9, 10 AND 102, WEST OF THE BLACK RIVER IN THE CITY OF ELYRIA, COUNTY OF LORAIN, AND STATE OF OHIO

PREPARED FOR

SCALE: 1" = 100'

THE TAPPAN COMPANY
MANSFIELD OHIO

JANUARY 21, 1972
REVISED: FEB. 1, 1972

PREPARED BY

JAMES H. SCHMIDT
REGISTERED SURVEYOR
ELYRIA OHIO

72-15

9