



BRUCE M. & FREDERICK G. EPPLEY

PARTS OF ORIGINAL LOTS 19 & 20, WEST OF ZIVVER, ELYRIA TWP.,
LORAIN COUNTY
STATE OF OHIO
SCALE: 1" = 120'
MAY 1985
LAIRDON, SIMON, CAHL & ASSOC. • ENGINEERS • SURVEYORS


REVISED 8-20-98 CALC. 9.7610 AC. PCL.

JOB NO. 82-1240


189



DETAIL
NO SCALE

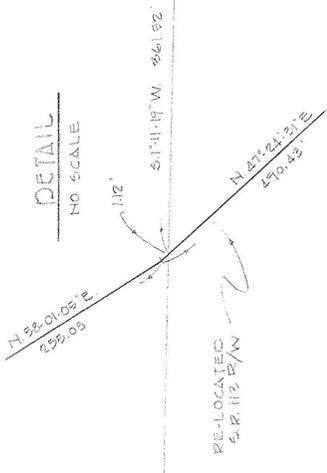

SCALE
1" = 120'

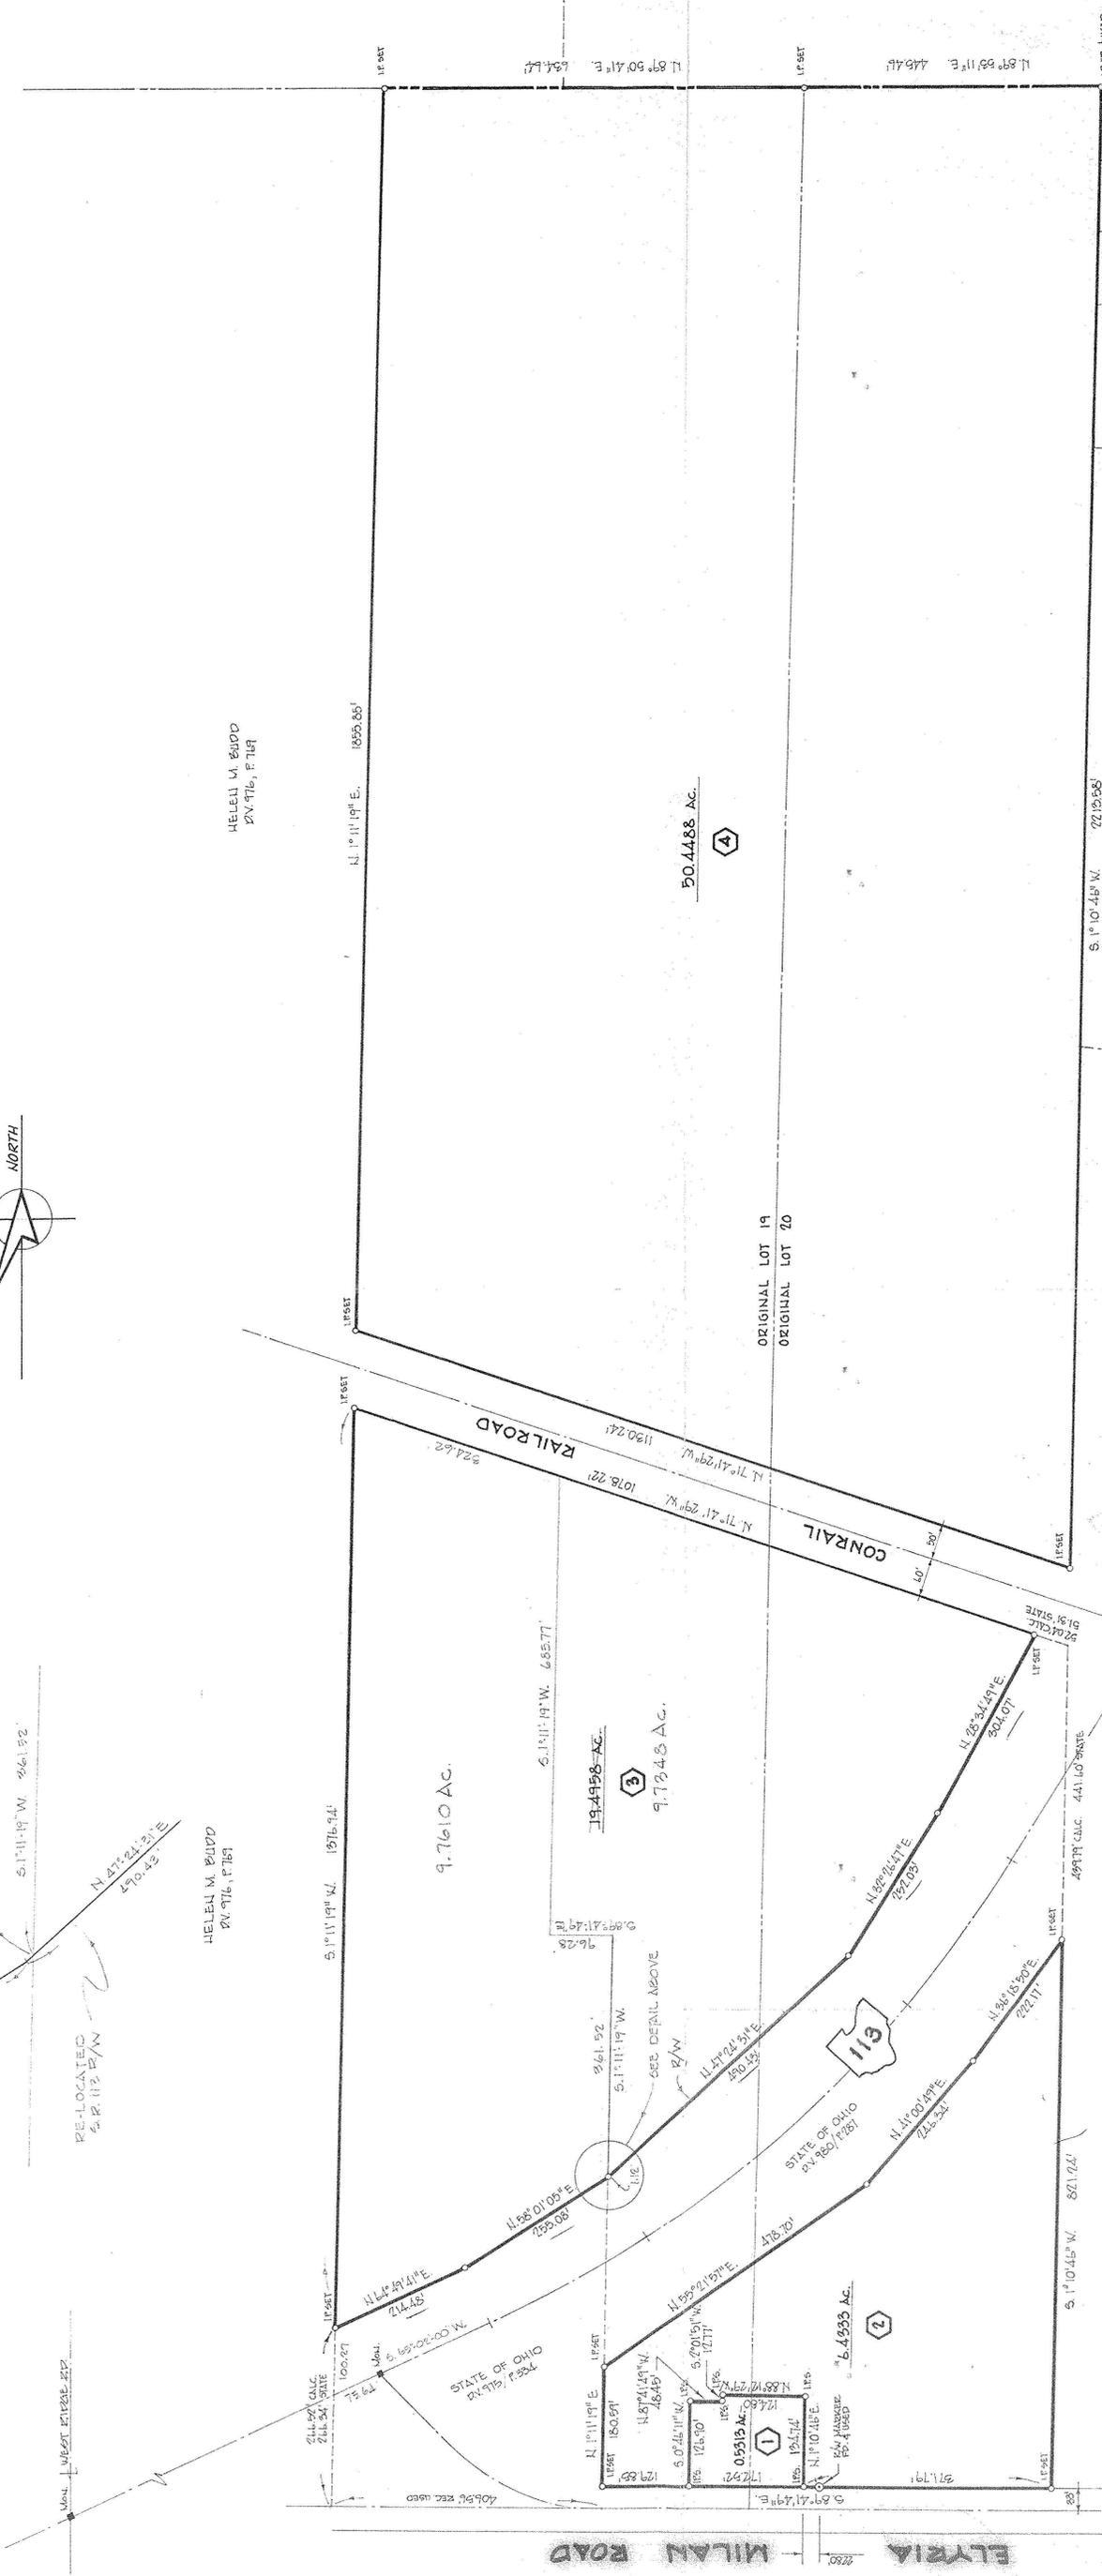

JOHN KEFFER
9/7/76
BY 1137, P. 216

MILTON L. EPPLEY
BY 1169, P. 463

KAYMOND A. & HANCOCK K.
WYNKELT
BY 1178 BY 1206, P. 137

ROBERTA V. MAIDELL
12/16/76
BY 1224, P. 16

TELECOR, LLC
2/17/89
BY 960, P. 140

TELECOR, LLC
10/5/87
BY 915, P. 557

#22475-D
APPROVED
LORAIN CO.
MAP DEPT.
DATE 9-4-98
PAGE 6-74 & 6-92
BY T. Monahan
VOID AFTER 22475-D

T.H. B. 6-74 & 6-92