


OHIO

TU

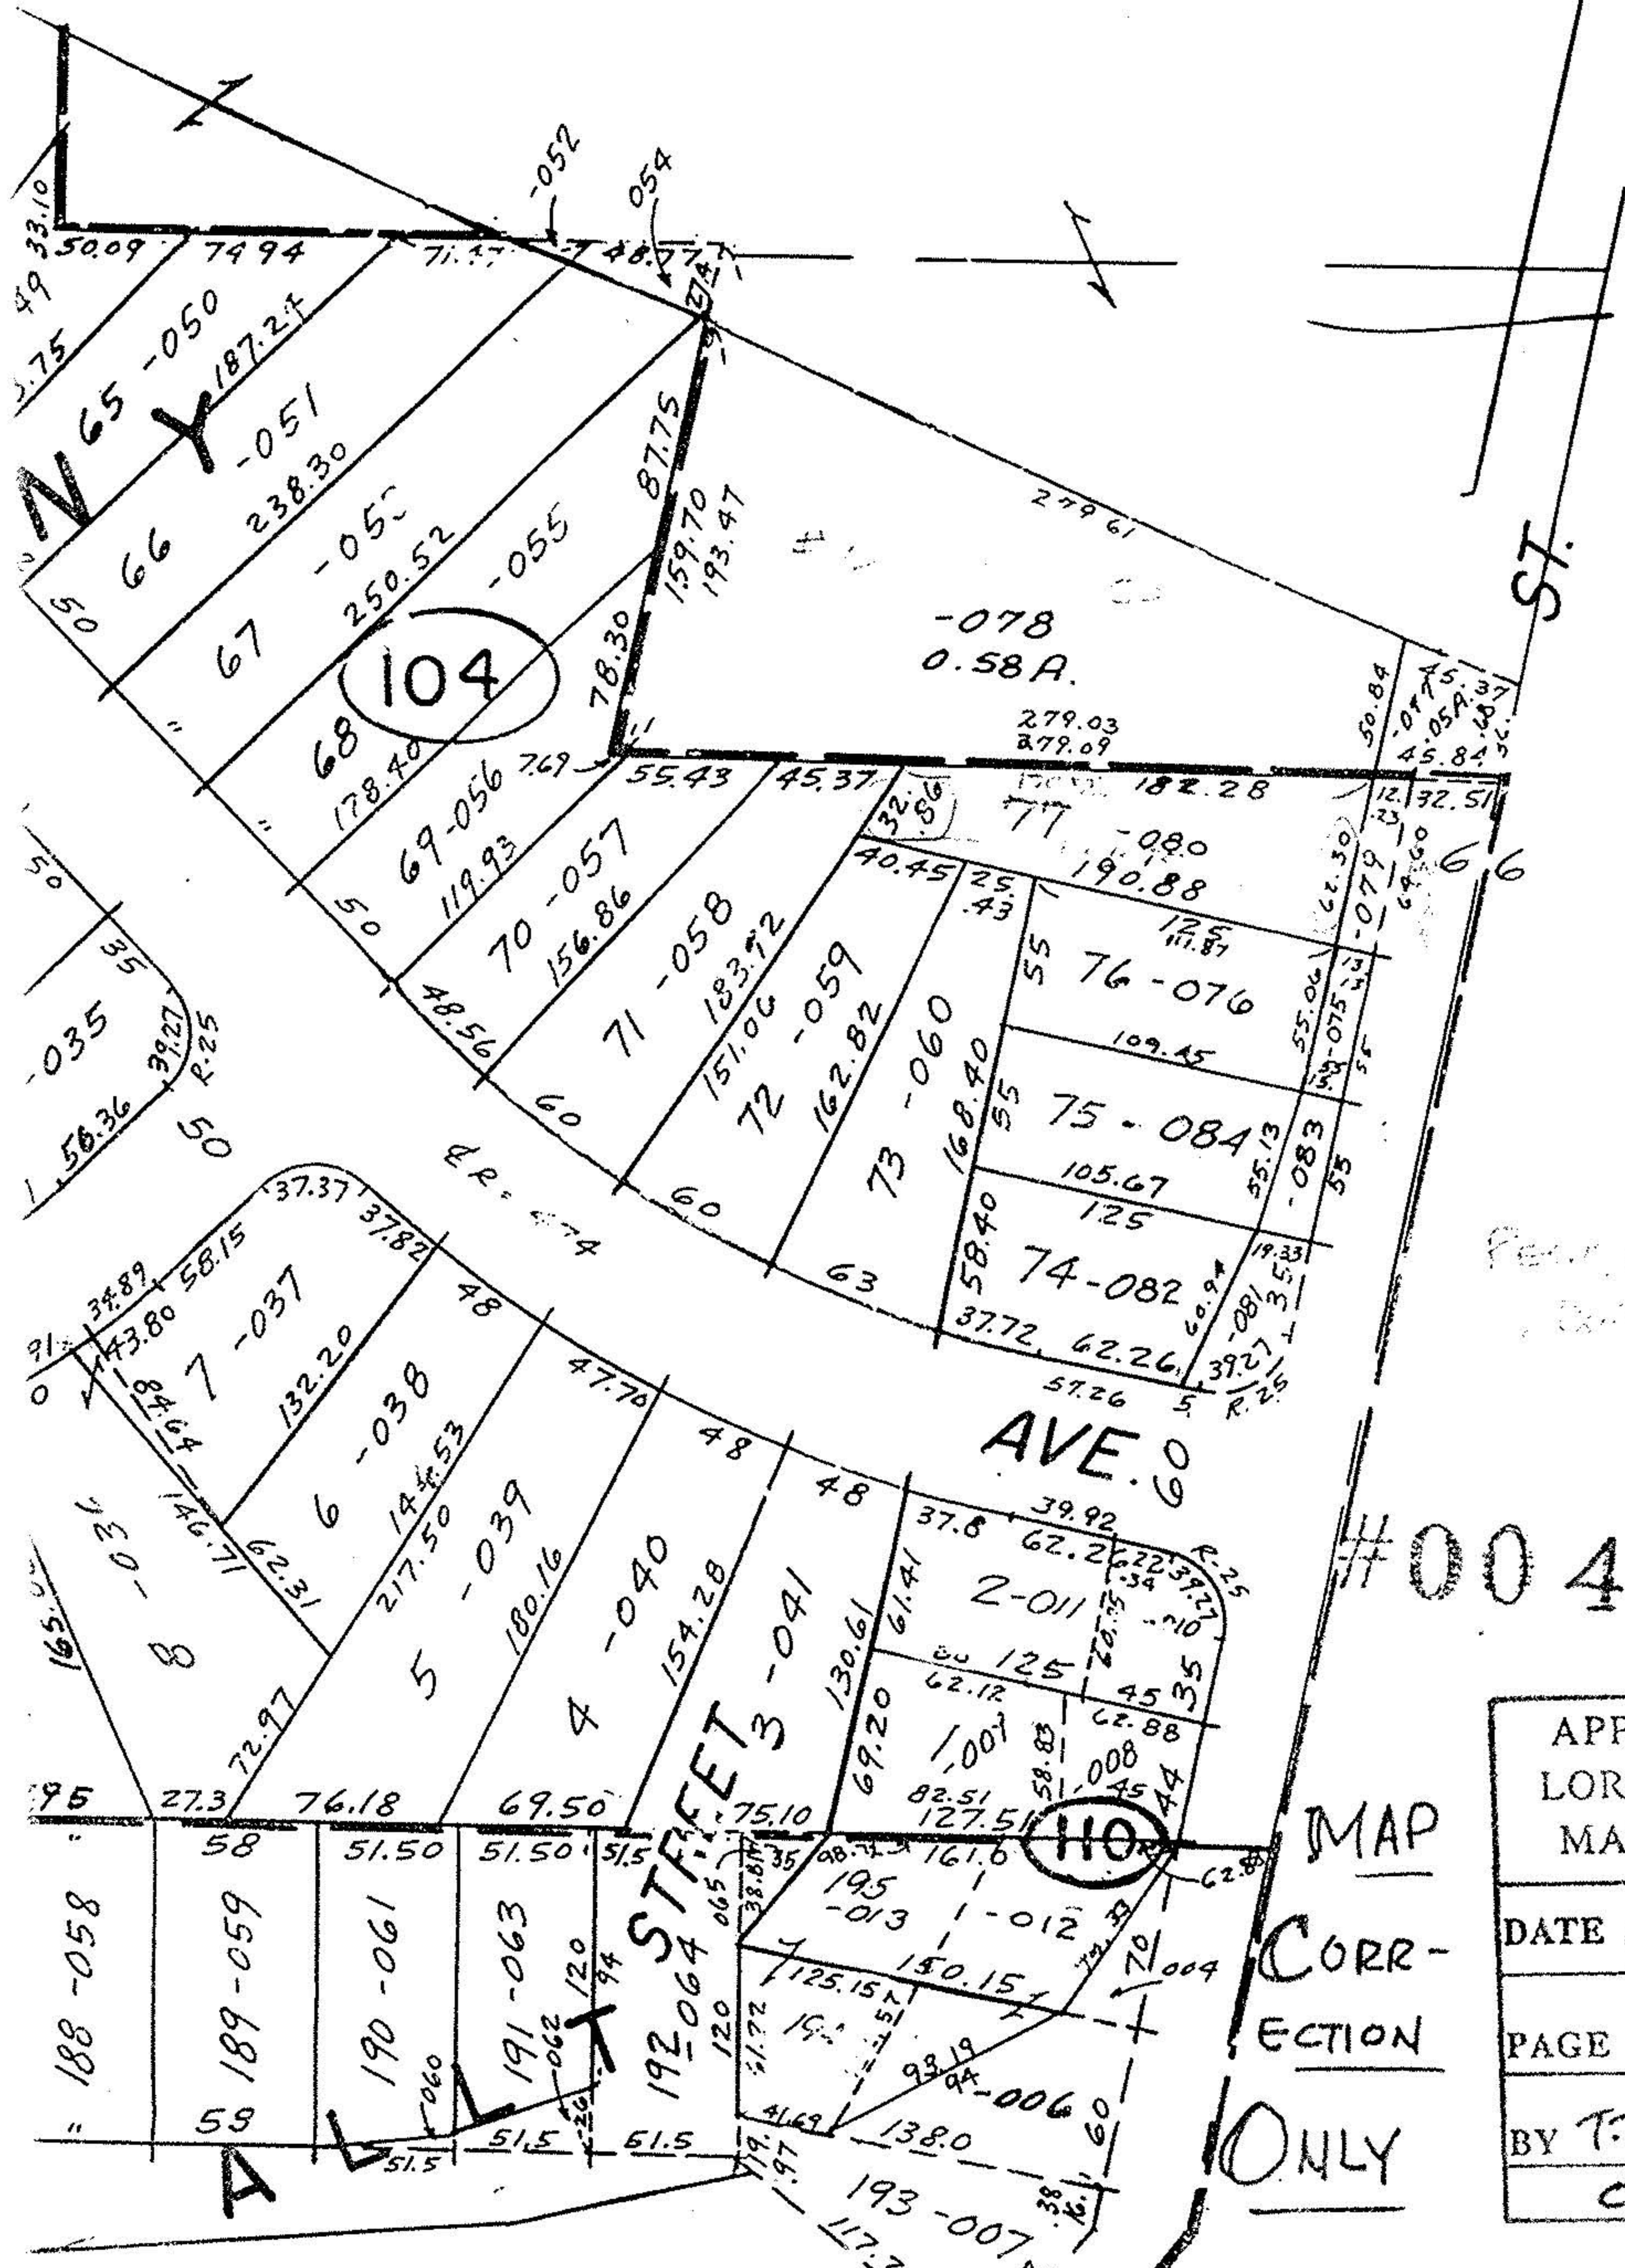

06-24-028-104-080

RECORDED
EXHIBIT

#00451-0

MAP
CORR-
ECTION
ONLY

APPROVED LORAIN CO. MAP DEPT
DATE 10.6.00
PAGE 6-83
BY T. McMain
06451-0