MAP OF SURVEY AND LOT SPLIT

PREPARED FOR

RUSSELL STANISLAWSKI SR.

AND

DAVID R. AND MARY JO MCKISIC

AND

MARIAN BILTZ, ETAL.

SITUATED IN THE TOWNSHIP OF ELYRIA, COUNTY OF LORAIN, STATE OF OHIO AND BEING KNOWN AS PART OF ORGINAL ELYRIA TOWNSHIP LOTS 21,22,24,43 AND 48 WEST OF BLACK RIVER TRACT

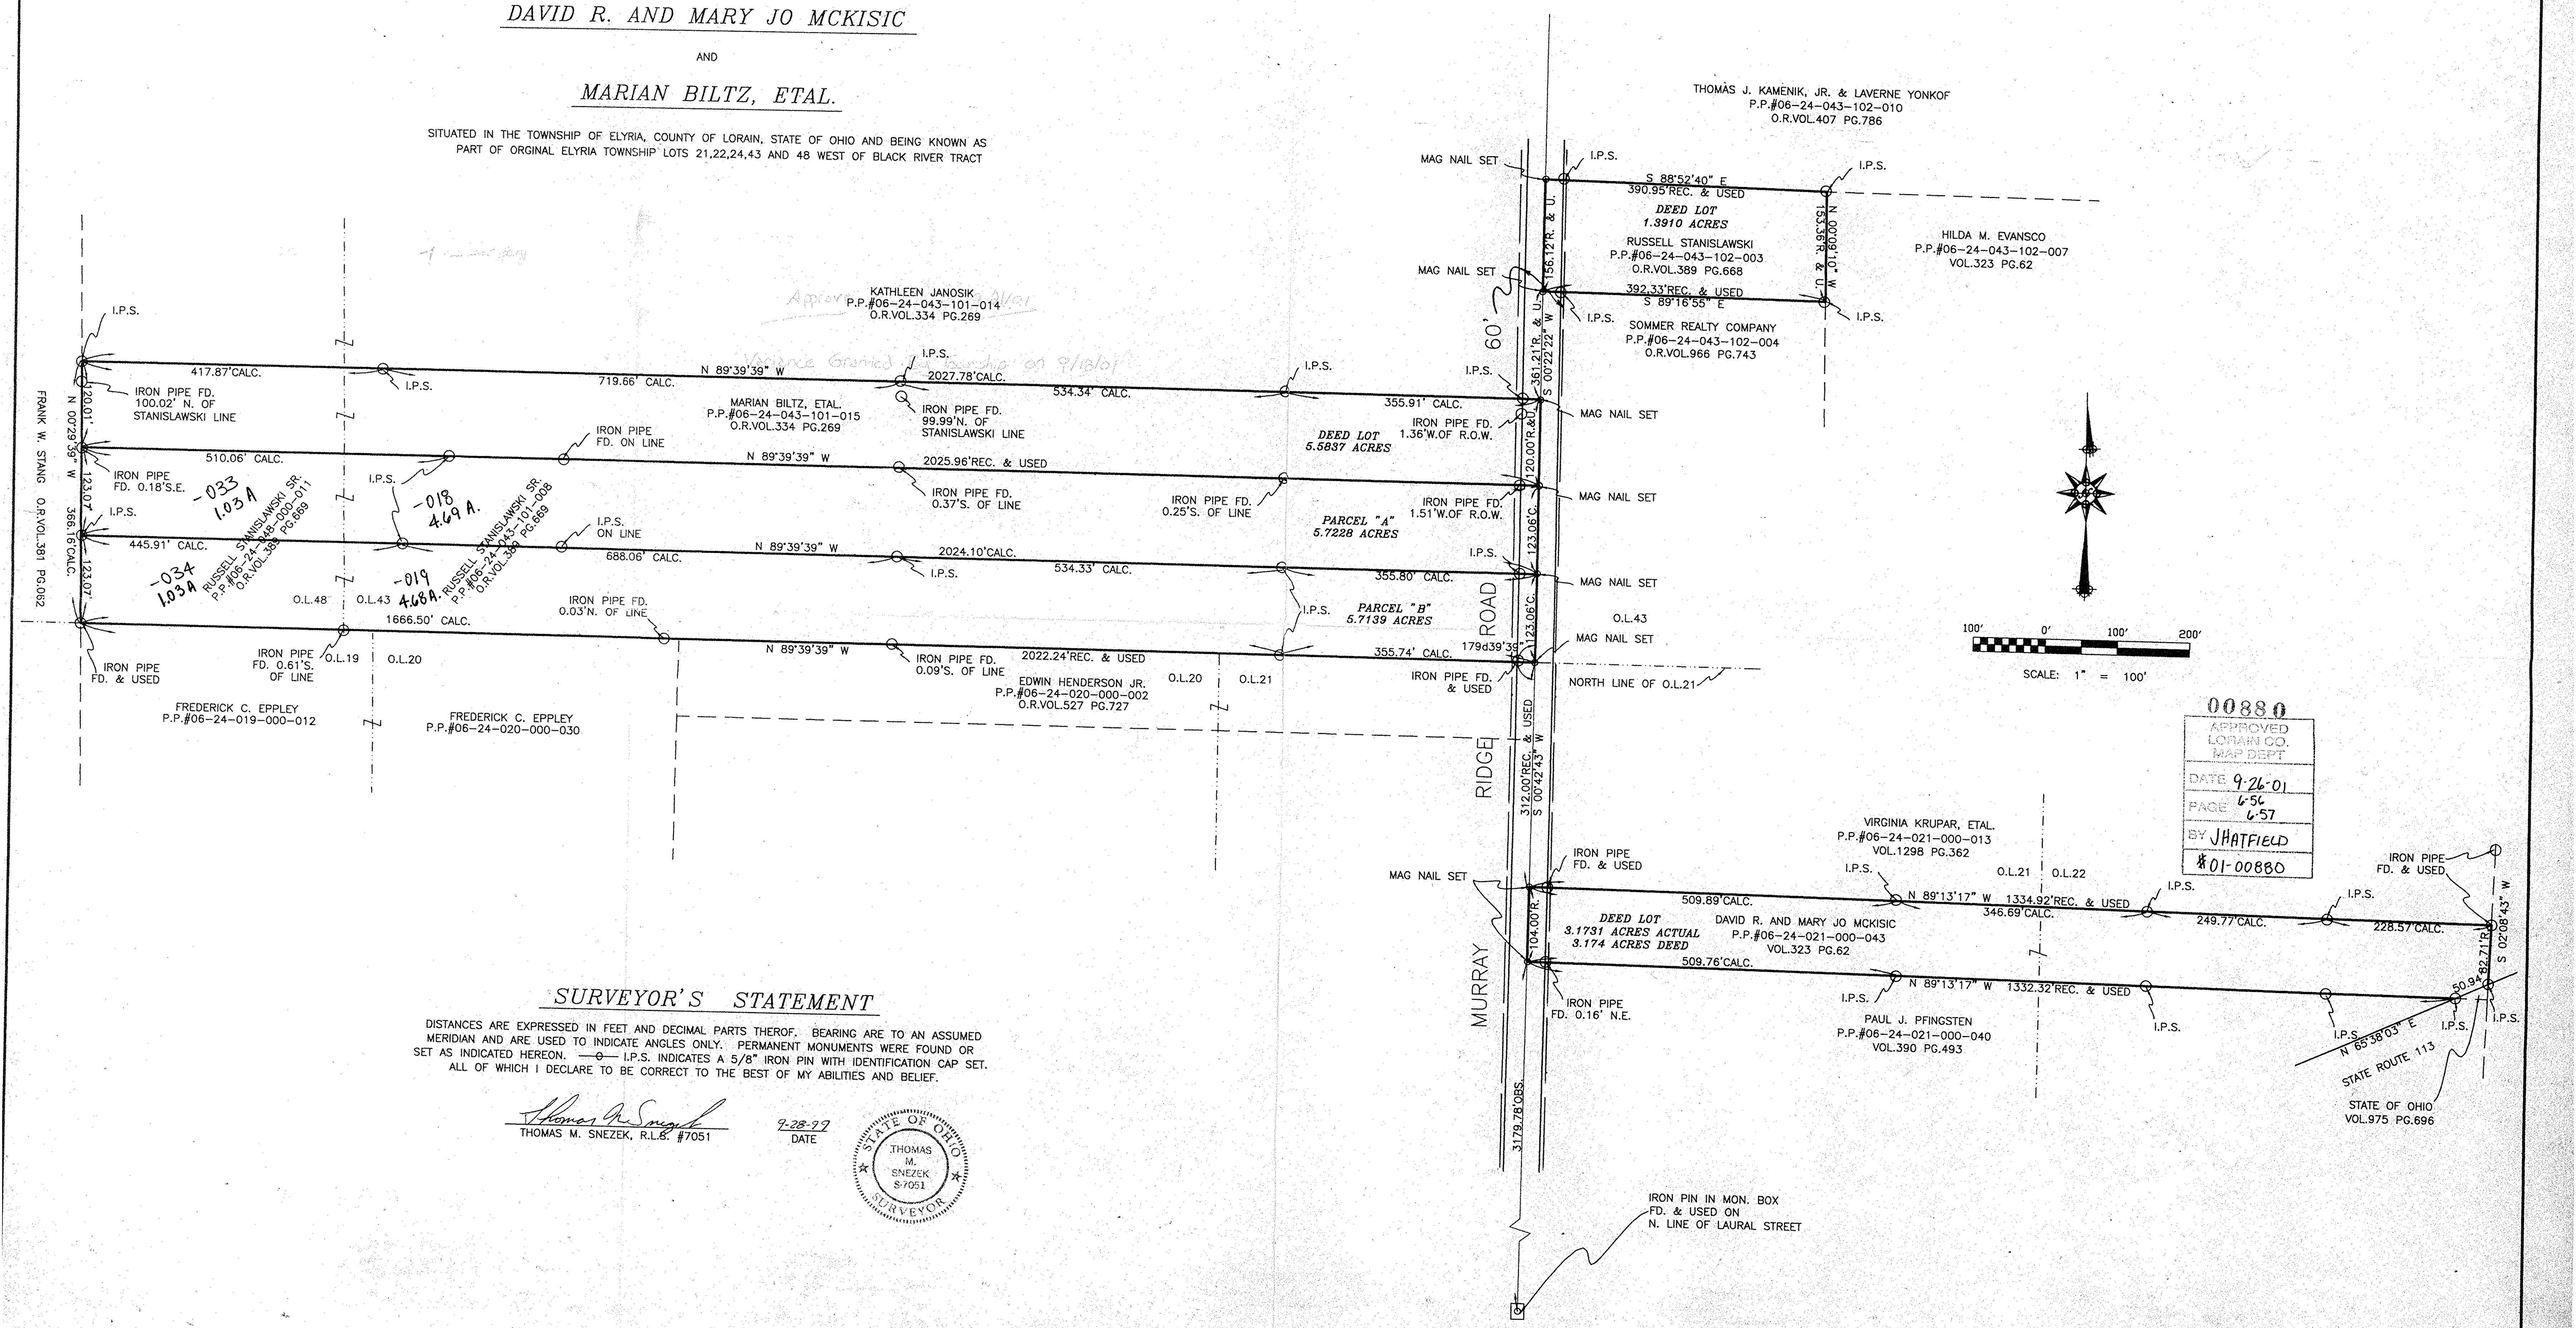

SURVEYOR'S STATEMENT

DISTANCES ARE EXPRESSED IN FEET AND DECIMAL PARTS THEROF. BEARING ARE TO AN ASSUMED MERIDIAN AND ARE USED TO INDICATE ANGLES ONLY. PERMANENT MONUMENTS WERE FOUND OR SET AS INDICATED HEREON. —o— I.P.S. INDICATES A 5/8" IRON PIN WITH IDENTIFICATION CAP SET. ALL OF WHICH I DECLARE TO BE CORRECT TO THE BEST OF MY ABILITIES AND BELIEF.

THOMAS M. SNEZEK, R.L.S. #7051

9-28-99
DATE

STATE OF OHIO
THOMAS M. SNEZEK
S-7051
SURVEYOR

PROJECT #9909 9/27/99