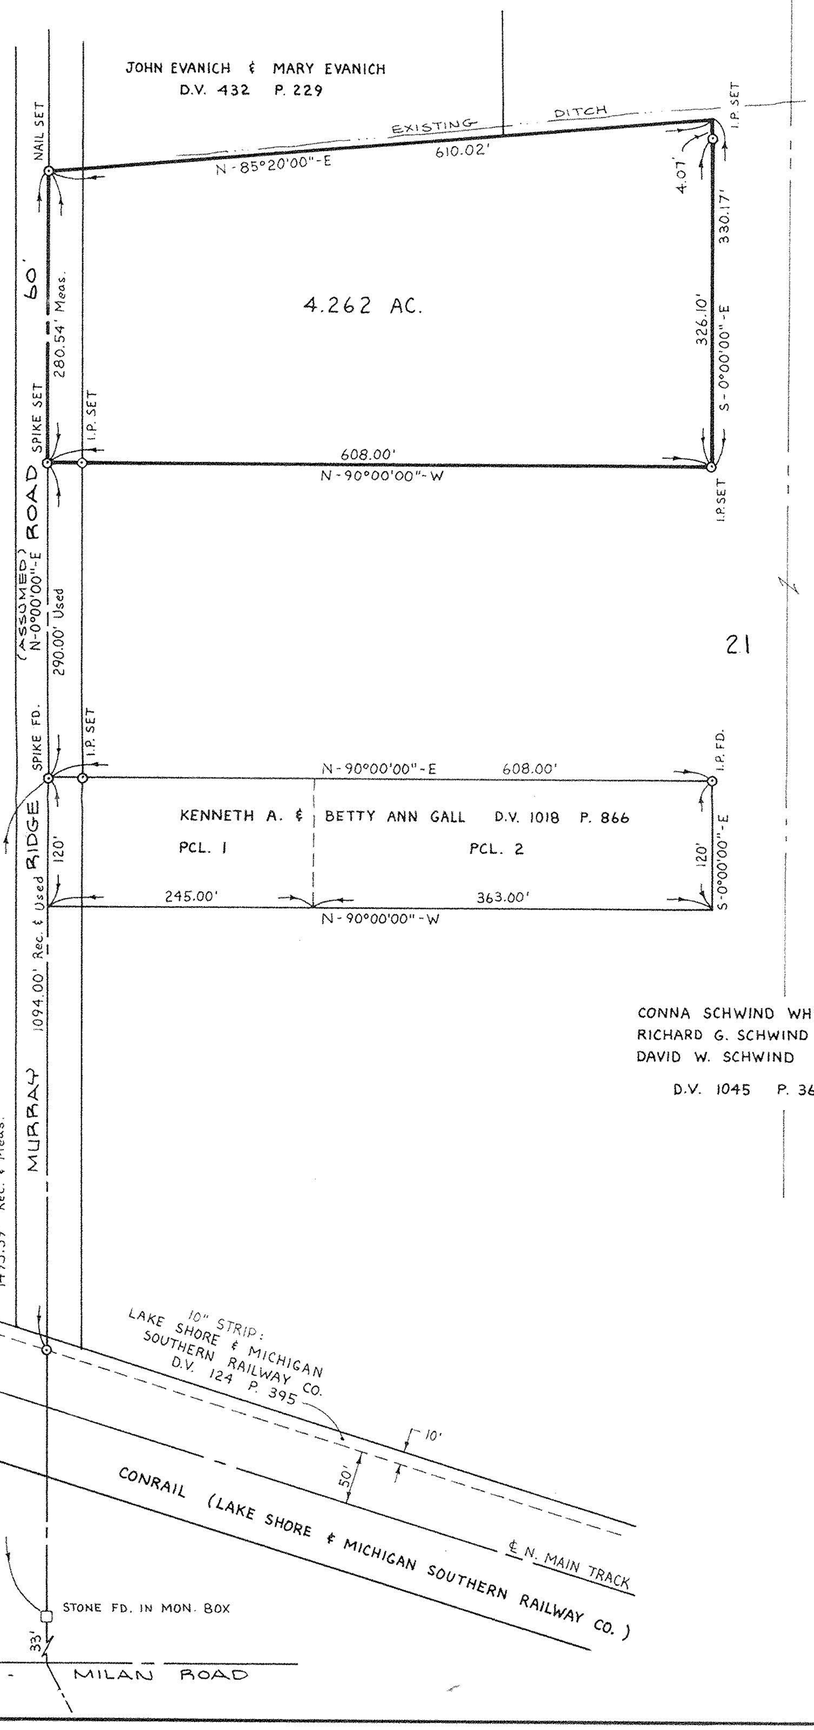

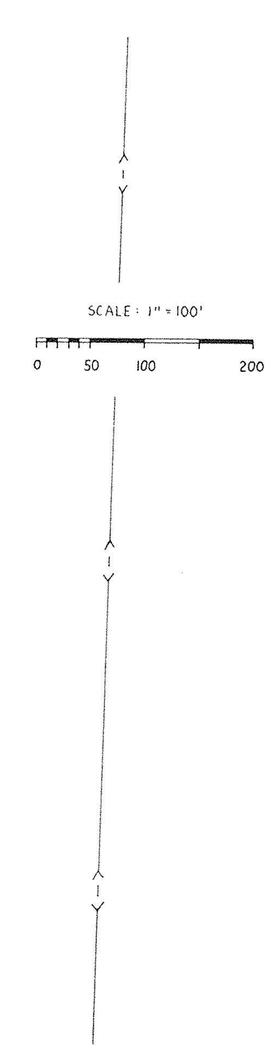

SURVEY MAP

OF PART OF

ELYRIA TOWNSHIP ORIGINAL LOT NO. 21
WEST OF THE BLACK RIVER
TOWNSHIP OF ELYRIA COUNTY OF LORAIN
STATE OF OHIO

#18841
APPROVED
LORAIN CO.
MAP DEPT.
DATE 2-14-90
PAGE G-75
BY CAROLYN FRANCIS
VOID AFTER # 18841

PREPARED BY:

KS ASSOCIATES INC.
ENGINEERS & SURVEYORS
1-05-90

David L. Elwell
DAVID L. ELWELL REG. SURV. NO. 6333

87-81