

6-24-029

6-65

06-24-029-101-000

# PLOT PLAN

JOB NO 71-324


## KLEINODER-SCHMIDT and ASSOCIATES

ENGINEERS - SURVEYORS - CONSULTANTS IN LAND PLANNING  
ELYRIA - NORWALK - MEDINA OHIO

SUBLOT

SUBDIVISION

OTHER PART OF ELYRIA TWP. O.L. 29 - W. OF RIV. - CITY OF ELYRIA

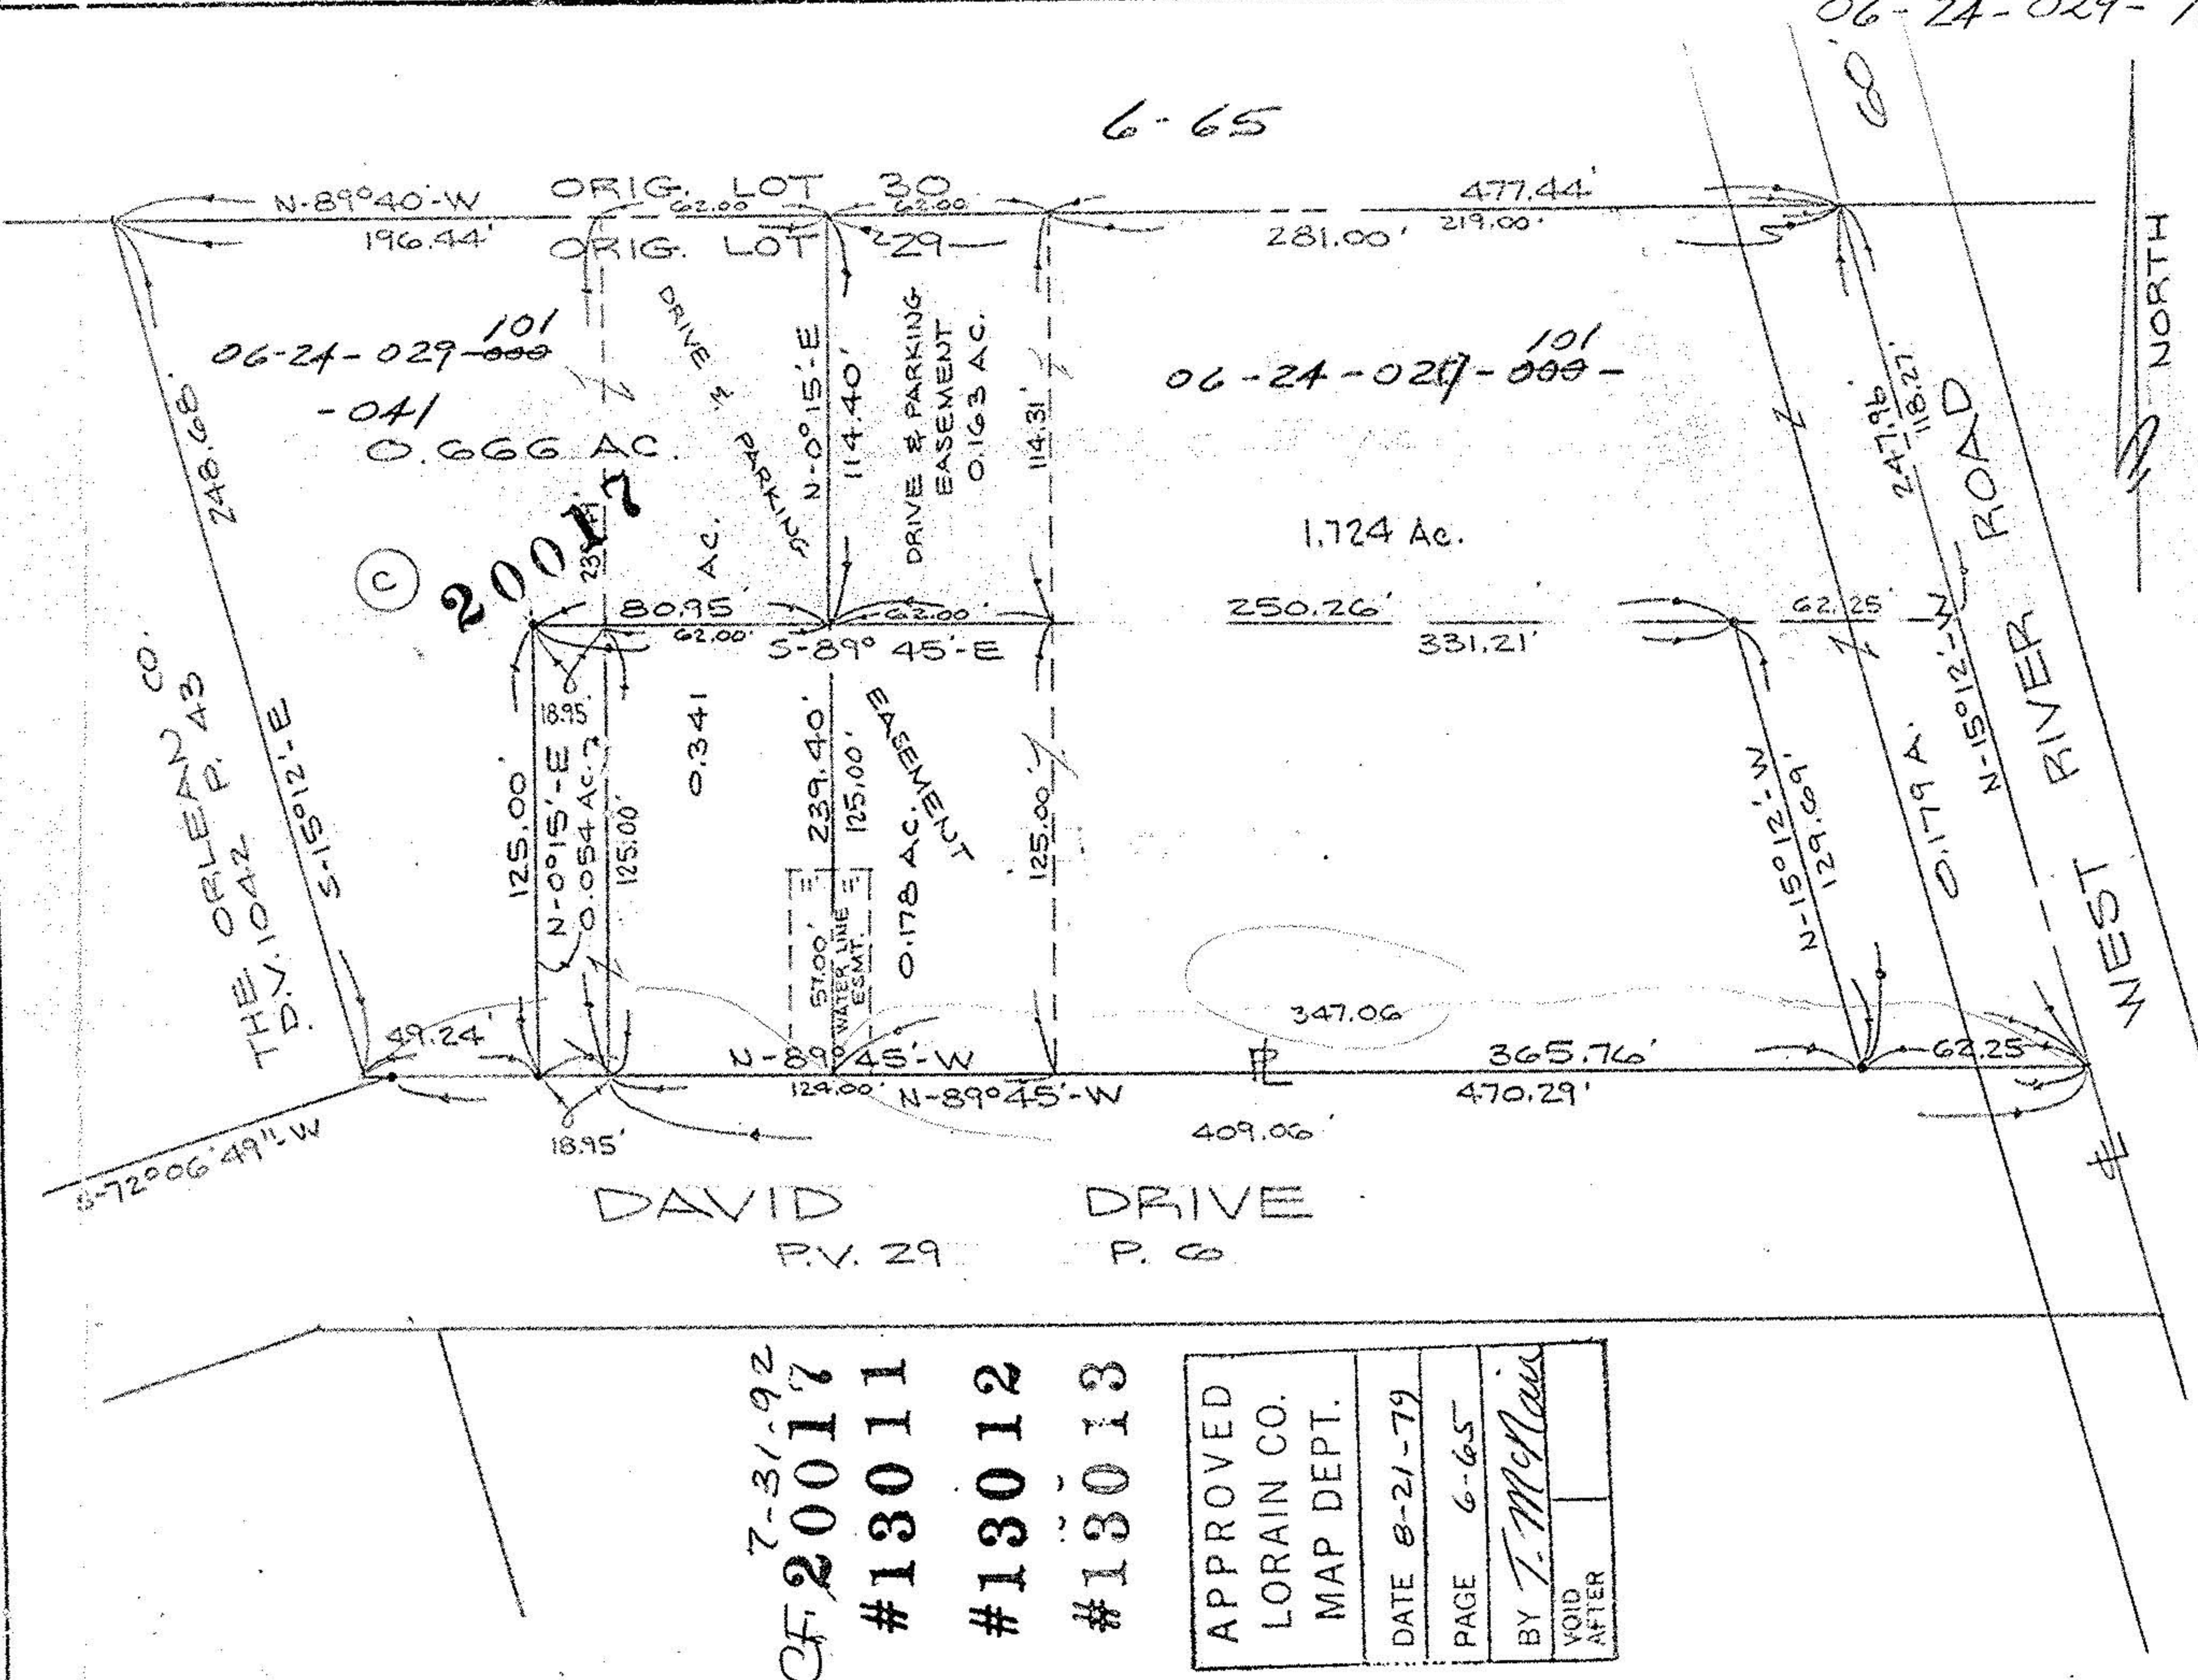

7-31-92  
 CF 20017  
 #13011  
 #13012  
 #13013

APPROVED	
LORAIN CO.	
MAP DEPT.	
DATE 8-21-79	
PAGE 6-65	
BY T. McNamee	
VOID AFTER	

Prepared for:

R. POLK

Scale: 1" = 60'

Date: MAR. 24, 1977

REV. 2-23-79

REV. 7-6-77 REV. 11-17-77