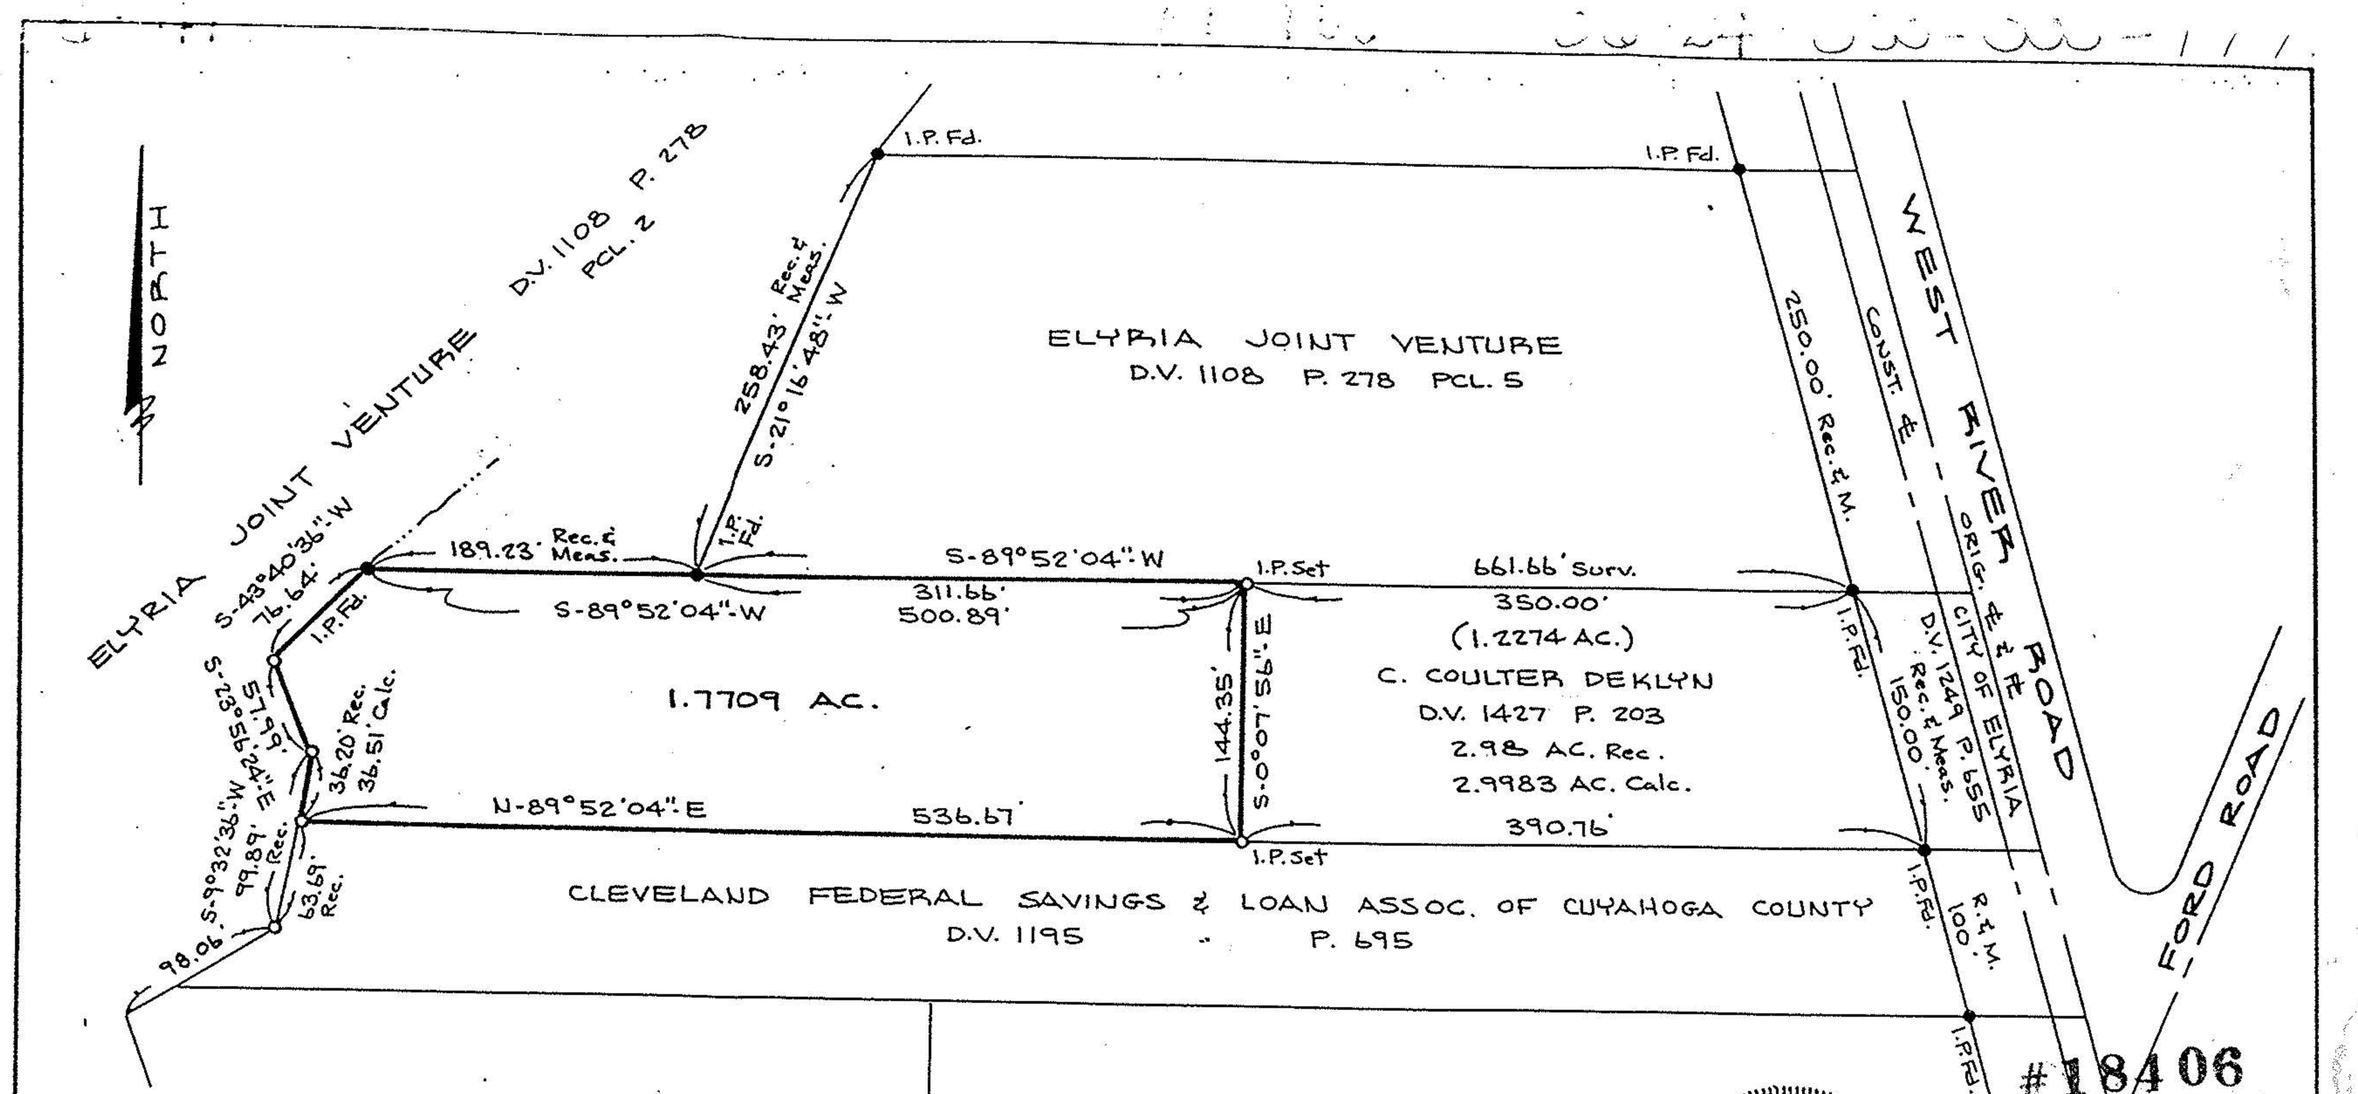

BOUNDARY SURVEY

PART OF ELYRIA TOWNSHIP ORIGINAL LOT 30
WEST OF BLACK RIVER.
CITY OF ELYRIA COUNTY OF LORAIN STATE OF OHIO
SCALE: 1" = 100'
FEB. 10, 1989
PREPARED BY: K.S. ASSOCIATES INC.
ENGINEERS SURVEYORS

David L. Elwell
REG. SURVEYOR NO. 6833

STATE OF OHIO
DAVID L. ELWELL
6833
REGISTERED SURVEYOR

#18406

APPROVED
LORAIN CO.
MAP DEPT.
DATE 5-1-89
PAGE 6-47
BY Carol Francis
VOID AFTER # 18406