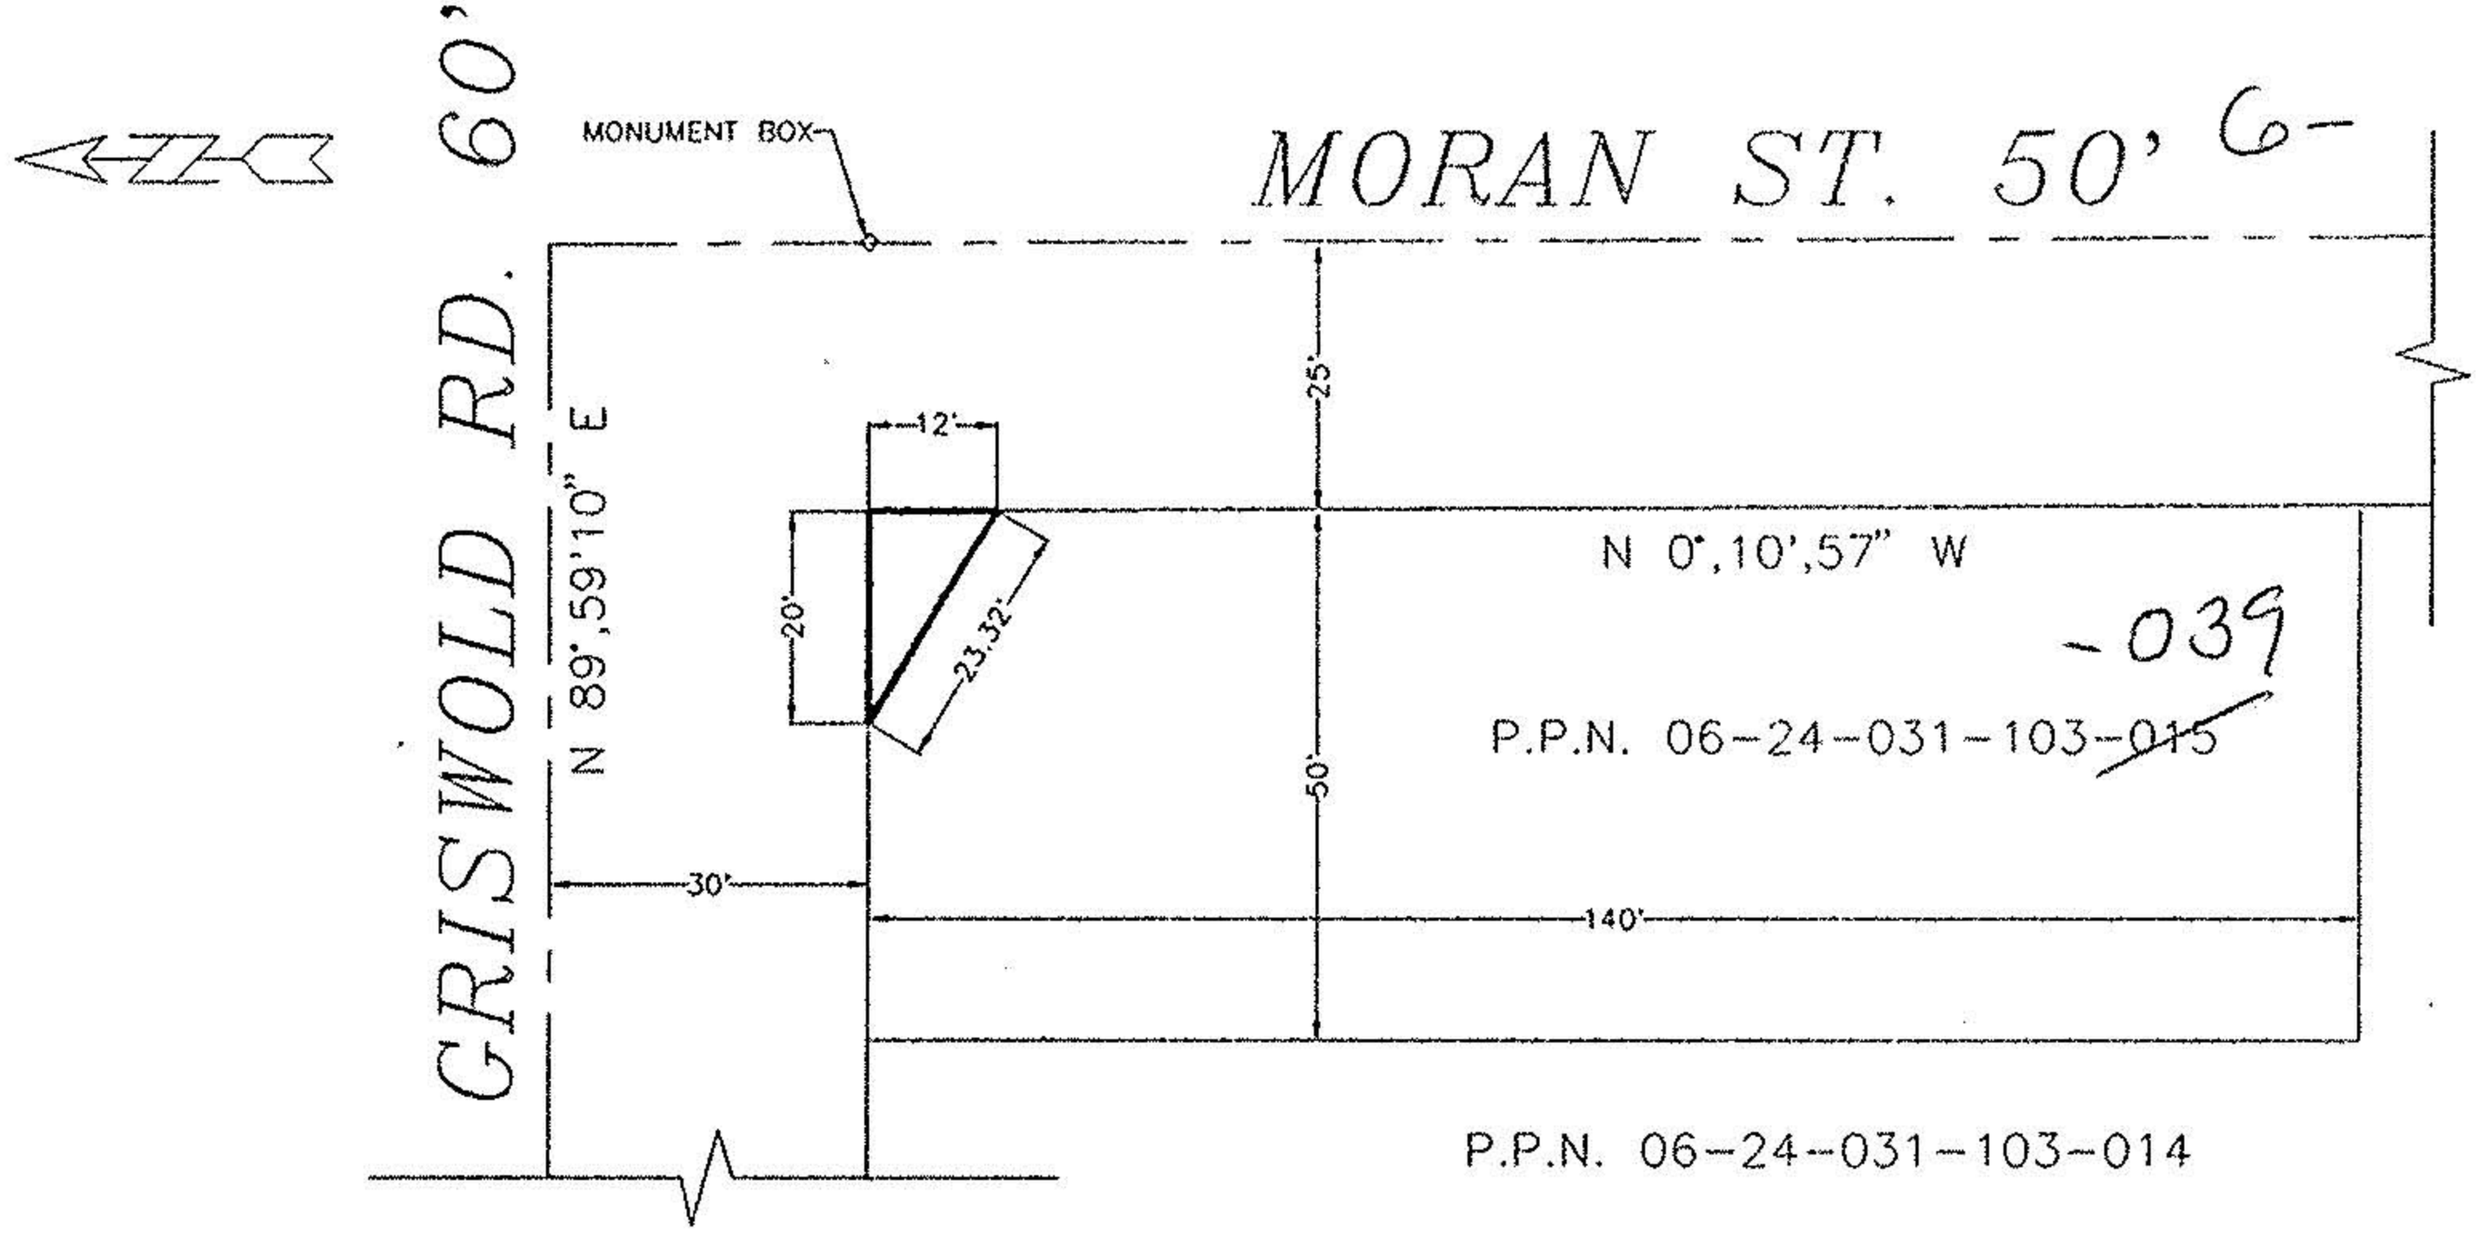

SITUATED IN THE CITY OF ELYRIA, COUNTY OF LORAIN AND STATE OF OHIO, AND BEING KNOWN AS PART OF ORIGINAL LOT NUMBER 31, WEST OF BLACK RIVER AND BEING PART OF LEONA HEIGHTS ALLOTMENT, SUBLOT 551 AS RECORDED IN VOLUME 6, PAGE 35 & 36 OF LORAIN COUNTY RECORD OF PLATS.

STATE OF OHIO
LONNY G. SHIPPY
S-006180
REGISTERED SURVEYOR

8/16/94

APPROVED BY PLANNING COMMISSION
CITY of ELYRIA, O.
NO PLAT REQUIRED
DATE 8-16-94
Clerk

30 0 30 90

Scale 1" = 30 ft

CITY OF ELYRIA
DEPARTMENT OF PUBLIC SERVICE
DIVISION OF ENGINEERING

RIGHT OF WAY
ACQUISITION FOR
GRISWOLD ROAD PROJECT

REVISION	DATE			
△		DRAWN BY: V.Y.	DATE: 08-94	SCALE: 1"=30'
△		DESIGNED BY:	DATE:	△
△		CHECKED BY:	DATE:	SHEET 1 OF 1
△				