


DANE A. HAPONEK

Engineers & Surveyors


5444 Stoney Ridge Road North Ridgeville, Ohio 44039

(440) 327-4776

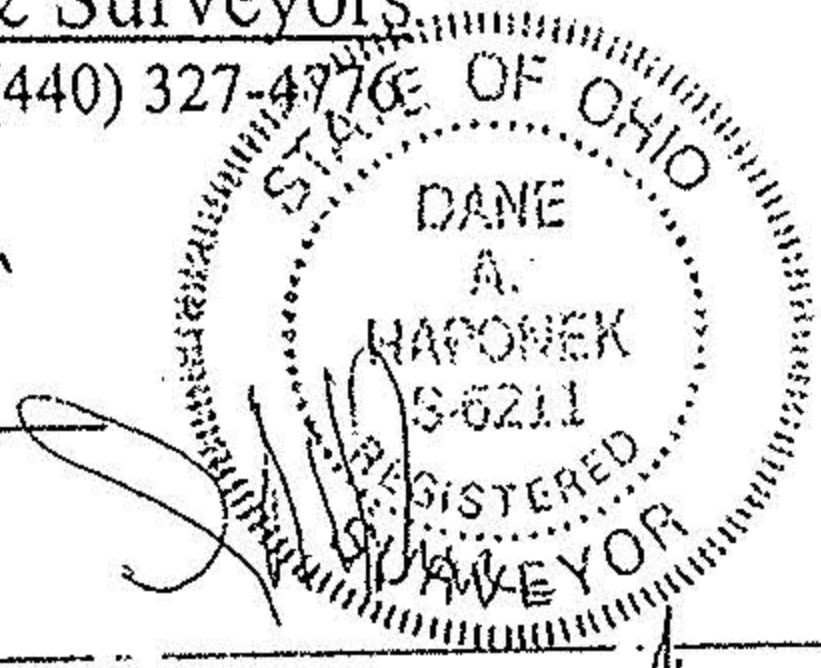

CRISWOLD RD 60'

W. RAIN LAKE AVE.

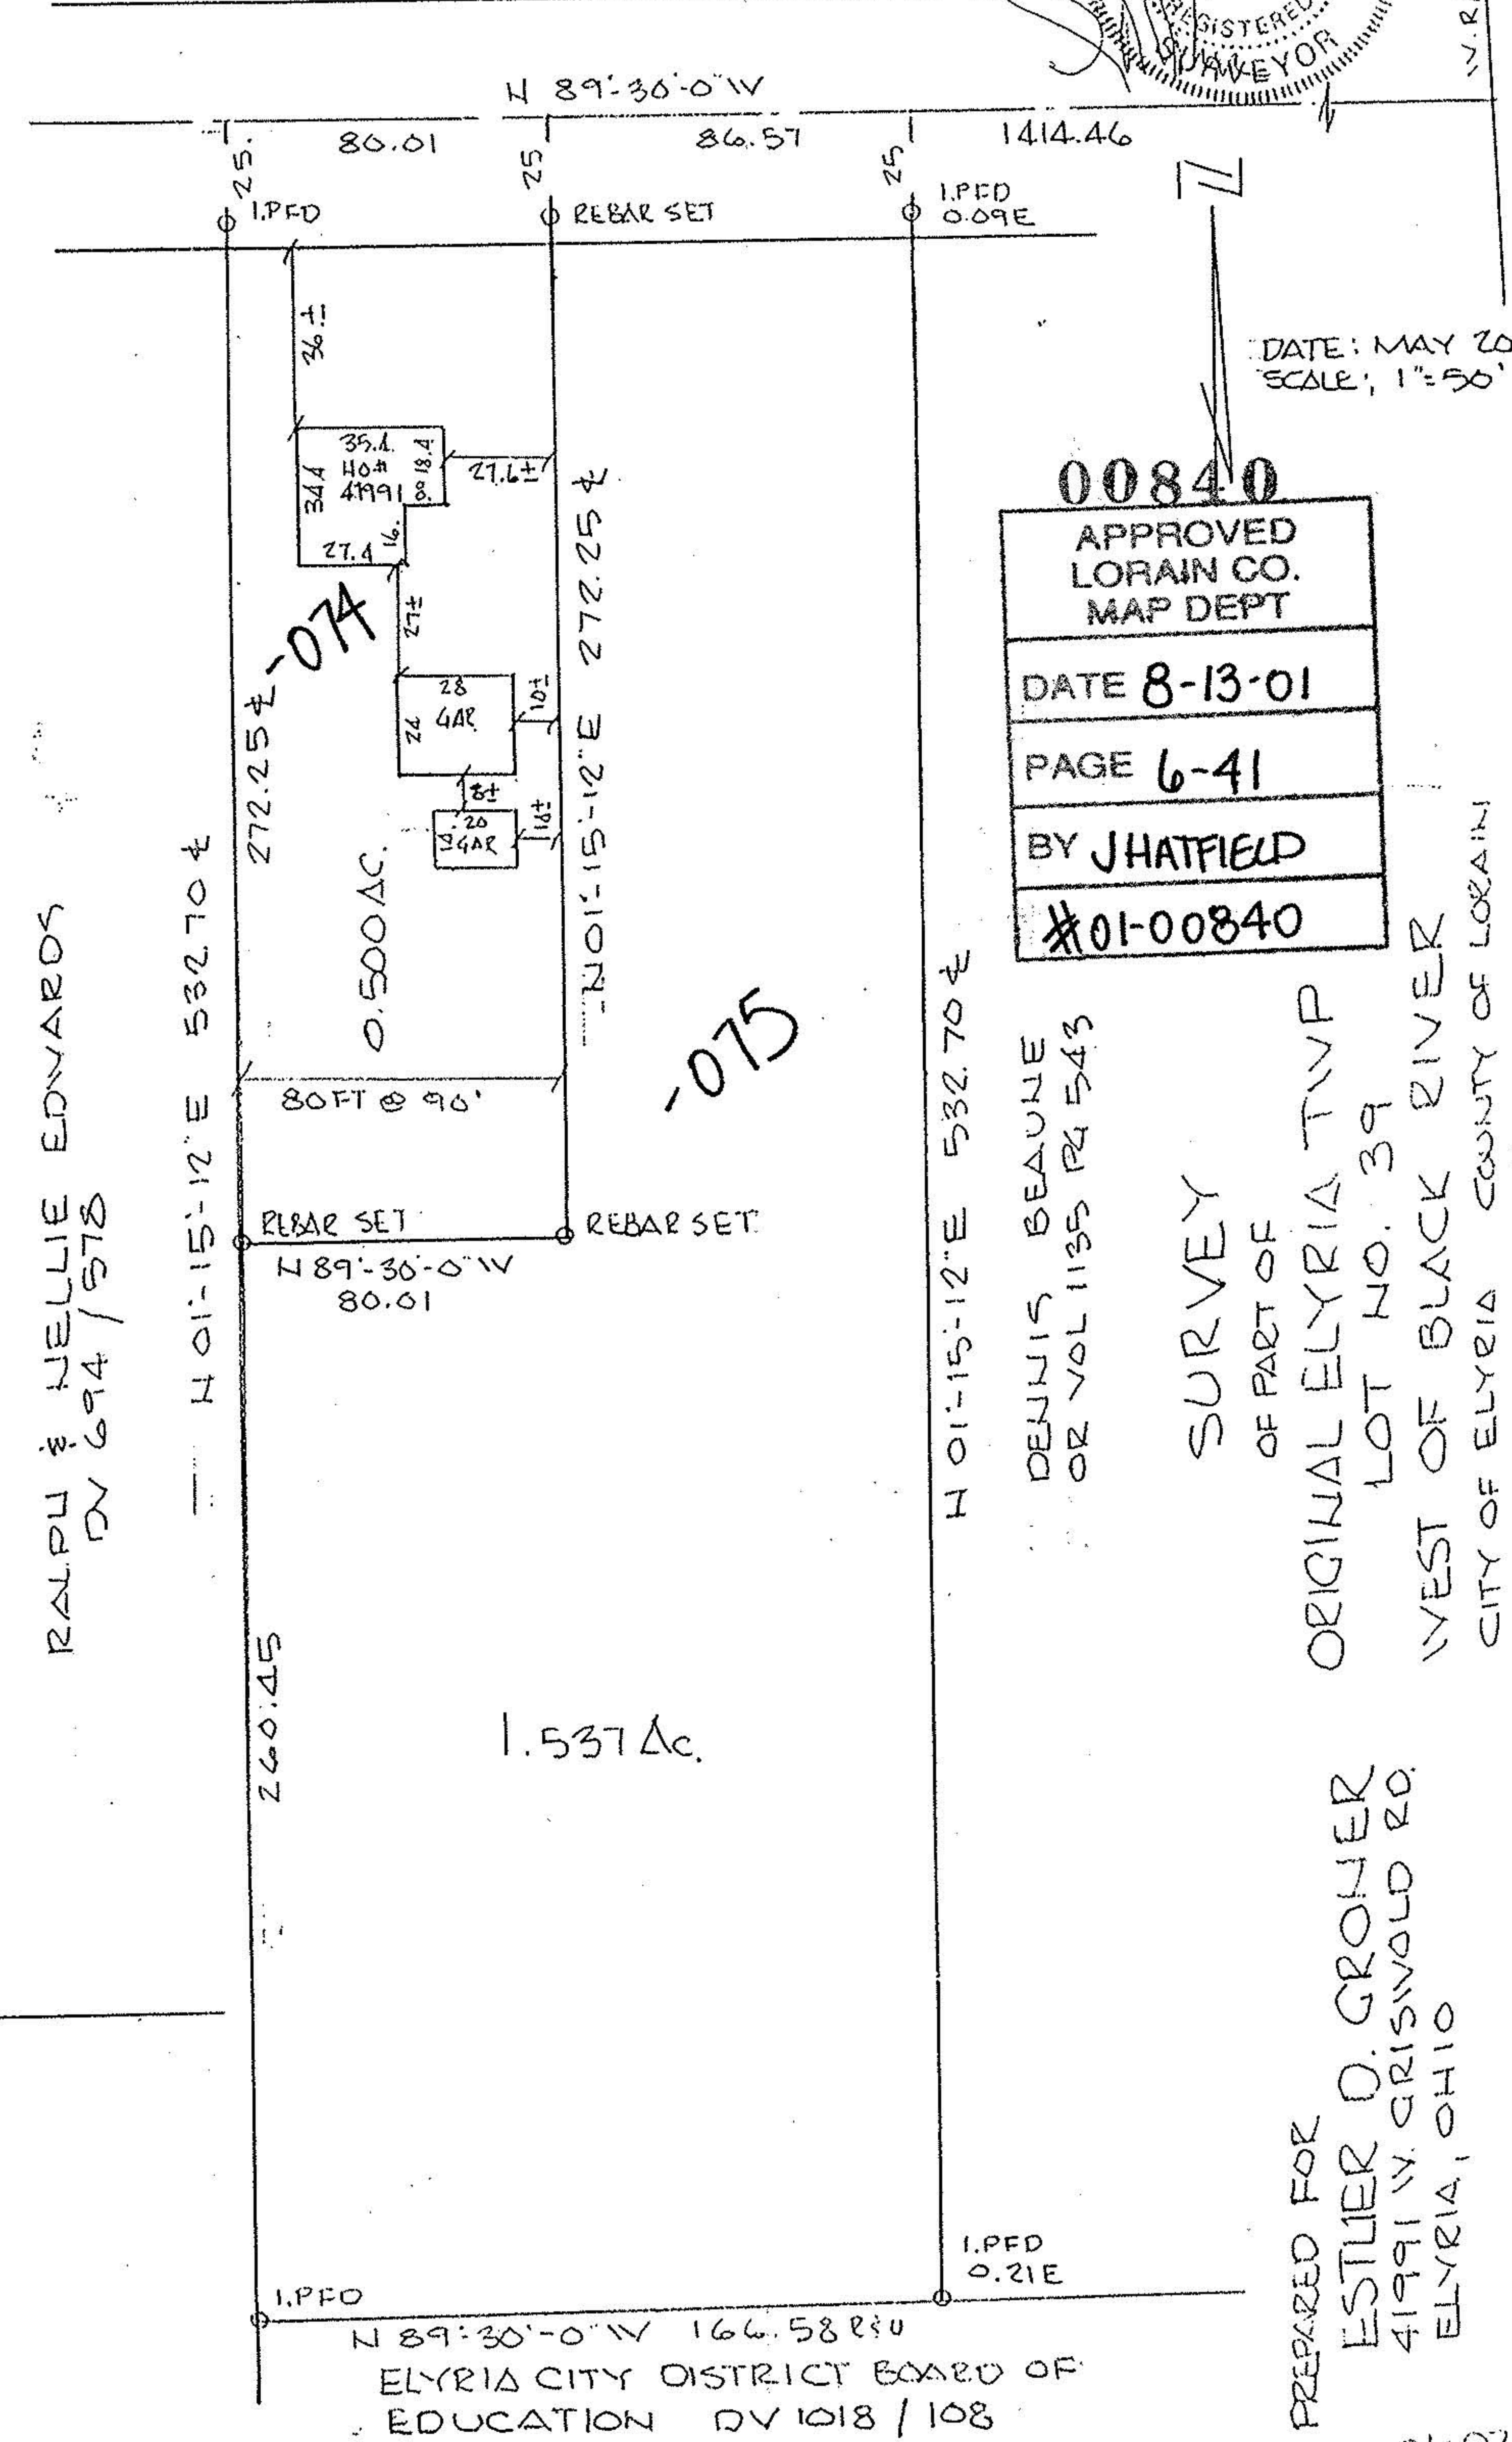

DATE: MAY 2001
SCALE: 1"=50'

00840

APPROVED LORAIN CO. MAP DEPT
DATE 8-13-01
PAGE 6-41
BY JHATFIELD
#01-00840

RALPH & NELLIE EDWARDS
DV 694 / 578

DENNIS BEAUNE
OR VOL 1135 P4 543

SURVEY

OF PART OF

ORIGINAL ELYRIA TWP

LOT NO. 39

WEST OF BLACK RIVER

CITY OF ELYRIA COUNTY OF LORAIN

STATE OF OHIO

260.45

1.537 Ac.

I.PFD

I.PFD
0.21E

N 89°30'0" W 166.58 ±
ELYRIA CITY DISTRICT BOARD OF
EDUCATION DV 1018 / 108

PREPARED FOR
ESTUER O. GROWER
41991 W. CRISWOLD RD.
ELYRIA, OHIO

01-07