


6-28
6-39

22.95
75.84
20.00
118.79

06-24-046-105-001

06-24-045-102

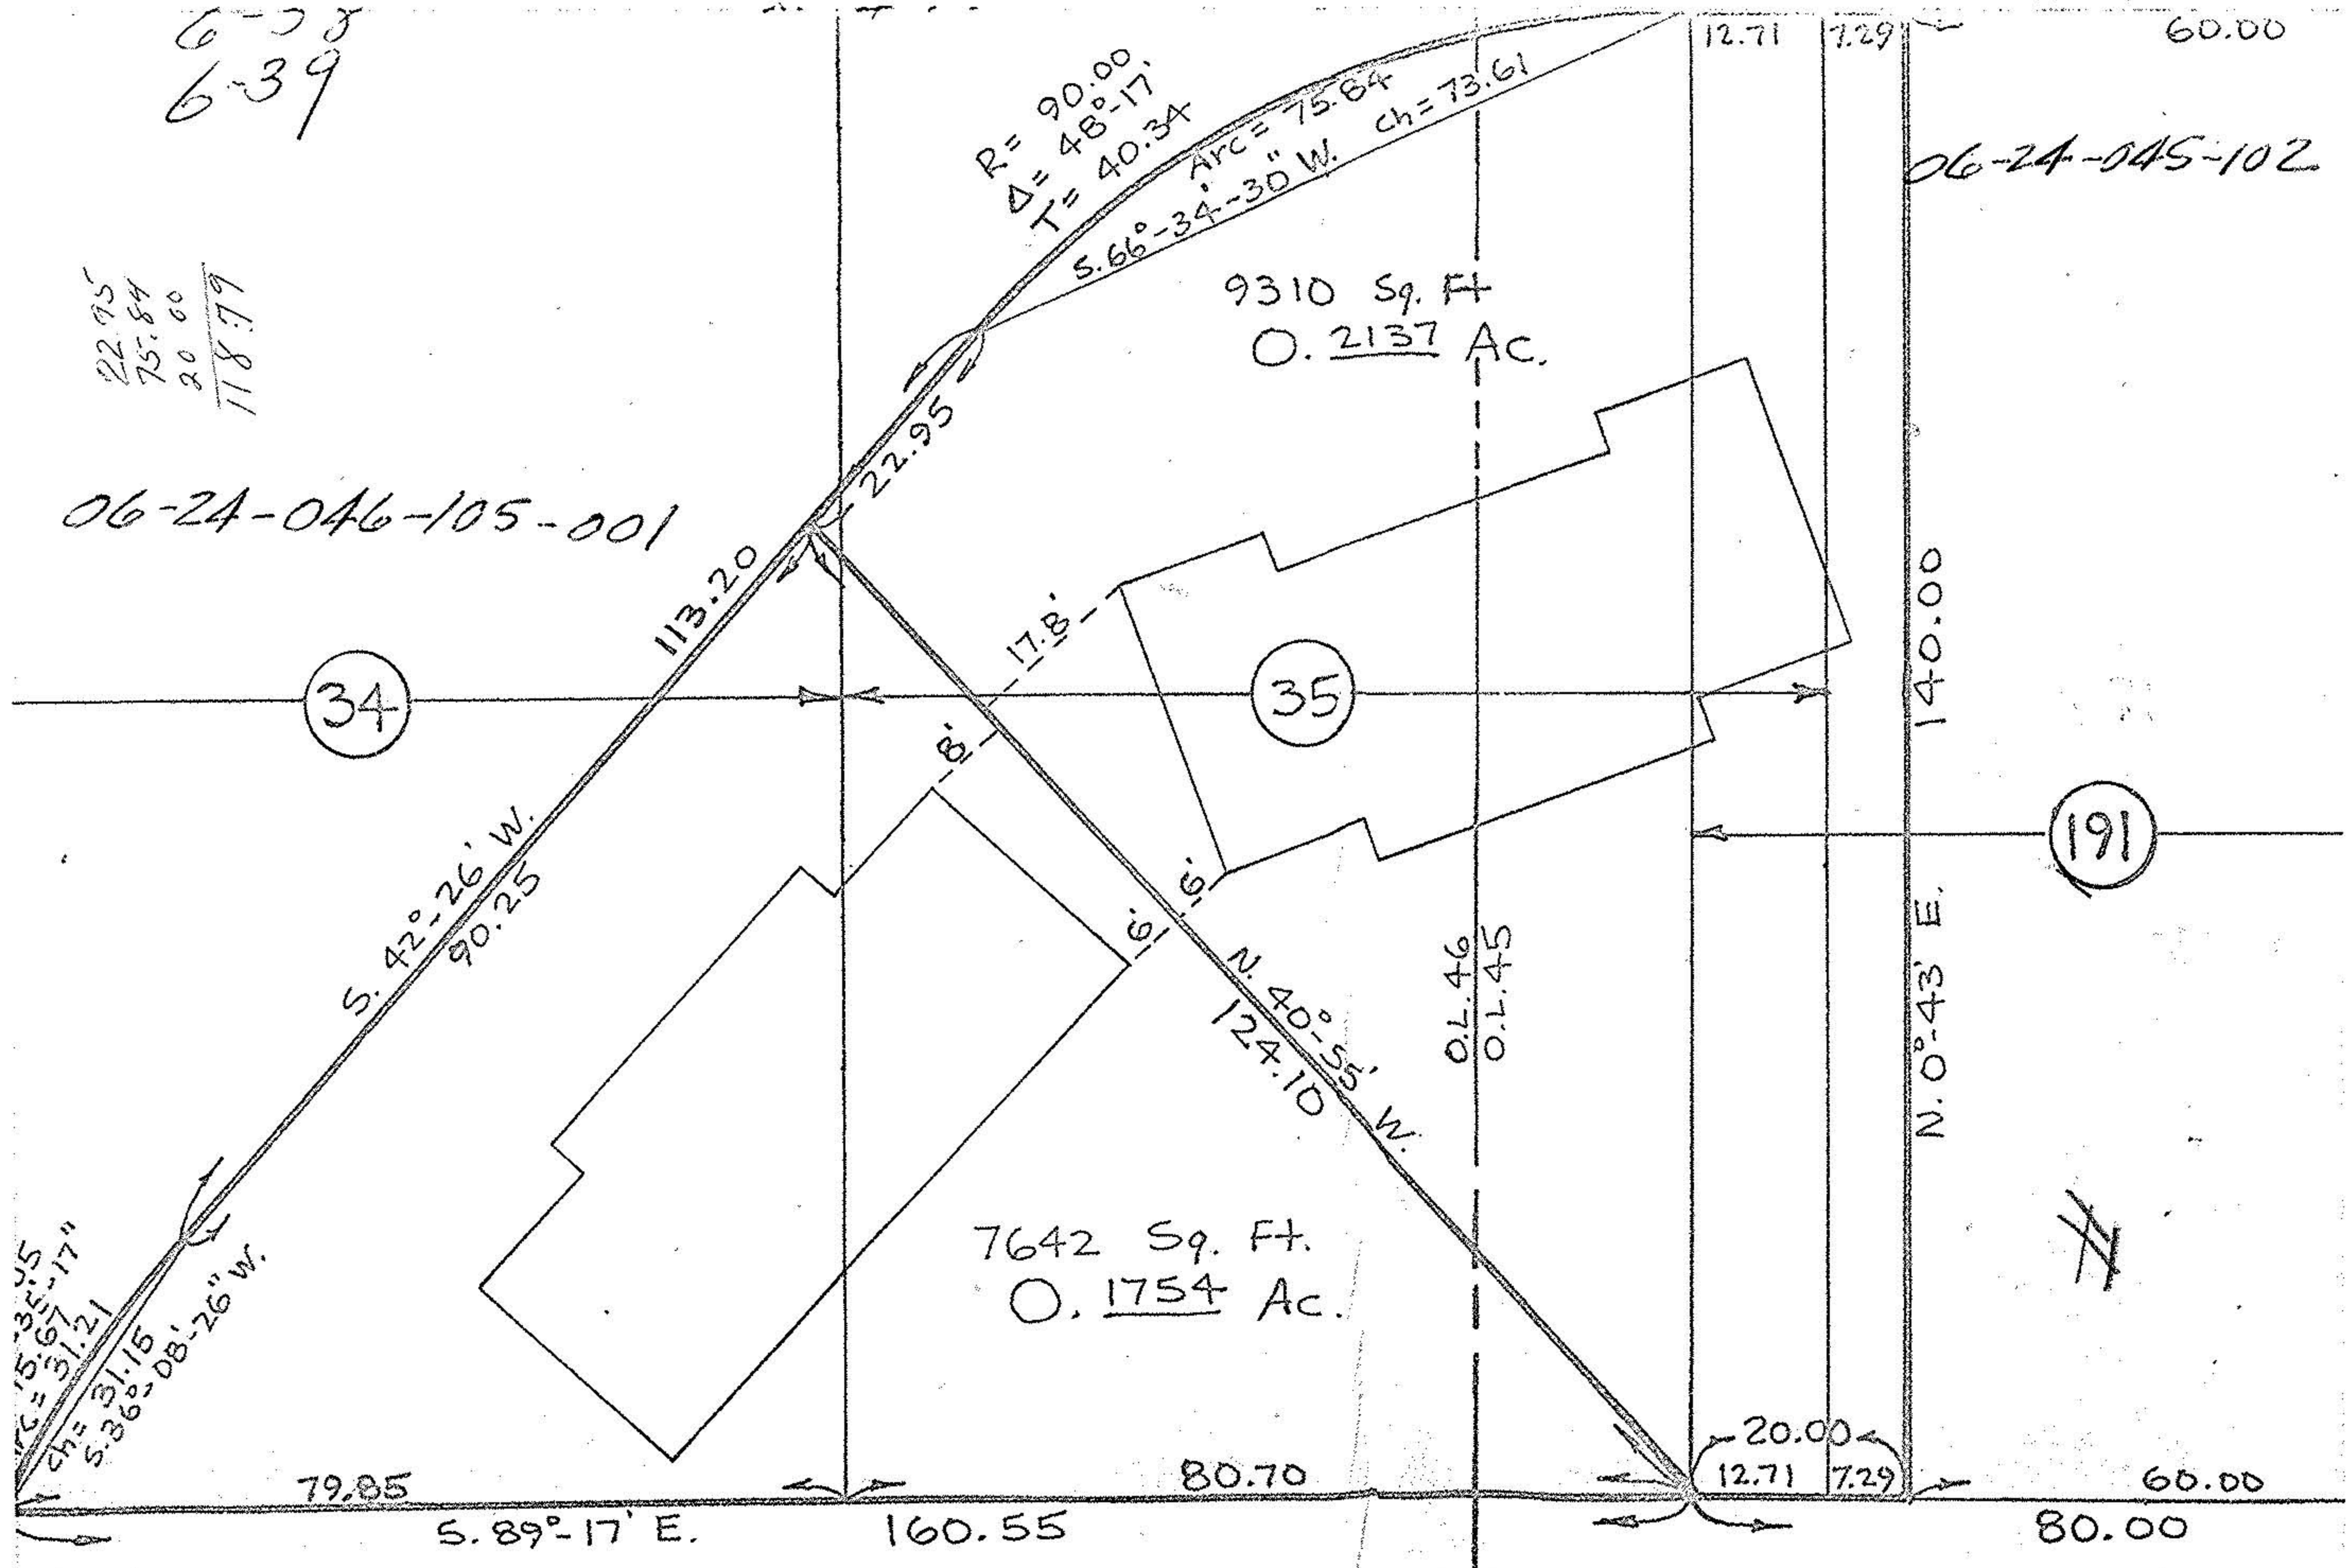

Map showing parts of sublots
Cresthaven Sub. No. 2, Plat Vol.