KLEINOEDER · SCHMIDT and ASSOCIATES

ENGINEERS — SURVEYORS — CONSULTANTS in LAND PLANNING

ELYRIA · NORWALK · MEDINA OHIO

SURVEY

Sublot(s) 27

Subd'n MANOR-JAY SUBDIVISION

P.V. 15 P. 31

Township ELYRIA Tract WEST OF BLACK RIVER

Orig. Lot(s) 45 Sec.

County of LORAIN State of Ohio

Corporation

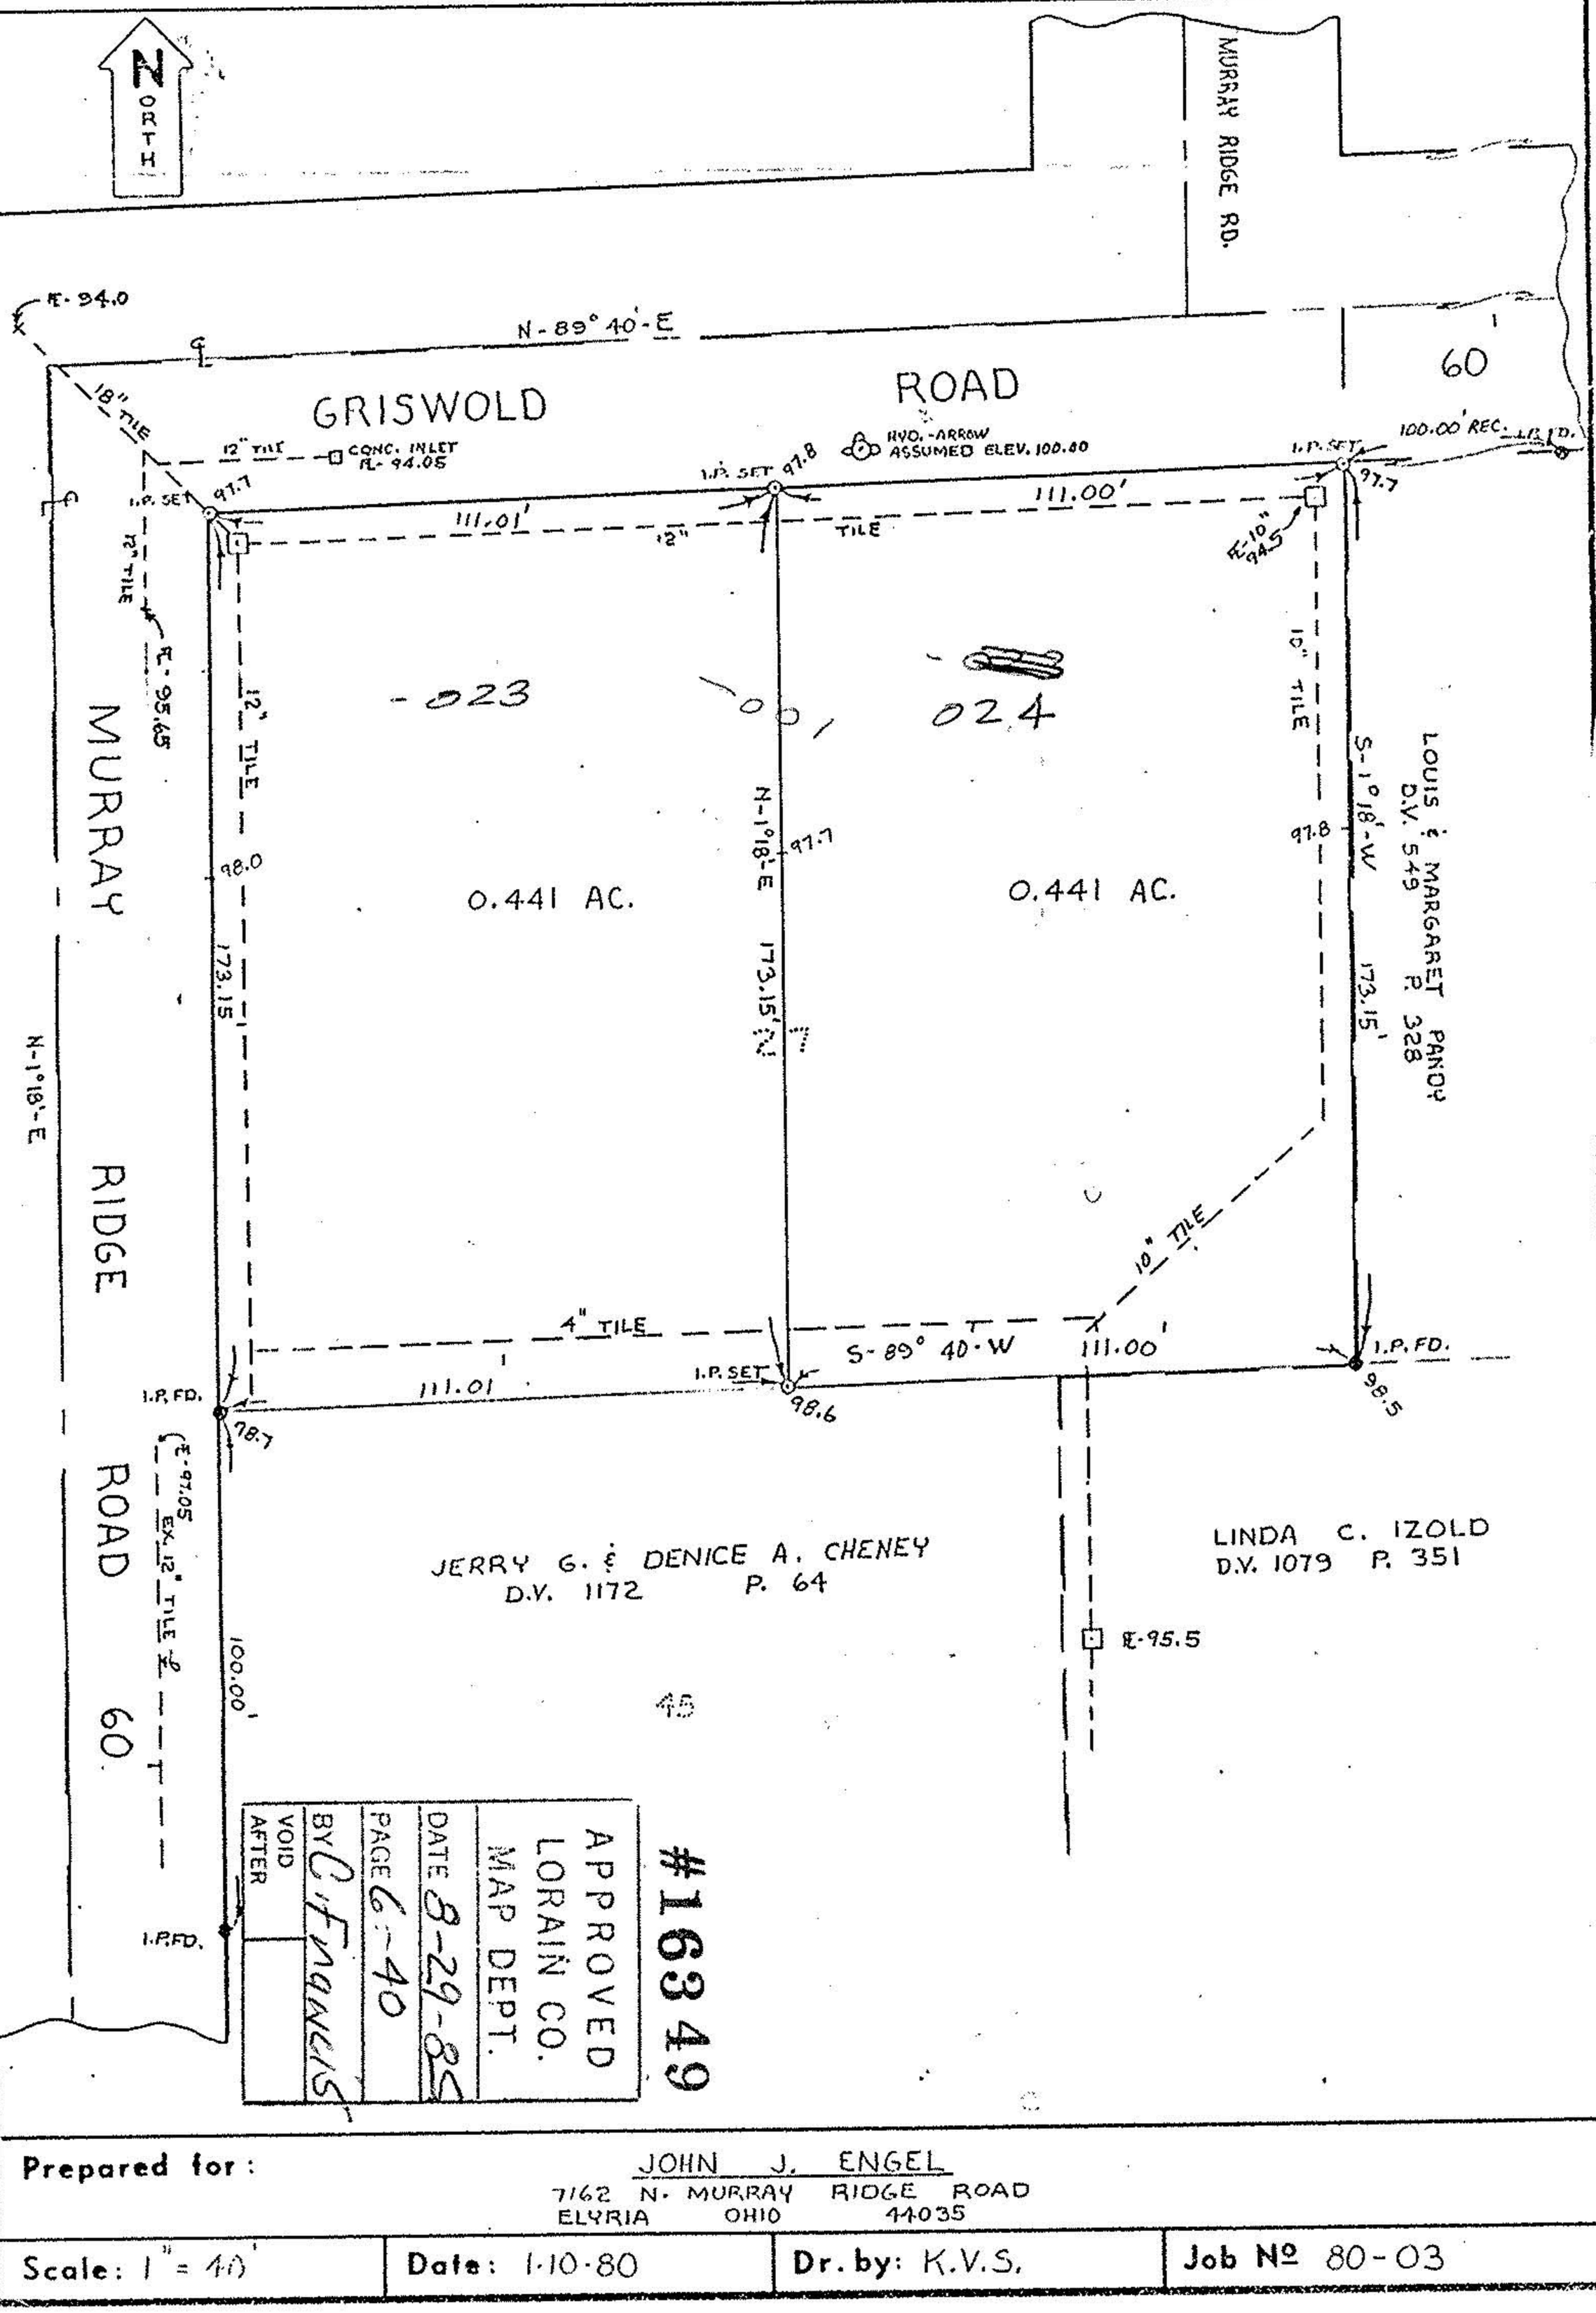

Prepared for: JOHN J. ENGEL

7162 N. MURRAY RIDGE ROAD

ELYRIA OHIO 44035

Scale: 1" = 40'	Date: 1-10-80	Dr. by: K.V.S.	Job № 80-03

06-24-045-105-