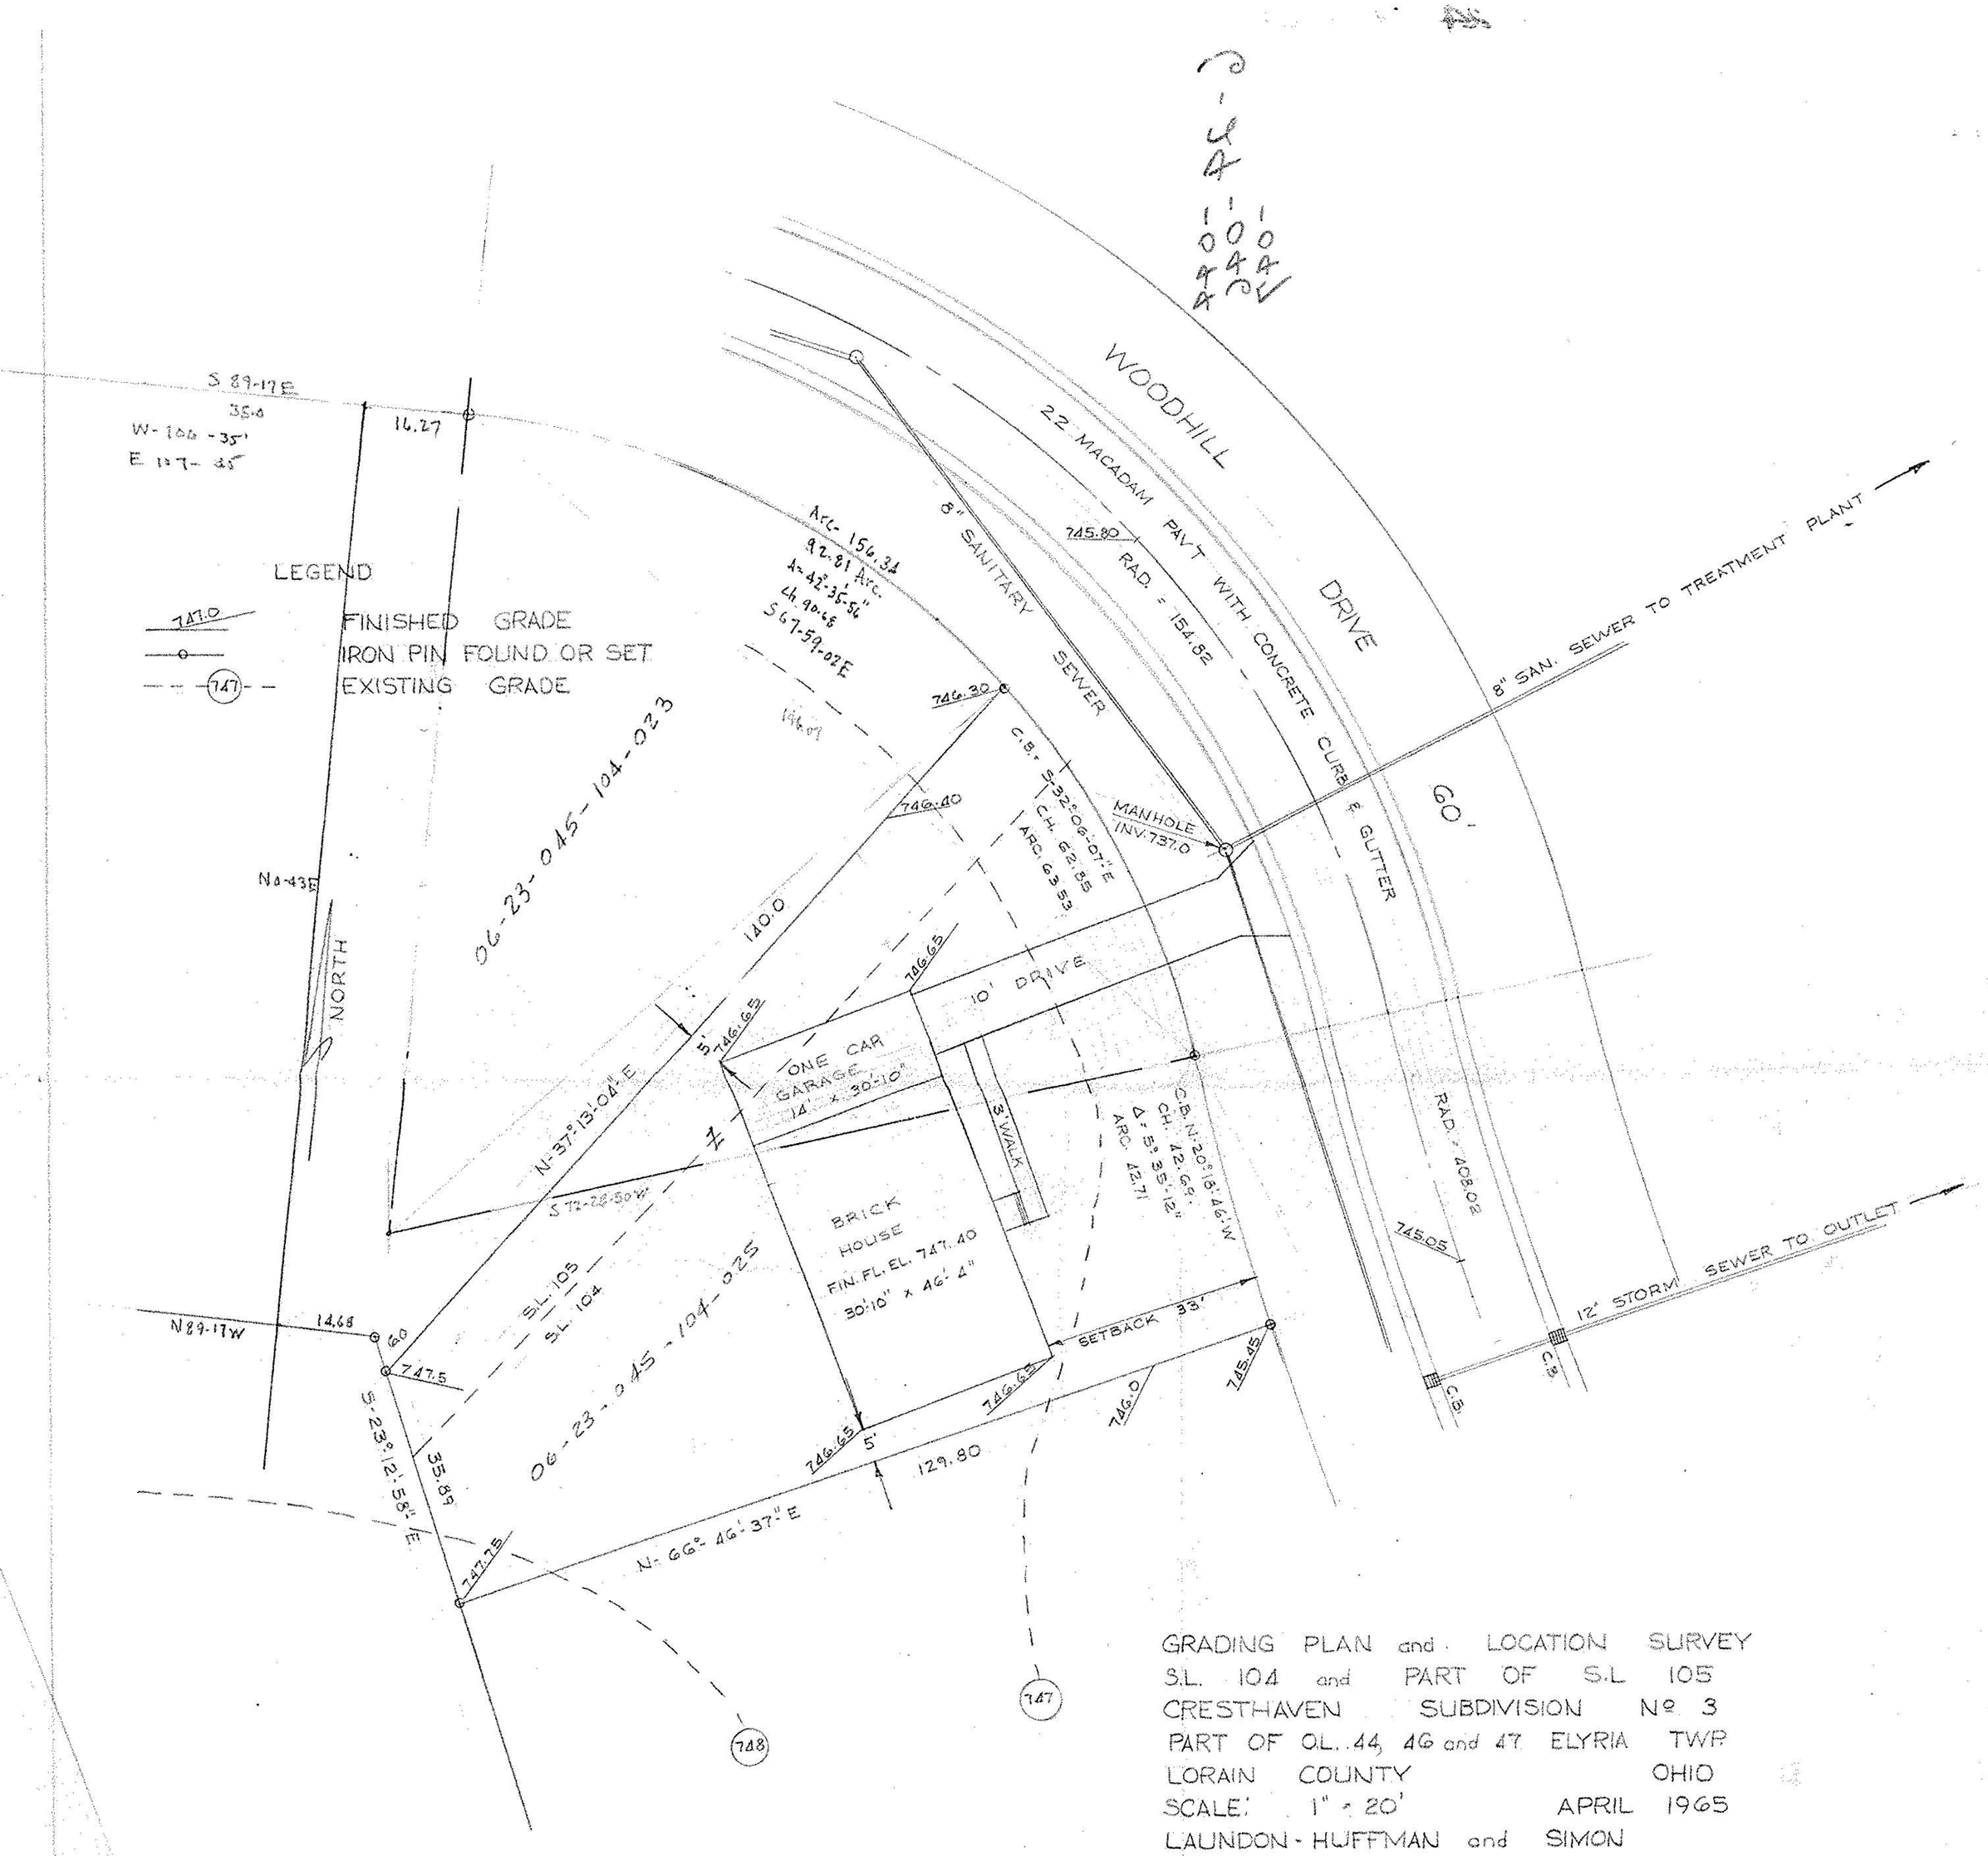

GRADING PLAN and LOCATION SURVEY
S.L. 104 and PART OF S.L 105
CRESTHAVEN SUBDIVISION Nº 3
PART OF O.L. 44, 46 and 47 ELYRIA TWP.
LORAIN COUNTY OHIO
SCALE: 1" = 20' APRIL 1965
LAUNDON - HUFFMAN and SIMON
REGISTERER SURVEYORS