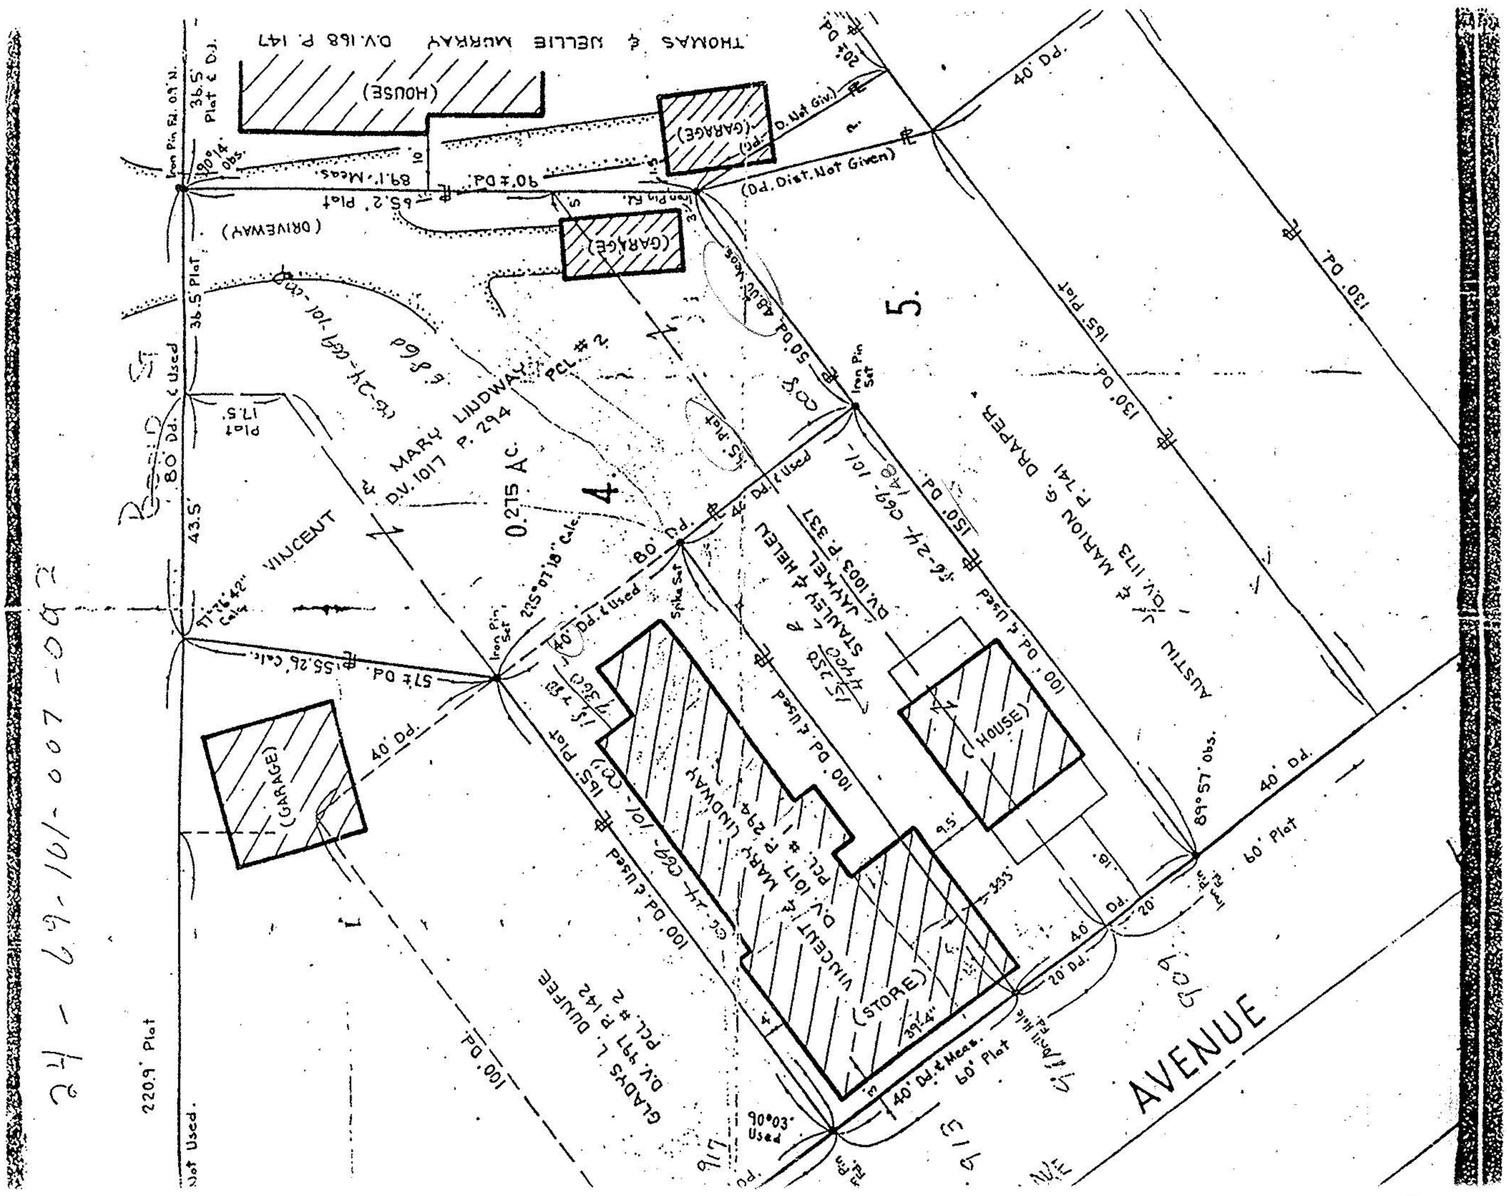

Pg 6-80

00253-X

2/2/2000

T. Spillman

6-80

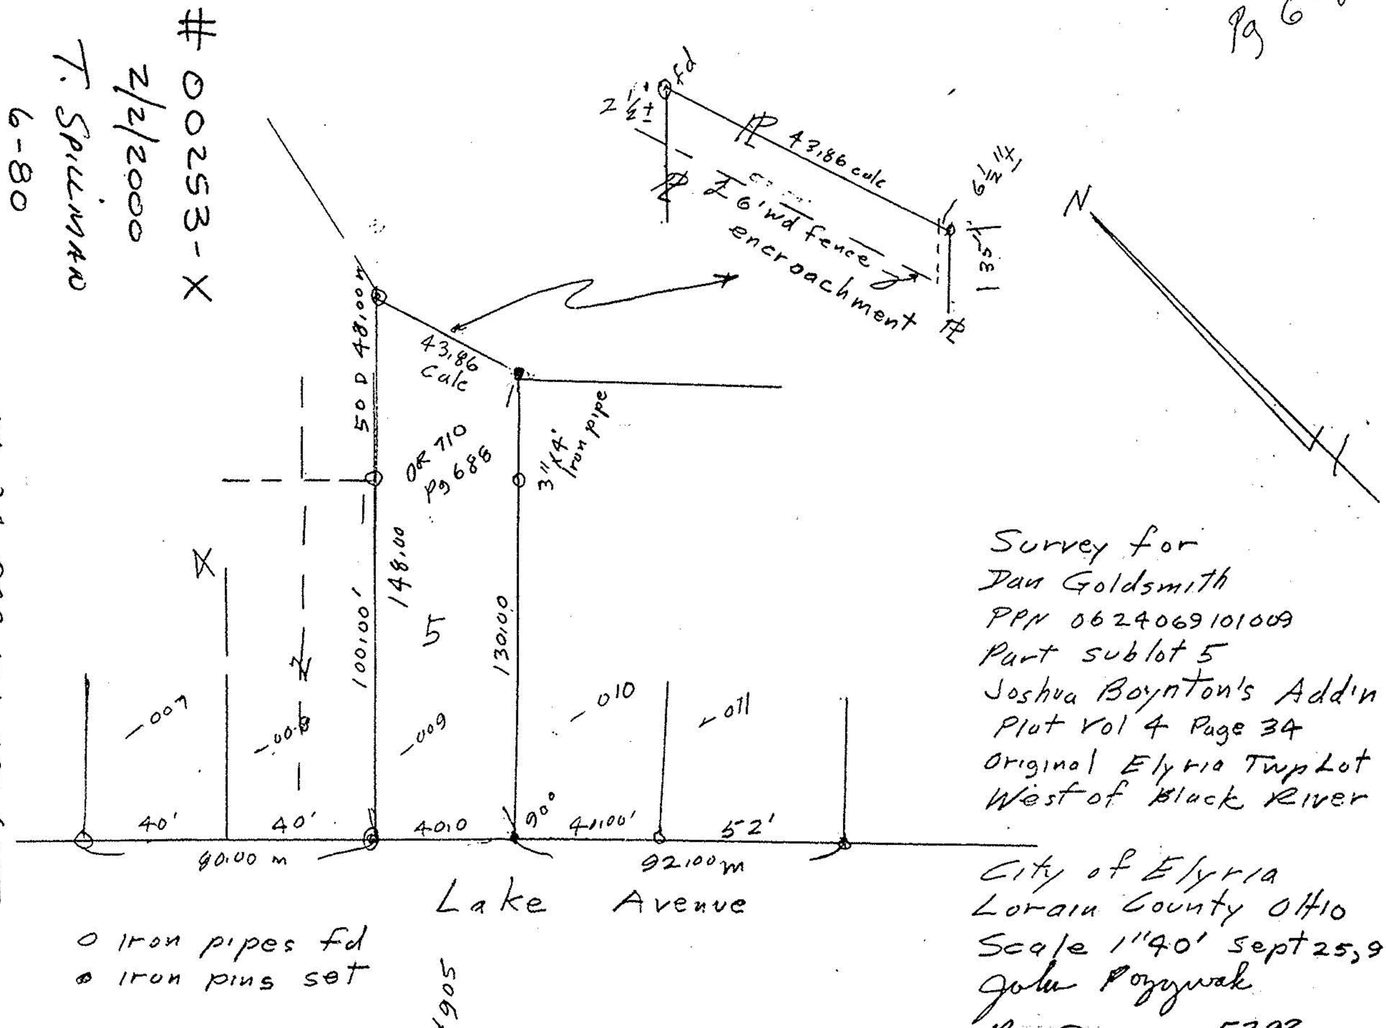

06-24-069-101-003 to 007

o iron pipes fd

● iron pins set

#9005

Survey for
Dan Goldsmith
PPN 06240691010 09
Part sublot 5
Joshua Boynton's Addn
Plat Vol 4 Page 34
Original Elyria Twp Lot 69
West of Black River

City of Elyria
Lorain County OHIO
Scale 1"=40' sept 25, 99
John Pozywak
Reg Surveyor 5292