


Township ELYRIA
 Orig. Lot(s) 123
 County of LORAIN
 Corporation _____

Track WEST OF BLACK RIVER
 Soc. State of Ohio
 APPROVED
 LORAIN CO.
 MAP DEPT.

Subject(s) 10 & 11
 Subd'n TATTERSALL'S SUBD.
 P.V. 7 P. 26.

DATE 12-3-80
 PAGE 6-100
 BY Carol Lynn
 VOID AFTER 13955

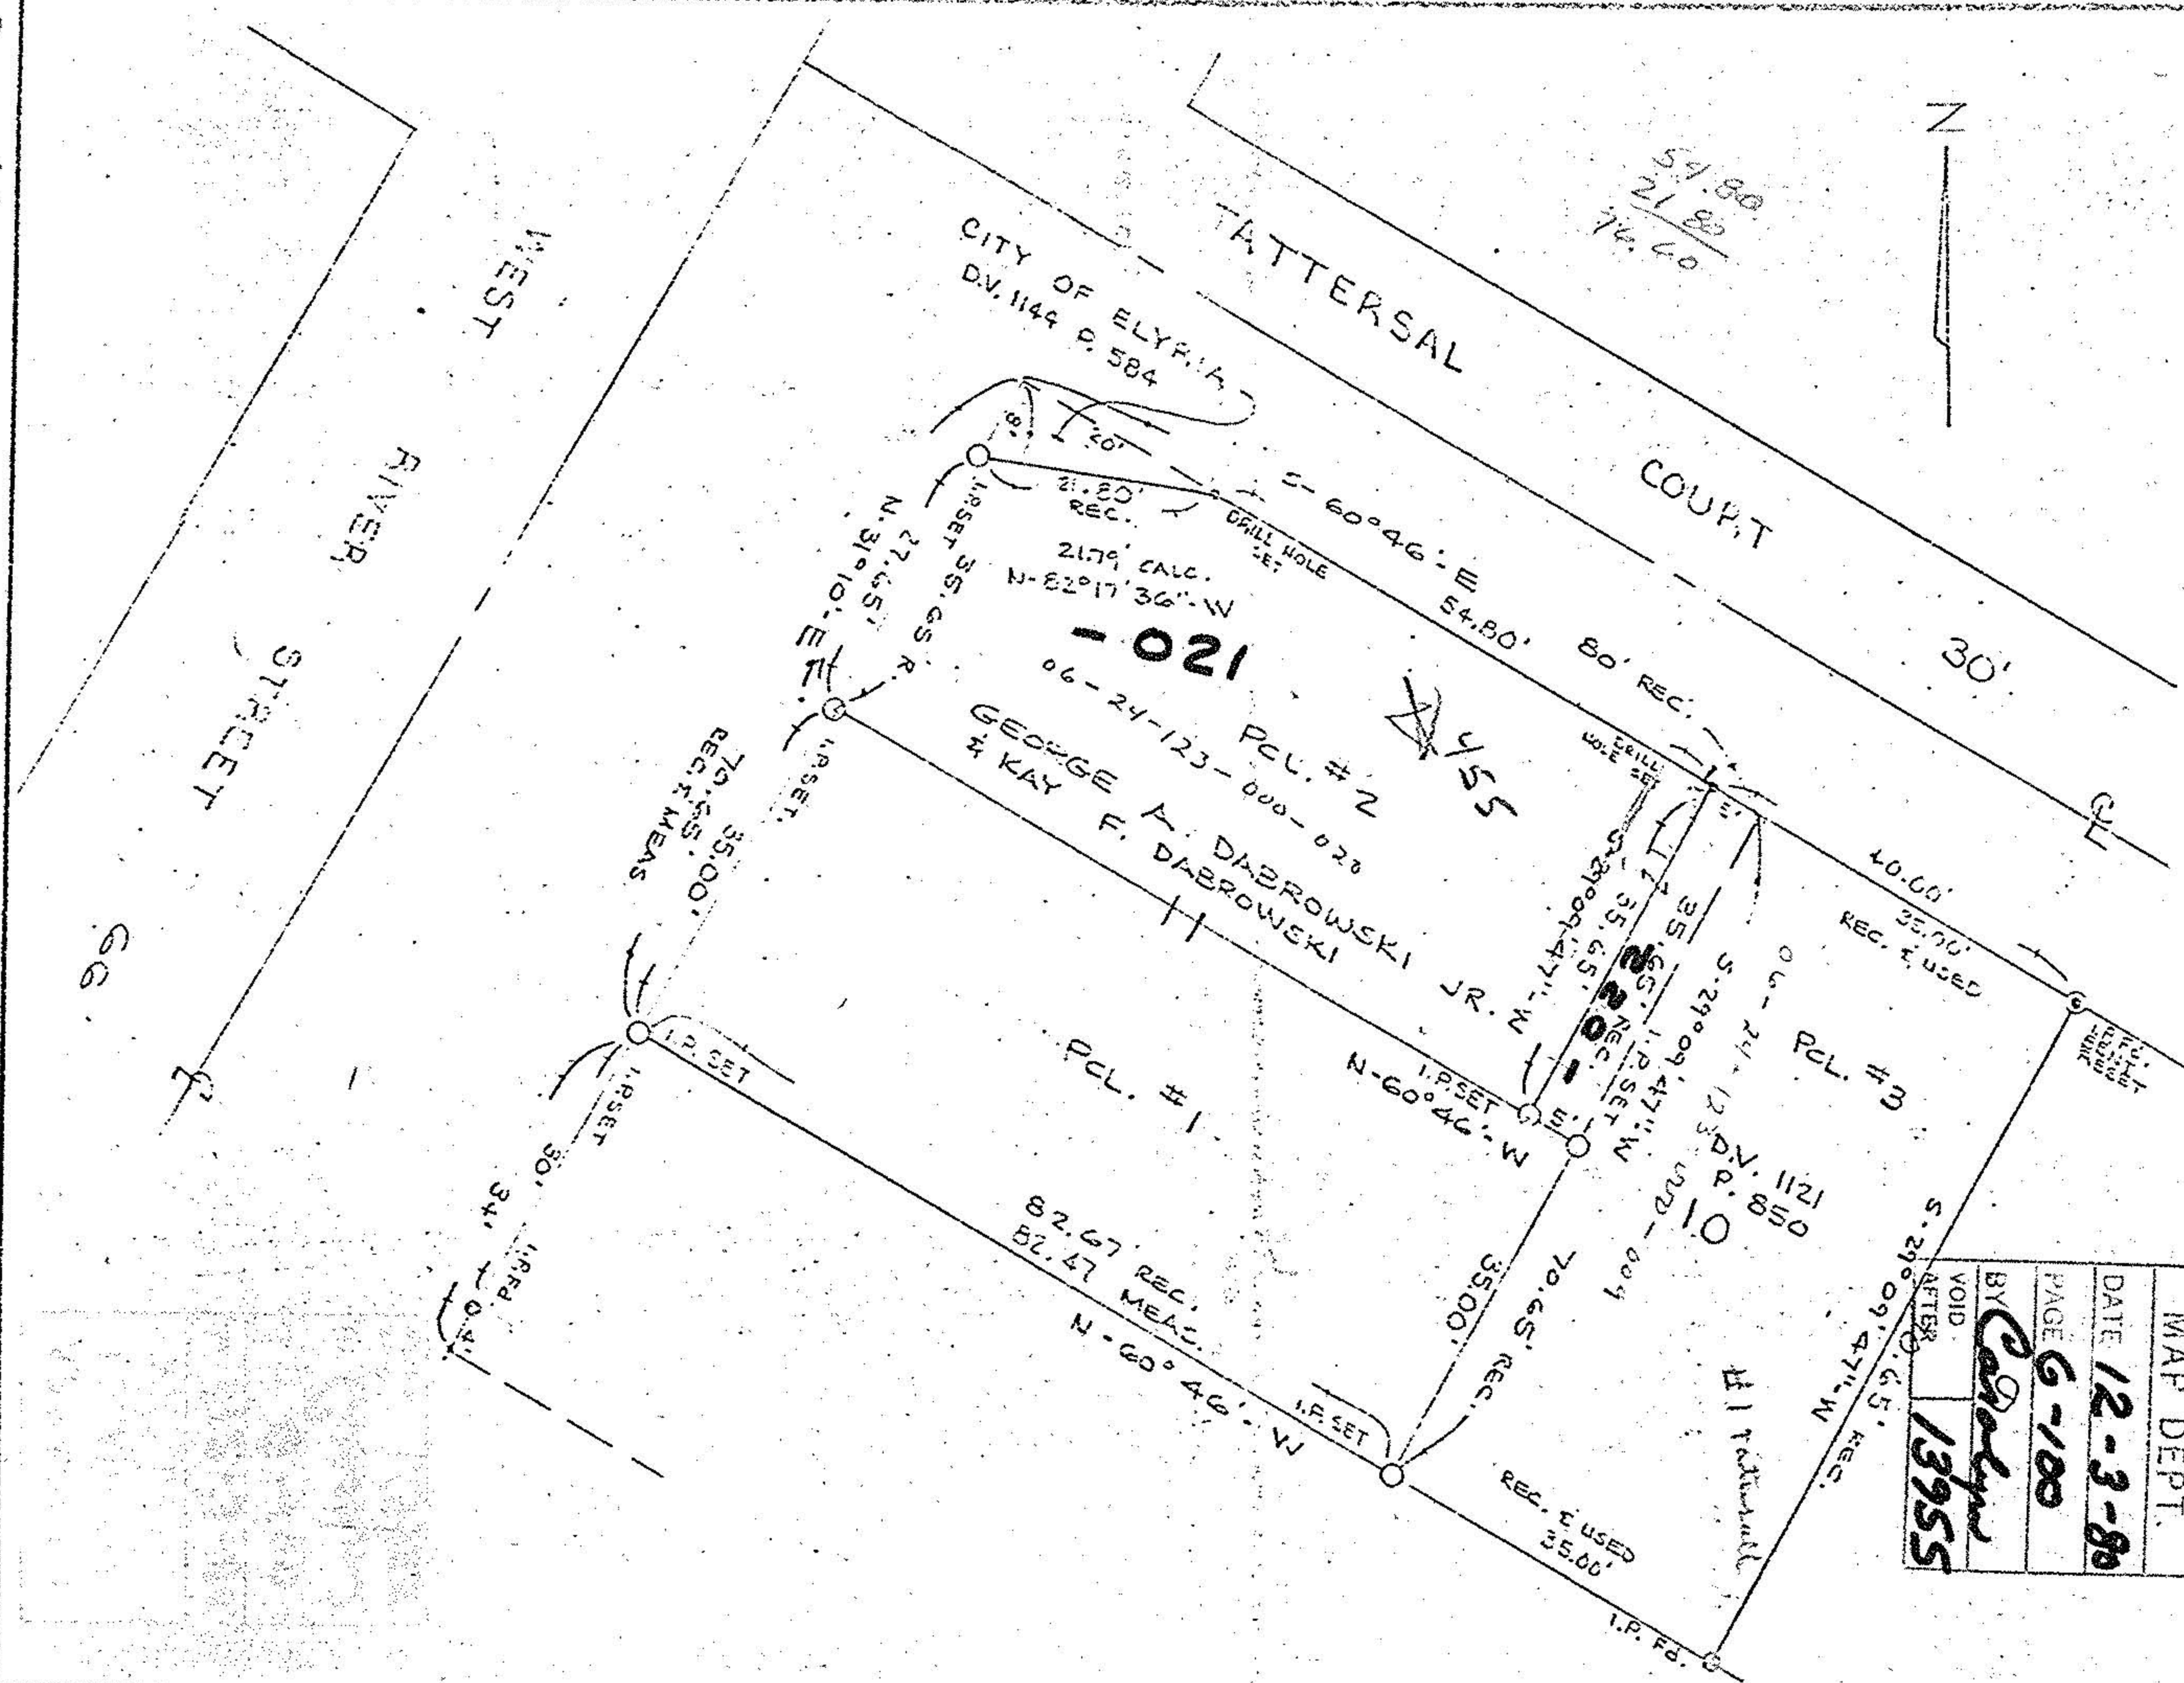

Prepared for: GEORGE DABROWSKI
 529 EAST ST.
 AMHERST, OH.

Scale: 1" = 20'
 Date: 9.25.78
 Dr. by: _____
 Job No 78-272