C 185 CG C-1-C1

-010-(102)-029
-031

BOUNDARY SURVEY OF PARCEL NUMBERS ON THIS PLAT

PART OF V.L.D. 0.4102

WEST OF PEARL ROAD

CITY OF BROOK PARK

COUNTY OF CUYAHOGA

STATE OF OHIO

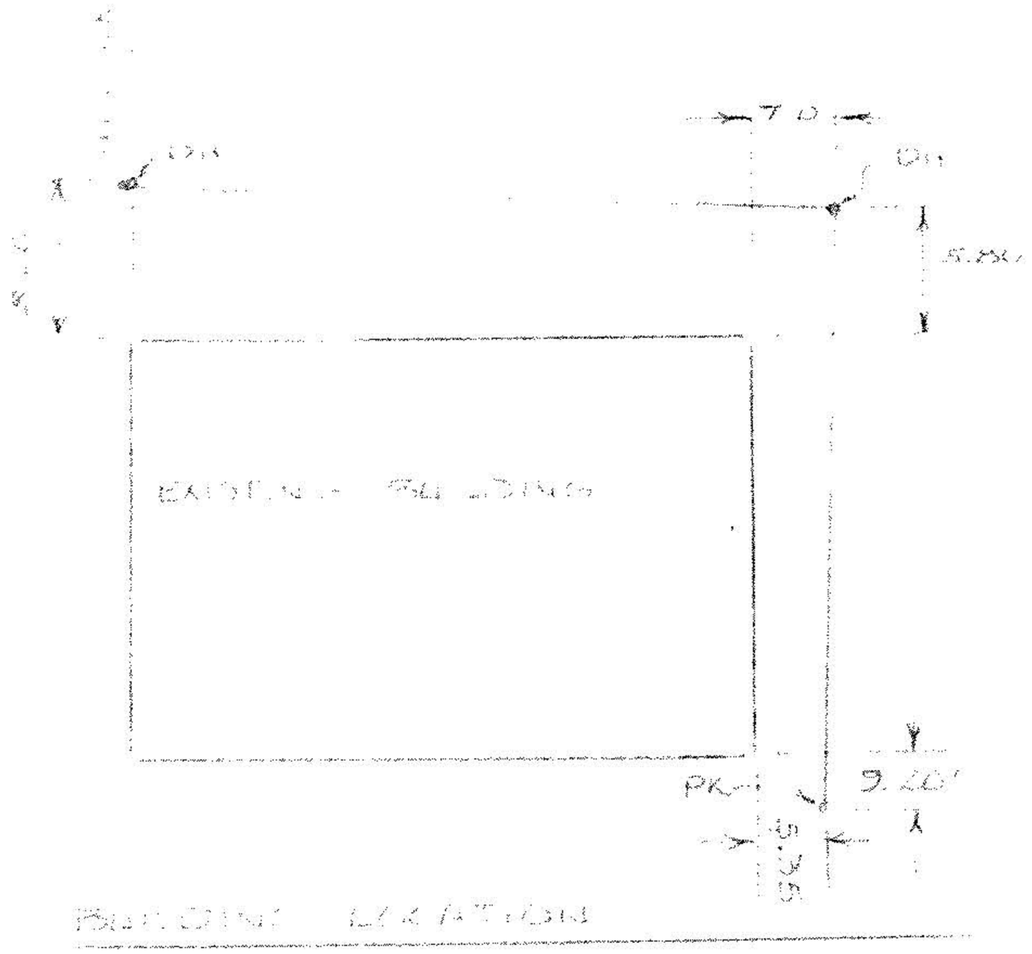

Carl R. Anderson

CARL R. ANDERSON P.S. #10582.

O.R. 94 P. 82

P.P. 06-24-009 102-011

2.84 ACRES

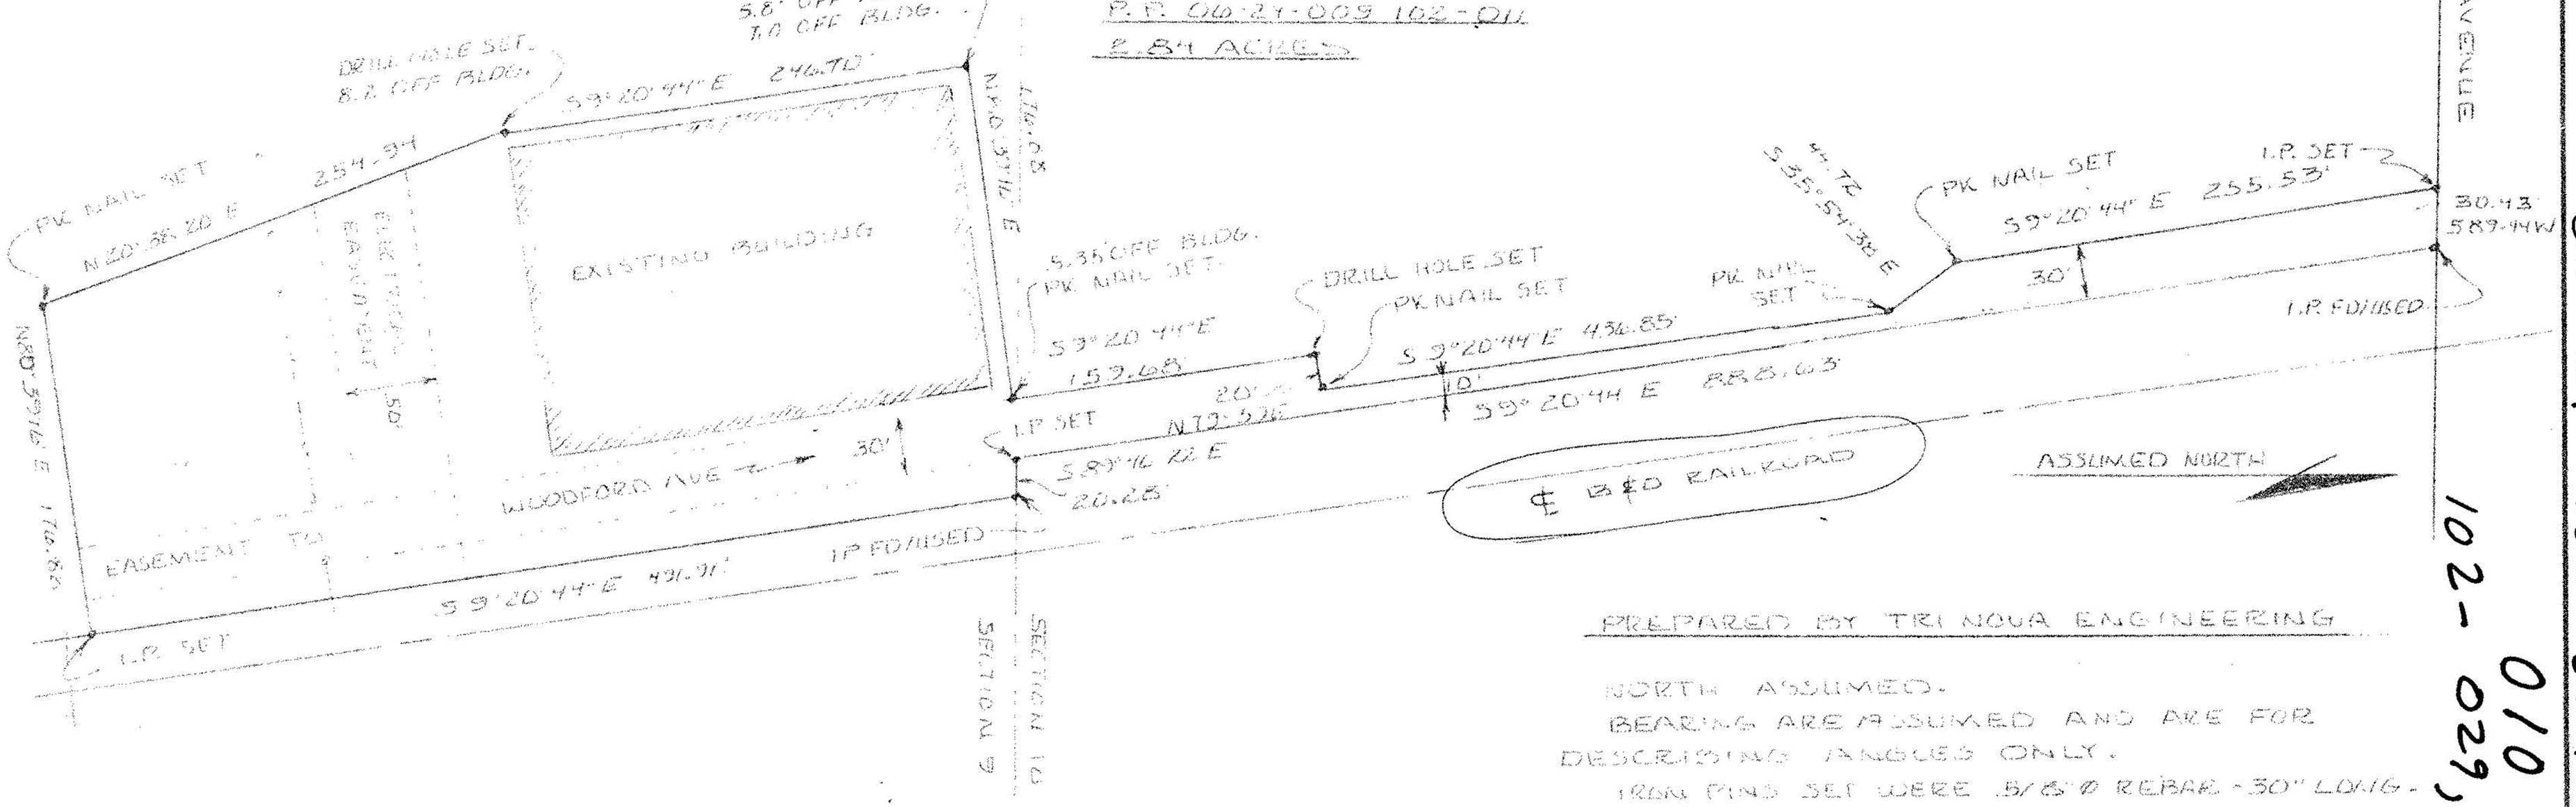

PREPARED BY TRI NOVA ENGINEERING

NORTH ASSUMED.
BEARINGS ARE ASSUMED AND ARE FOR DESCRIBING ANGLES ONLY.
IRON PINS SET WERE 5/8" Ø REBAR - 30" LONG - NOT TO SCALE.

WOODFORD AVENUE

06-24-102-009
102-010
029,031