

35° 10' 15" E

RD. 354.29

66

SHIRLEY


AVE. VACATED 676 - 33 1/4 60'

RIVER

SARANAC AVE. 50'

FORD

WEST

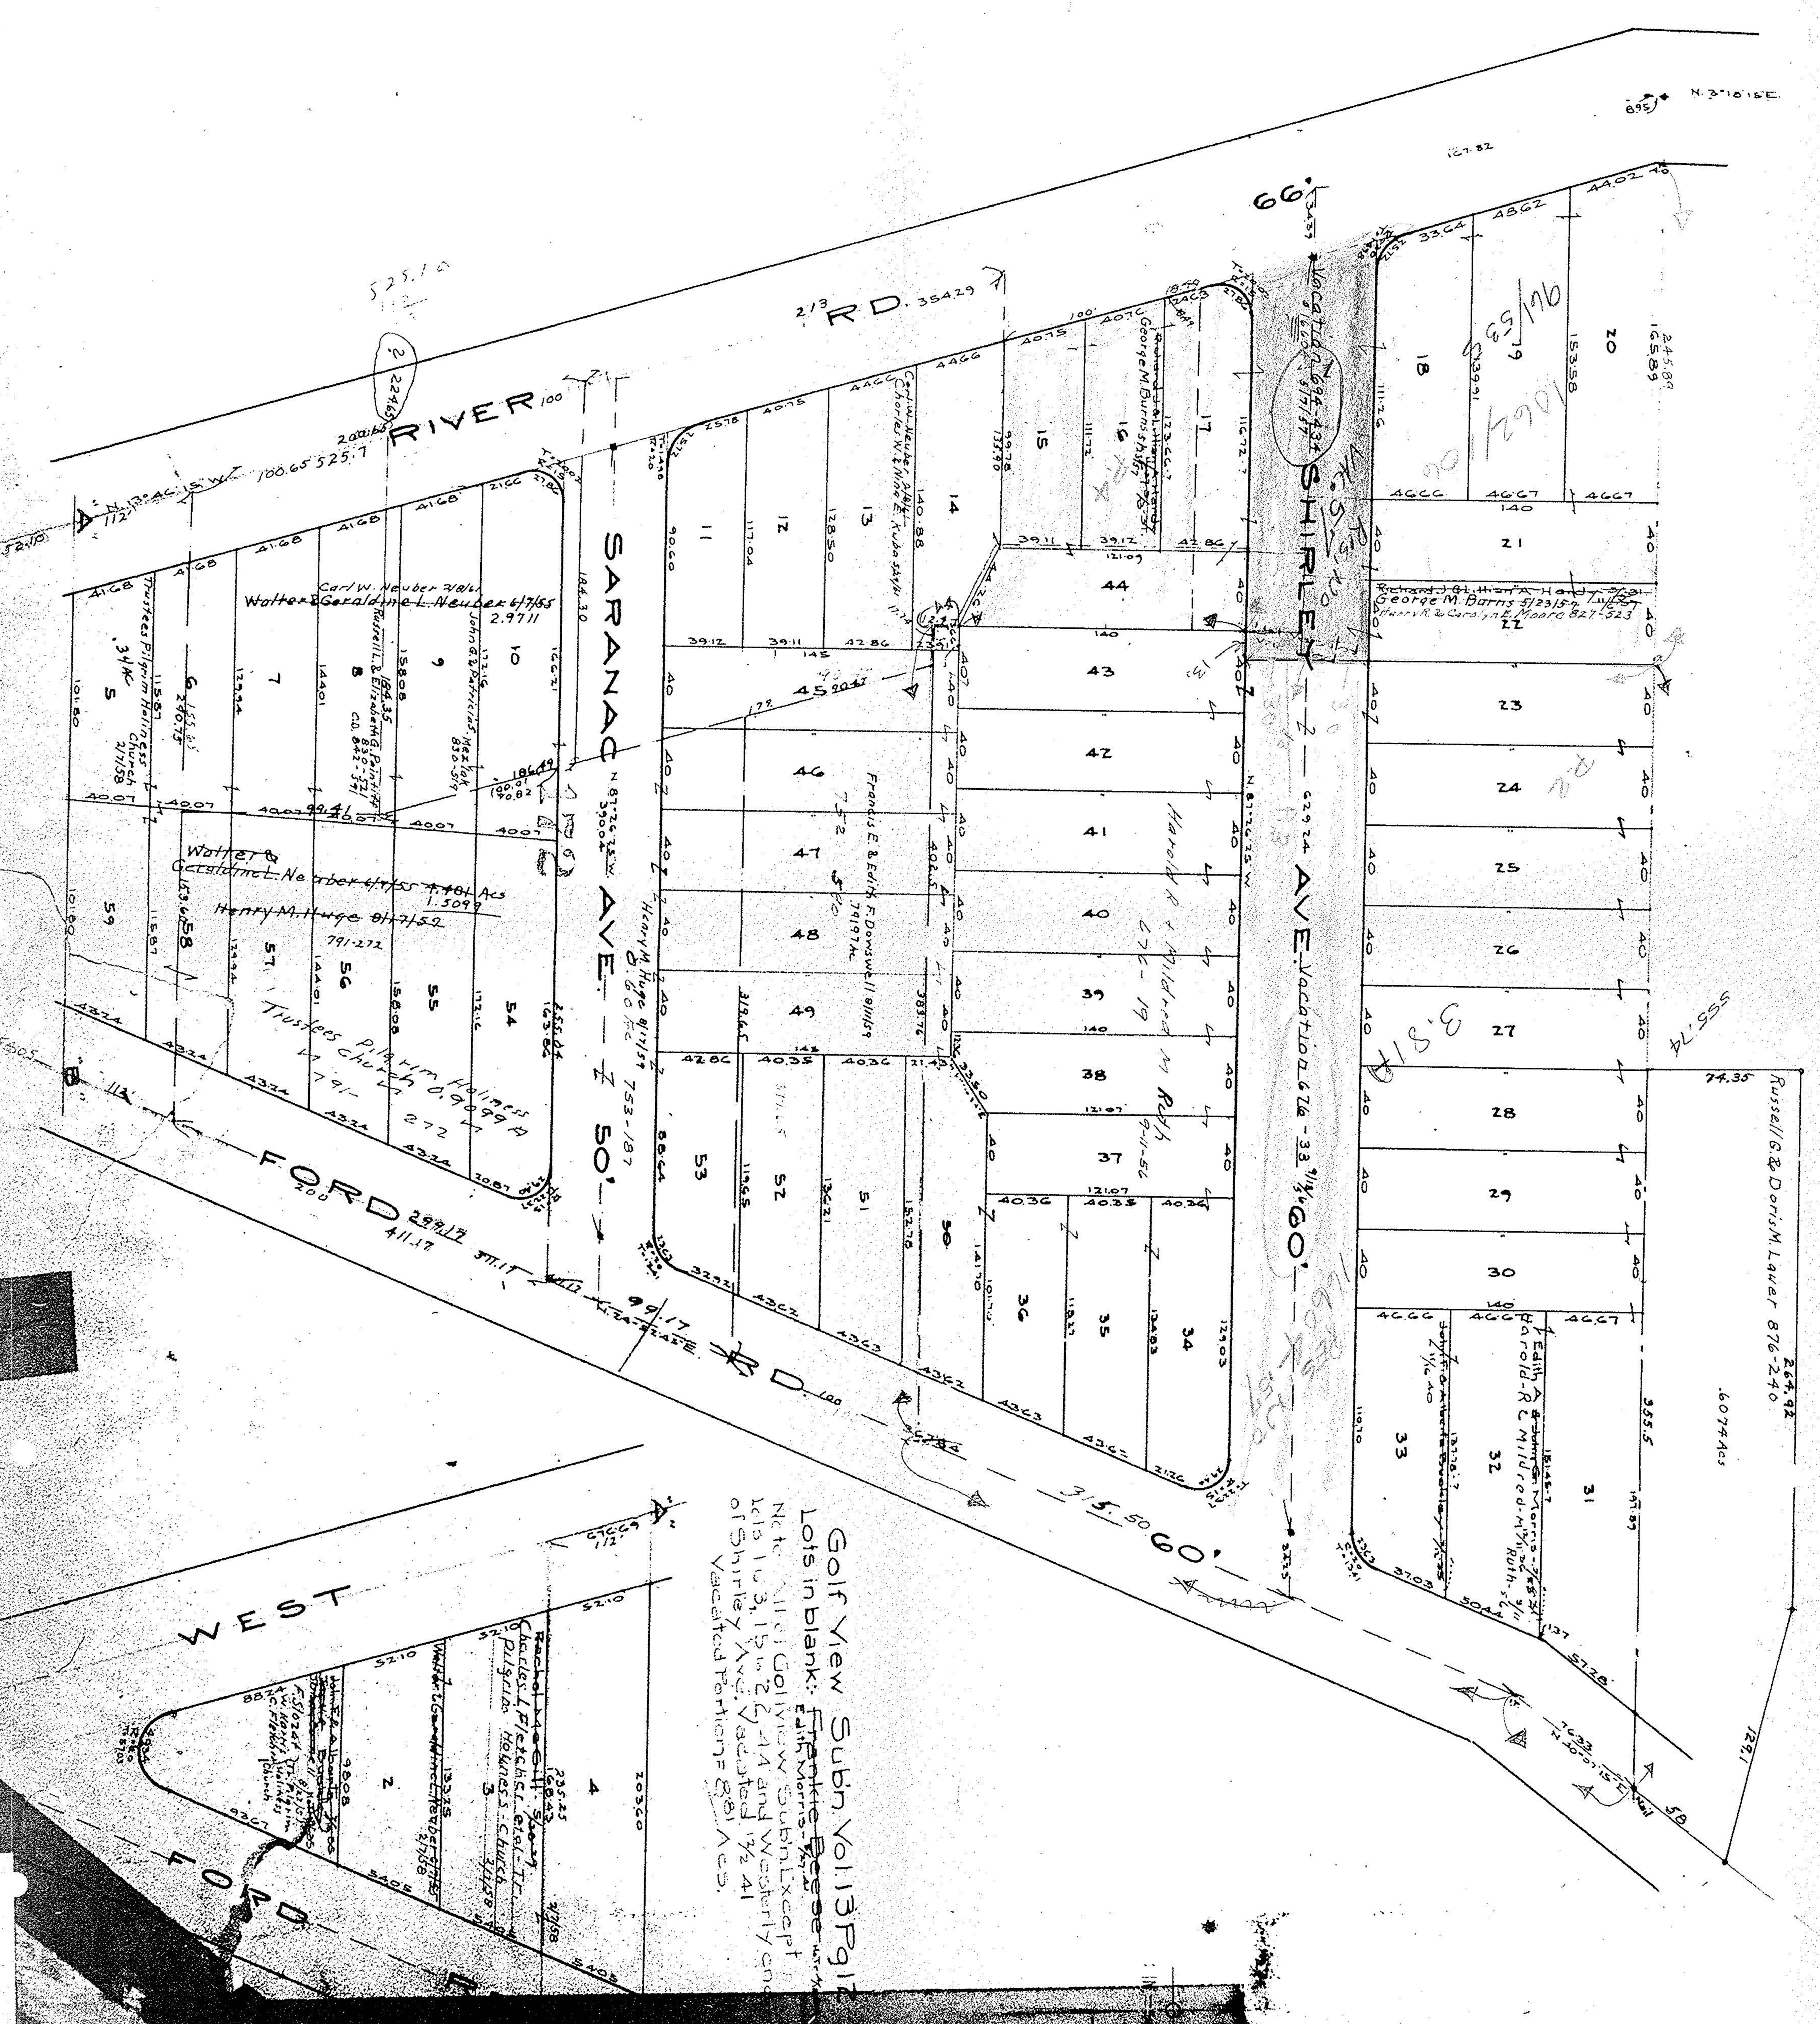

Golf View Subn. Vol. 13 Pg. 1
 Lots in blank: Edith Beebe, Ruth
 Edith Beebe, Ruth
 Note: All of Golfview Subn. except
 lots 1, 3, 19, 2, 21 and Westernly end
 of Shirley Ave. vacated 1/2 41
 Vacated portion 881 A.C.S.

