PRINTED
AUG 21 1991
KS ASSOCIATES, INC.

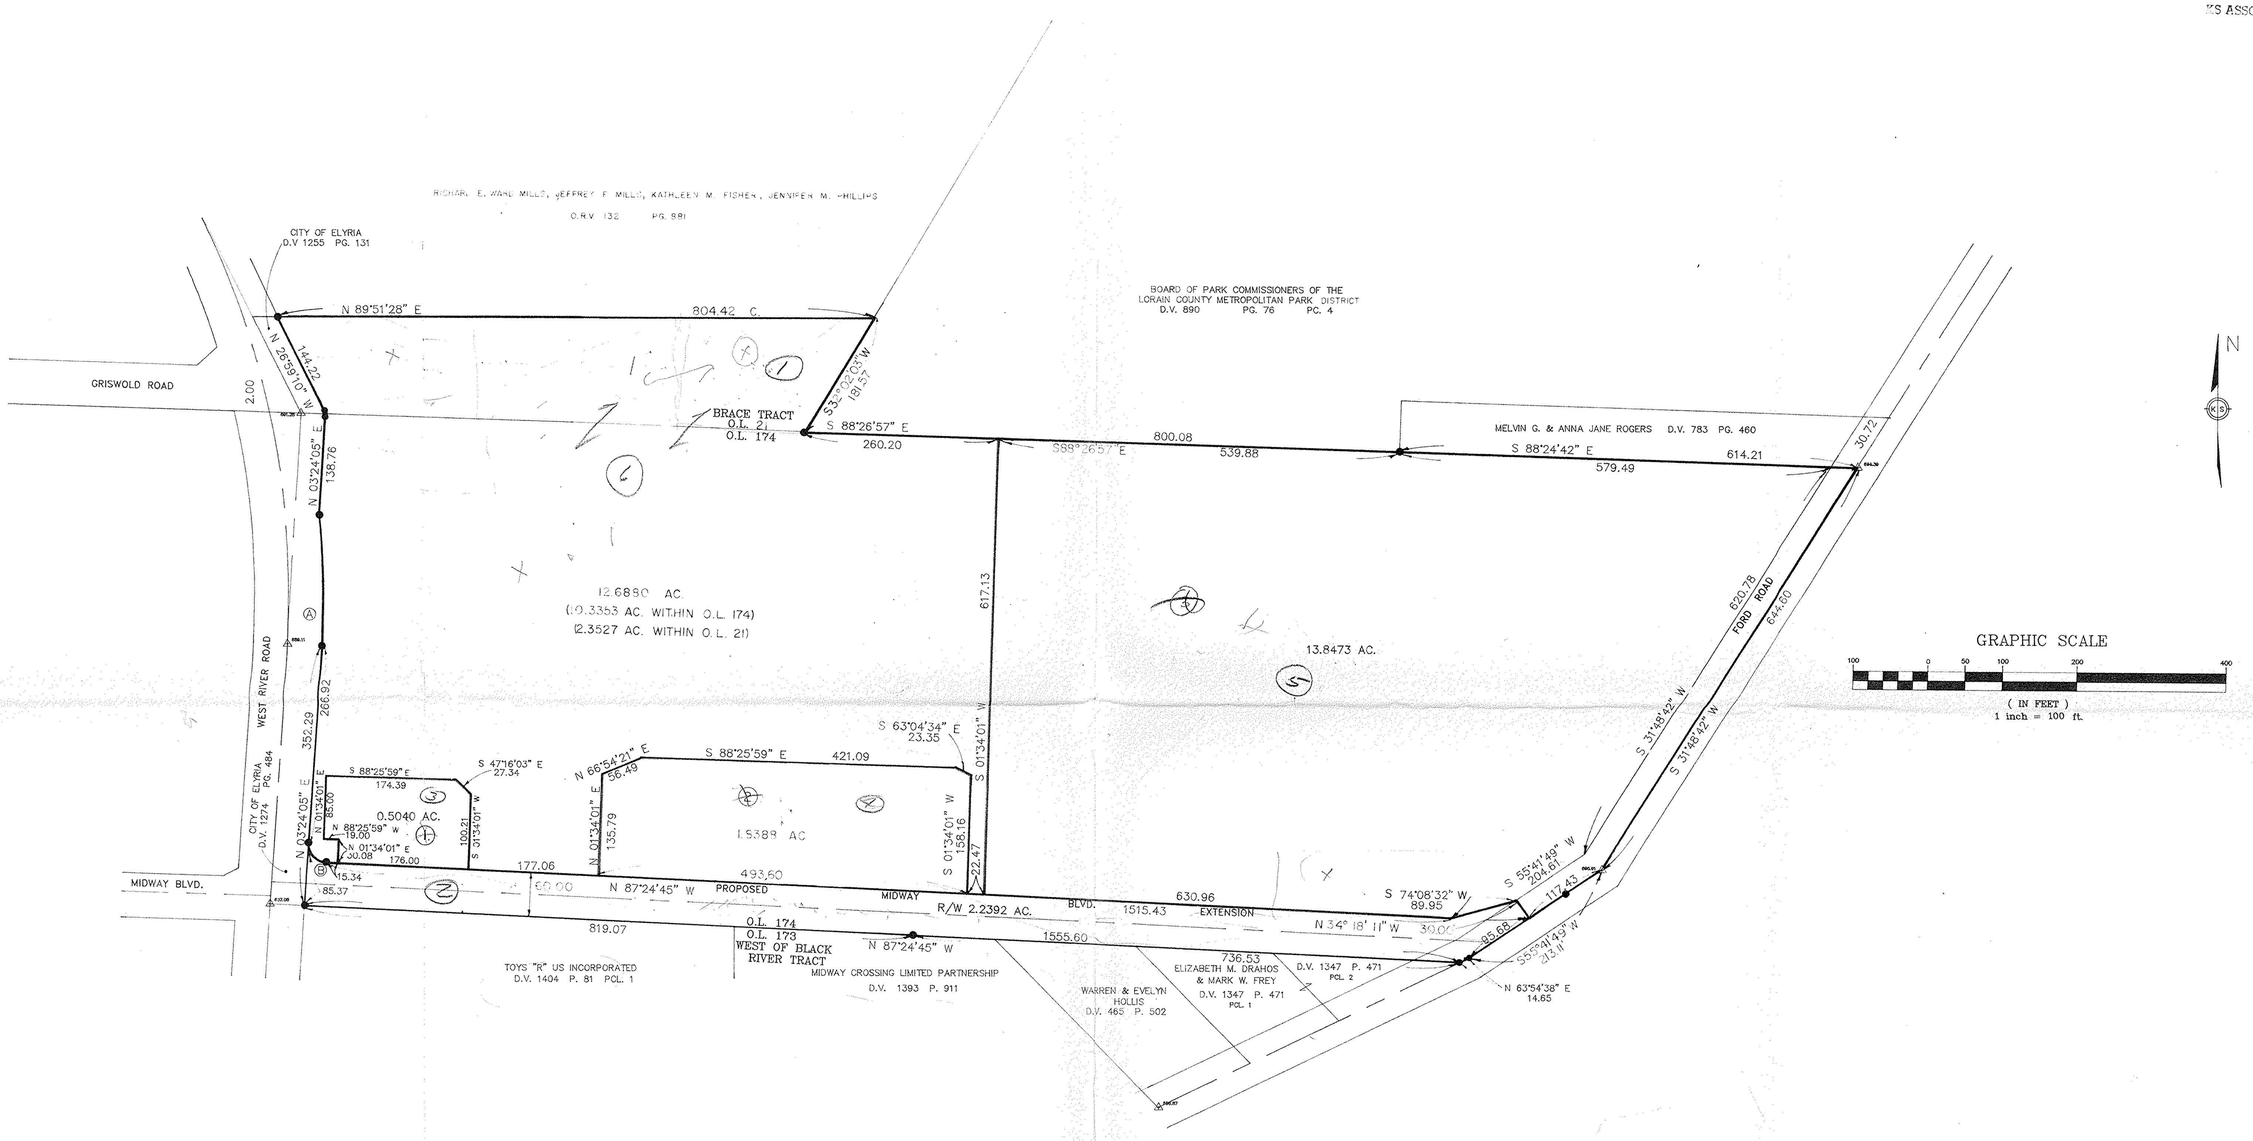

06-24-174-000-

CURVE	RADIUS	LENGTH	TANGENT	CHORD	BEARING	DELTA
A	1191.92	176.17	88.25	176.01	N 00°49'58" W	08°28'06"
B	25.00	39.63	25.36	35.61	S 42°00'20" E	90°48'50"

#19558
APPROVED
LORAIN CO.
MAP DEPT.
DATE 9-11-91
PAGE 6-47 6-48
BY CAROLYN FRANCIS
VOID AFTER # 19558

REVISIONS

SURVEY MAP

PART OF ORIGINAL LOT 174 WEST OF BLACK RIVER TRACT
PART OF ORIGINAL LOT 21 BRACE TRACT

CITY OF ELYRIA COUNTY OF LORAIN STATE OF OHIO

KS ASSOCIATES, INC.
ENGINEERS/SURVEYORS
424 Middle Avenue
P.O. Box 89
Elyria, Ohio 44036
ELYRIA (216) 322-6317 * LORAIN (216) 244-5757
ENGINEERS/SURVEYORS KS ASSOCIATES INCORPORATED

SHEET 1 OF 1
JOB NO. 91003X1