



KLEINOEDER · SCHMIDT

and ASSOCIATES

ENGINEERS — SURVEYORS — CONSULTANTS IN LAND PLANNING

ELYRIA · MORWALK · MEDINA

OHIO

SURVEY


Sublot(s) 10879

6-143

Subd'n 011

Township ELYRIA Tract EAST OF BLACK RIVER
 Orig. Lot(s) 1 & 7 Sec. _____
 County of LORAIN State of Ohio
 Corporation CITY OF ELYRIA

6-143 East of River (25)

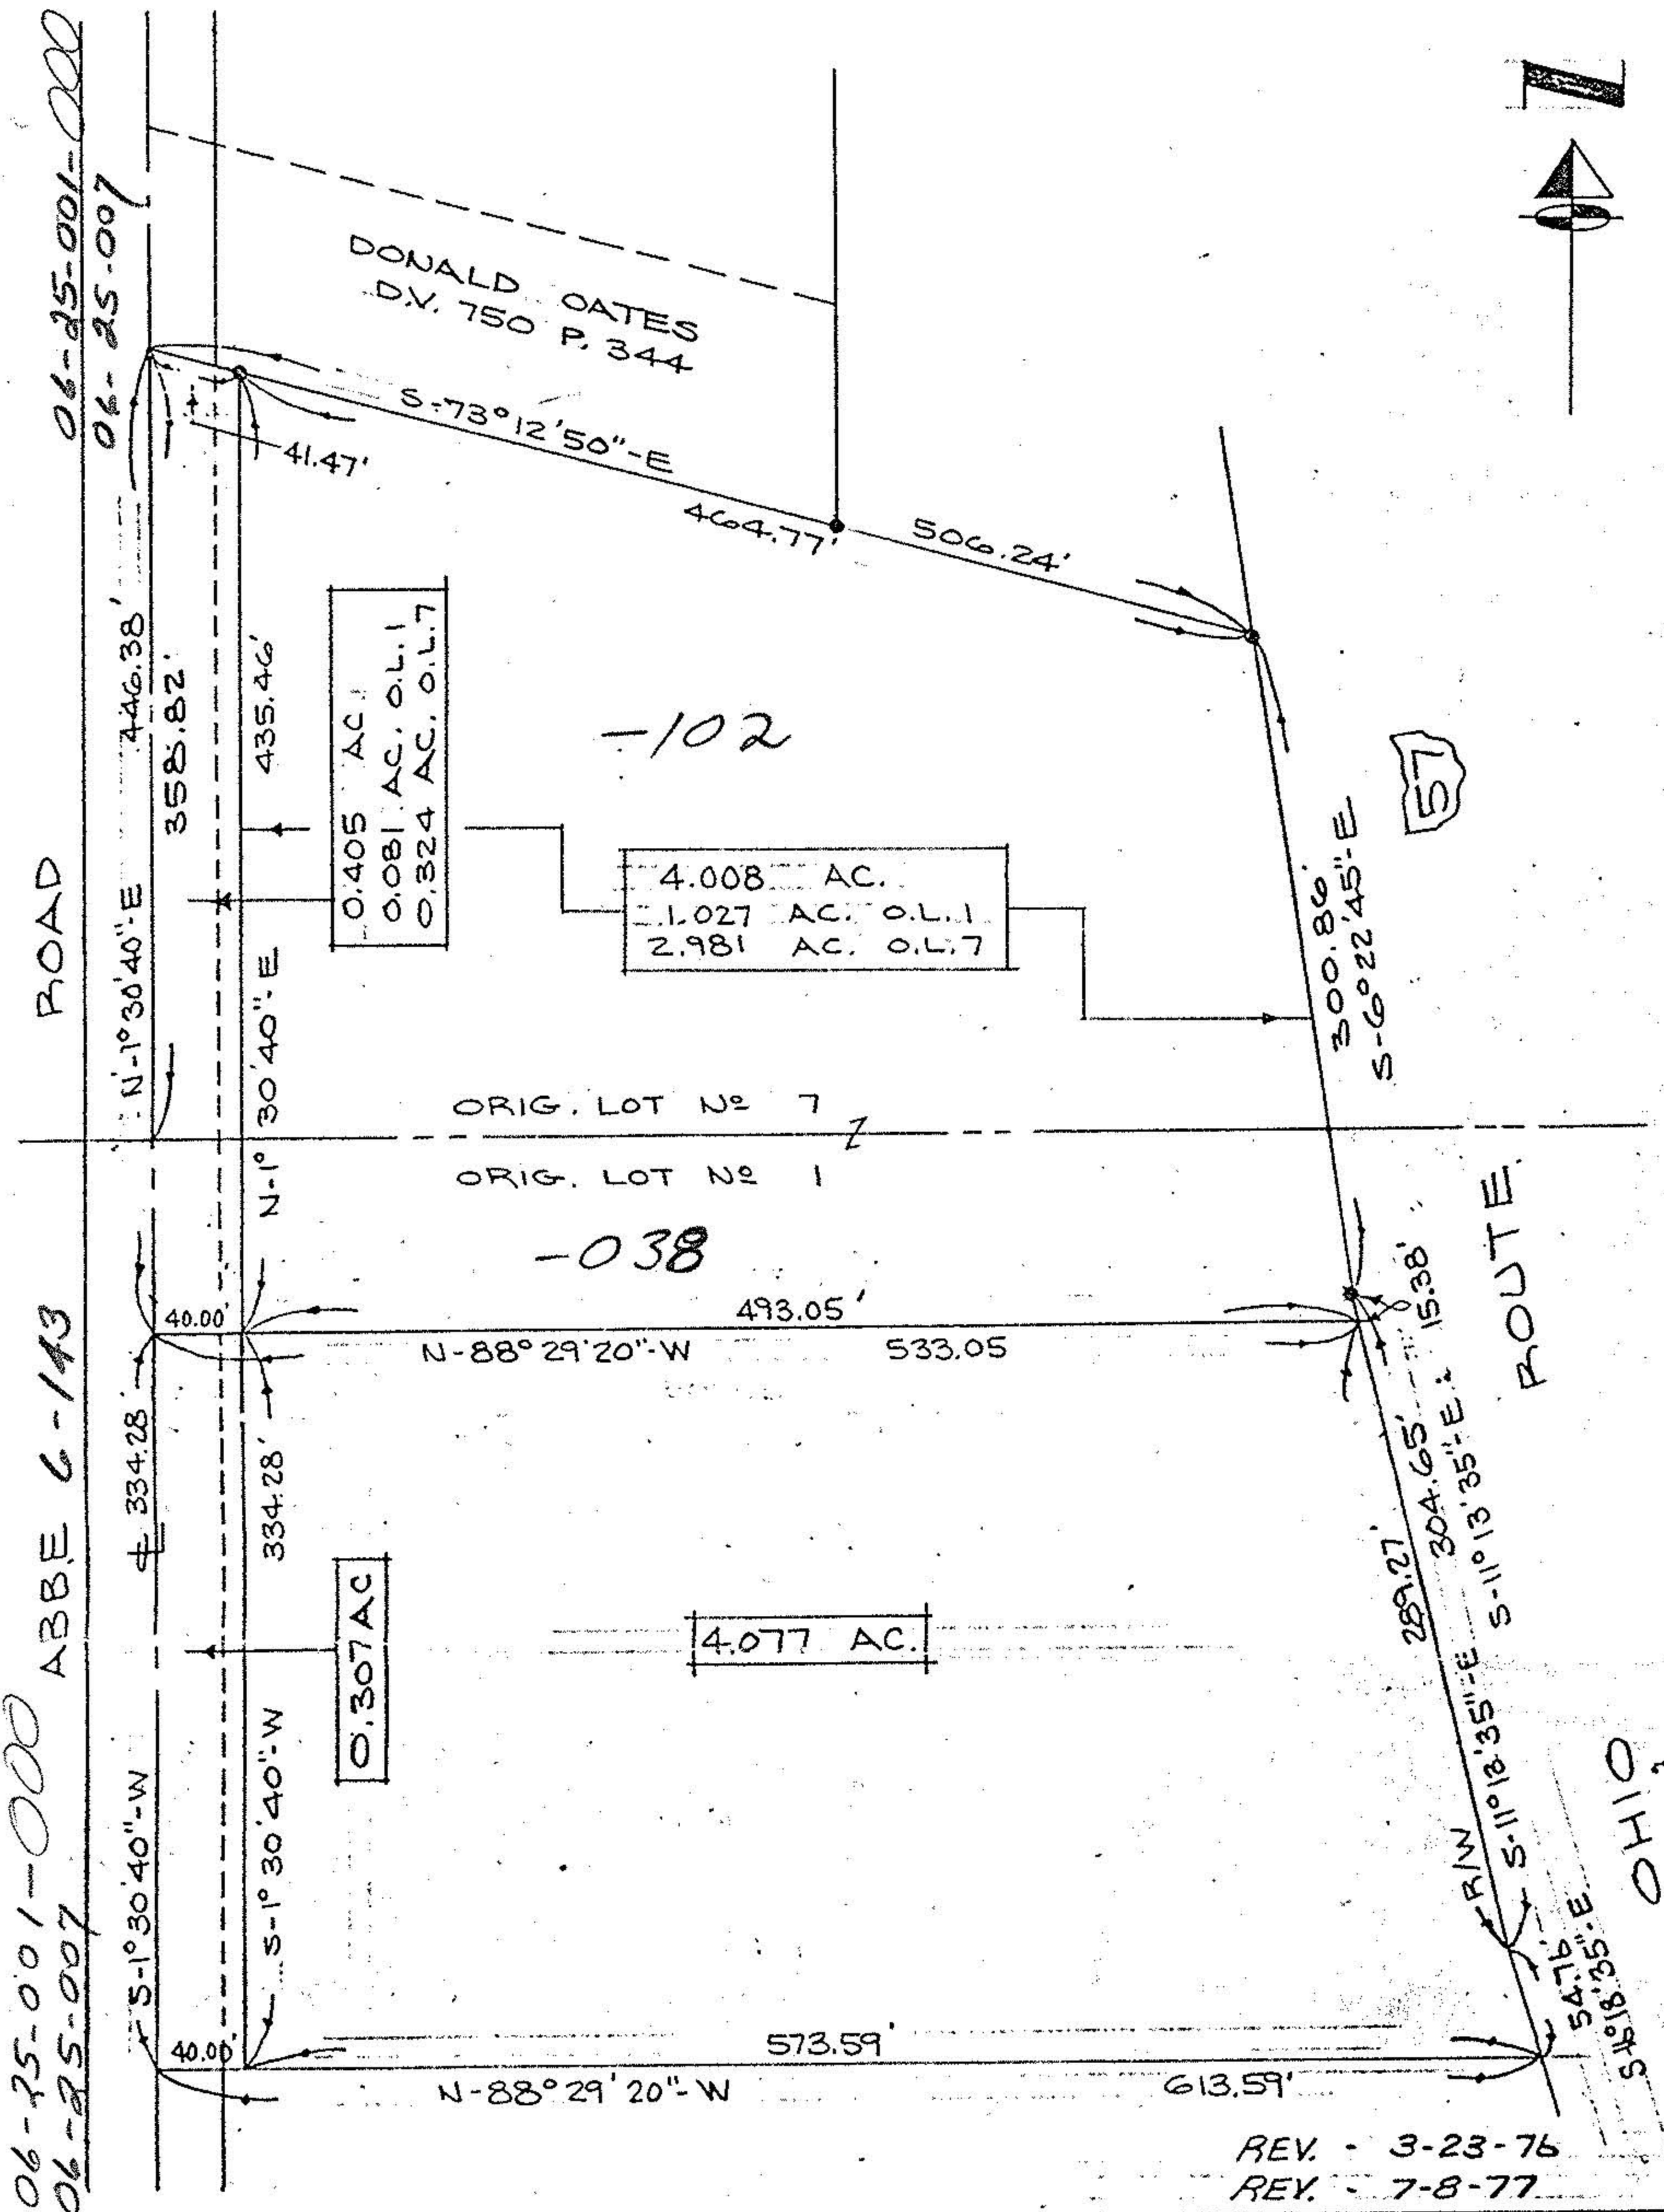

06-25-001-000
06-25-007

ABBE 6-143

REV. - 3-23-76
REV. - 7-8-77

Prepared for:	Scale: 1" = 100'	Date: MAR. 22 '76	Dr. by: <i>DE.</i>	Job No: 7219
---------------	------------------	-------------------	--------------------	--------------