6-142 #4540 06-25 006-132-133-

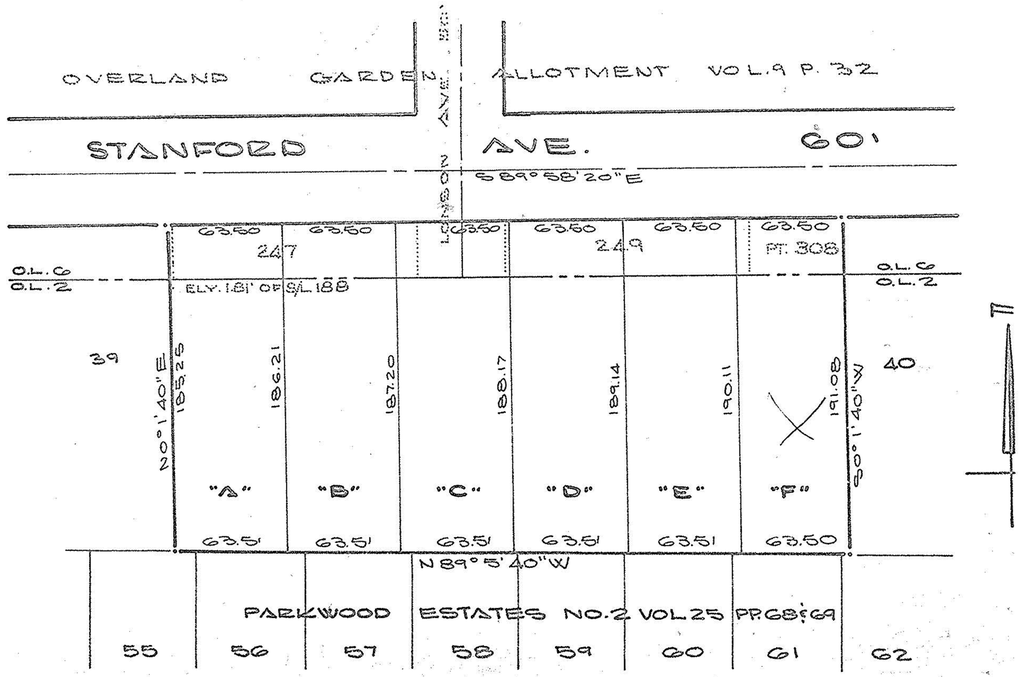
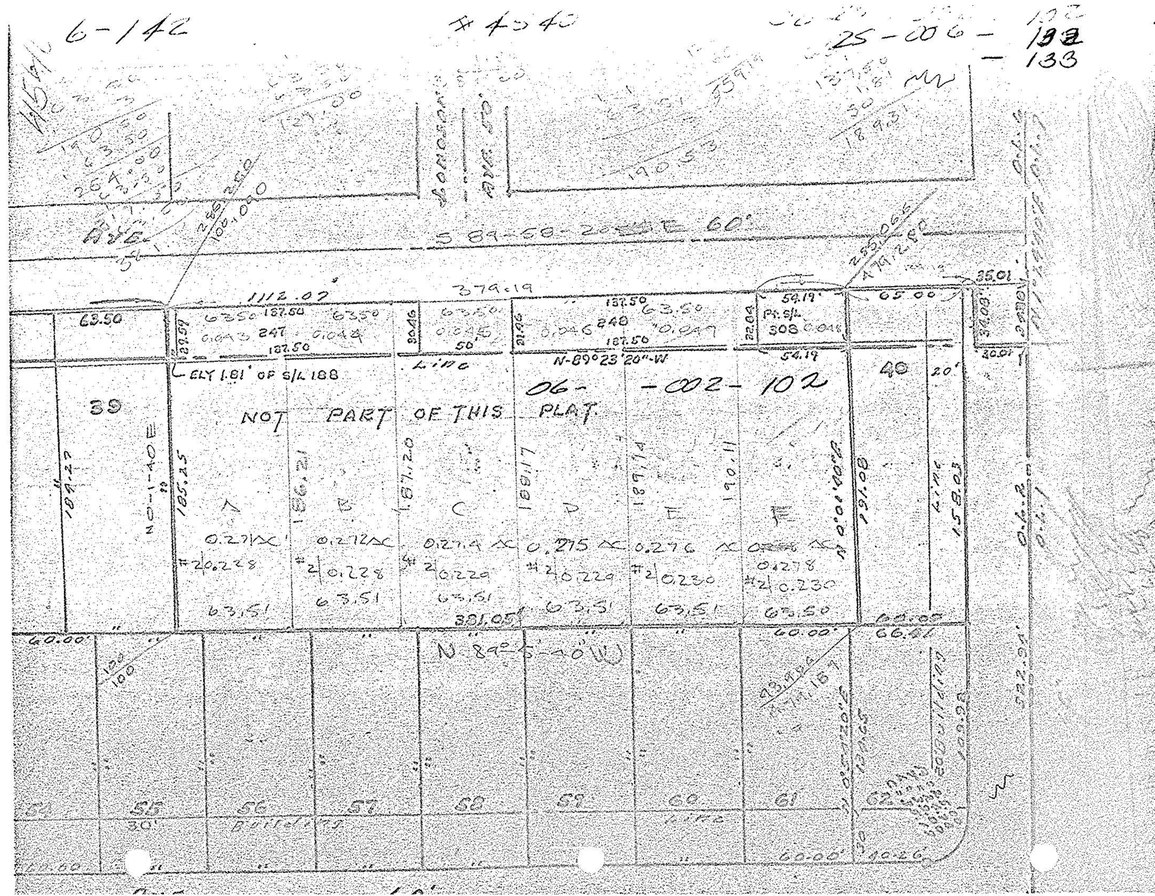
MAP PART OF
SUB LOTS 88, 247, 249, 308
LONSON AVE NOW VACATED
[illegible] GARDENS