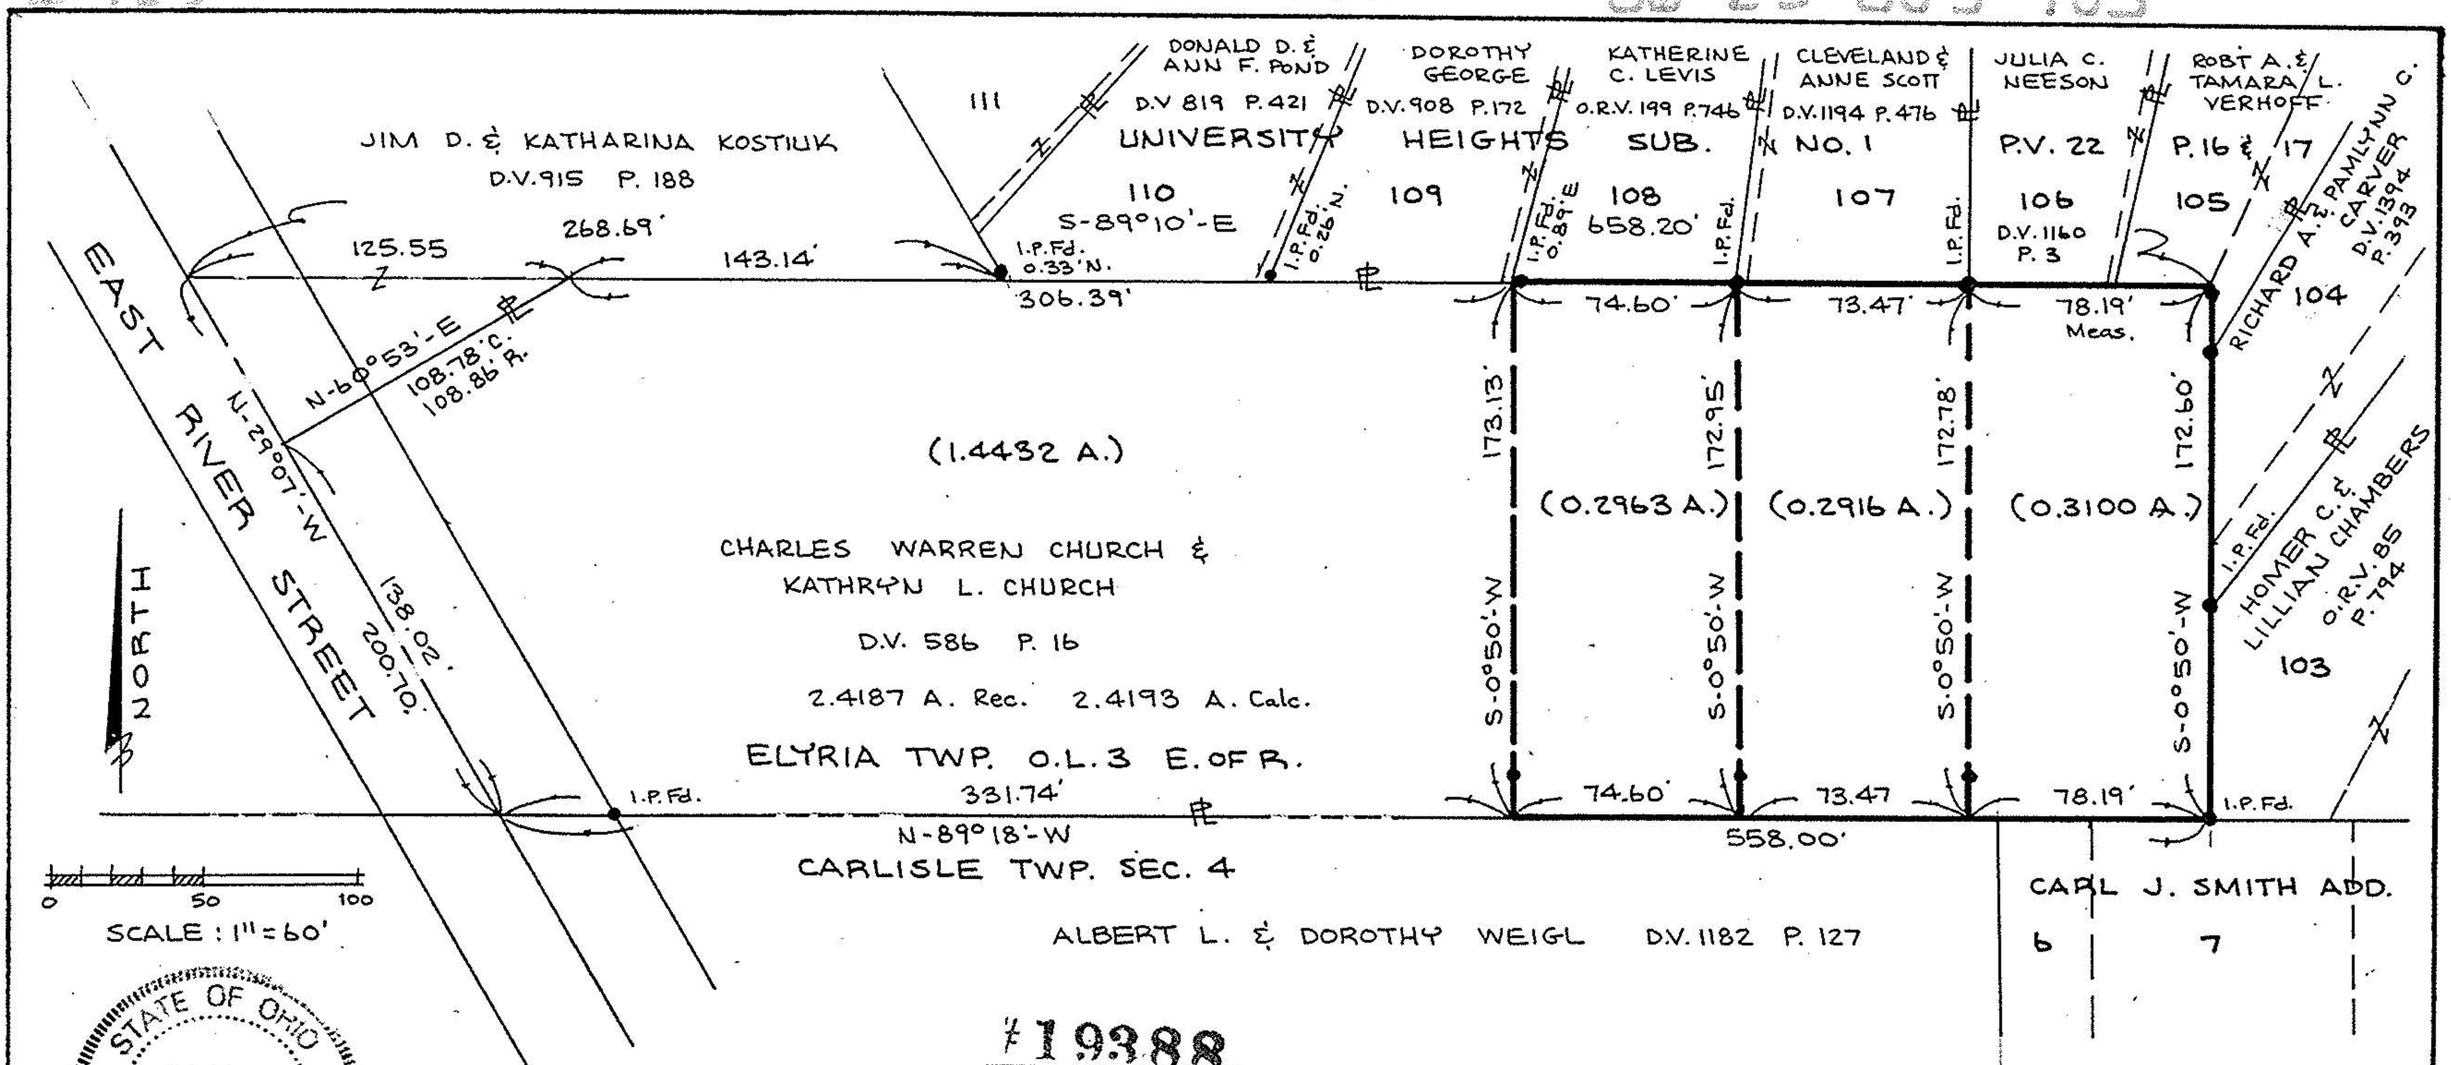

STATE OF OHIO
DAVID L. ELWELL
6333
REGISTERED SURVEYOR

David L. Elwell
DAVID L. ELWELL
REG. SURV. NO. 6333
4-19-91

#19388

APPROVED
LORAIN CO.
MAP DEPT.
DATE 5-22-91
PAGE 6-139
BY CAROLYN FRANCIS
VOID AFTER # 19388

BOUNDARY SURVEY

PART OF ELYRIA TOWNSHIP ORIGINAL LOT 3
EAST OF RIVER
CITY OF ELYRIA COUNTY OF LORAIN STATE OF OHIO

PREPARED BY
KS ASSOCIATES INC.
ENGINEERS SURVEYORS

91-127