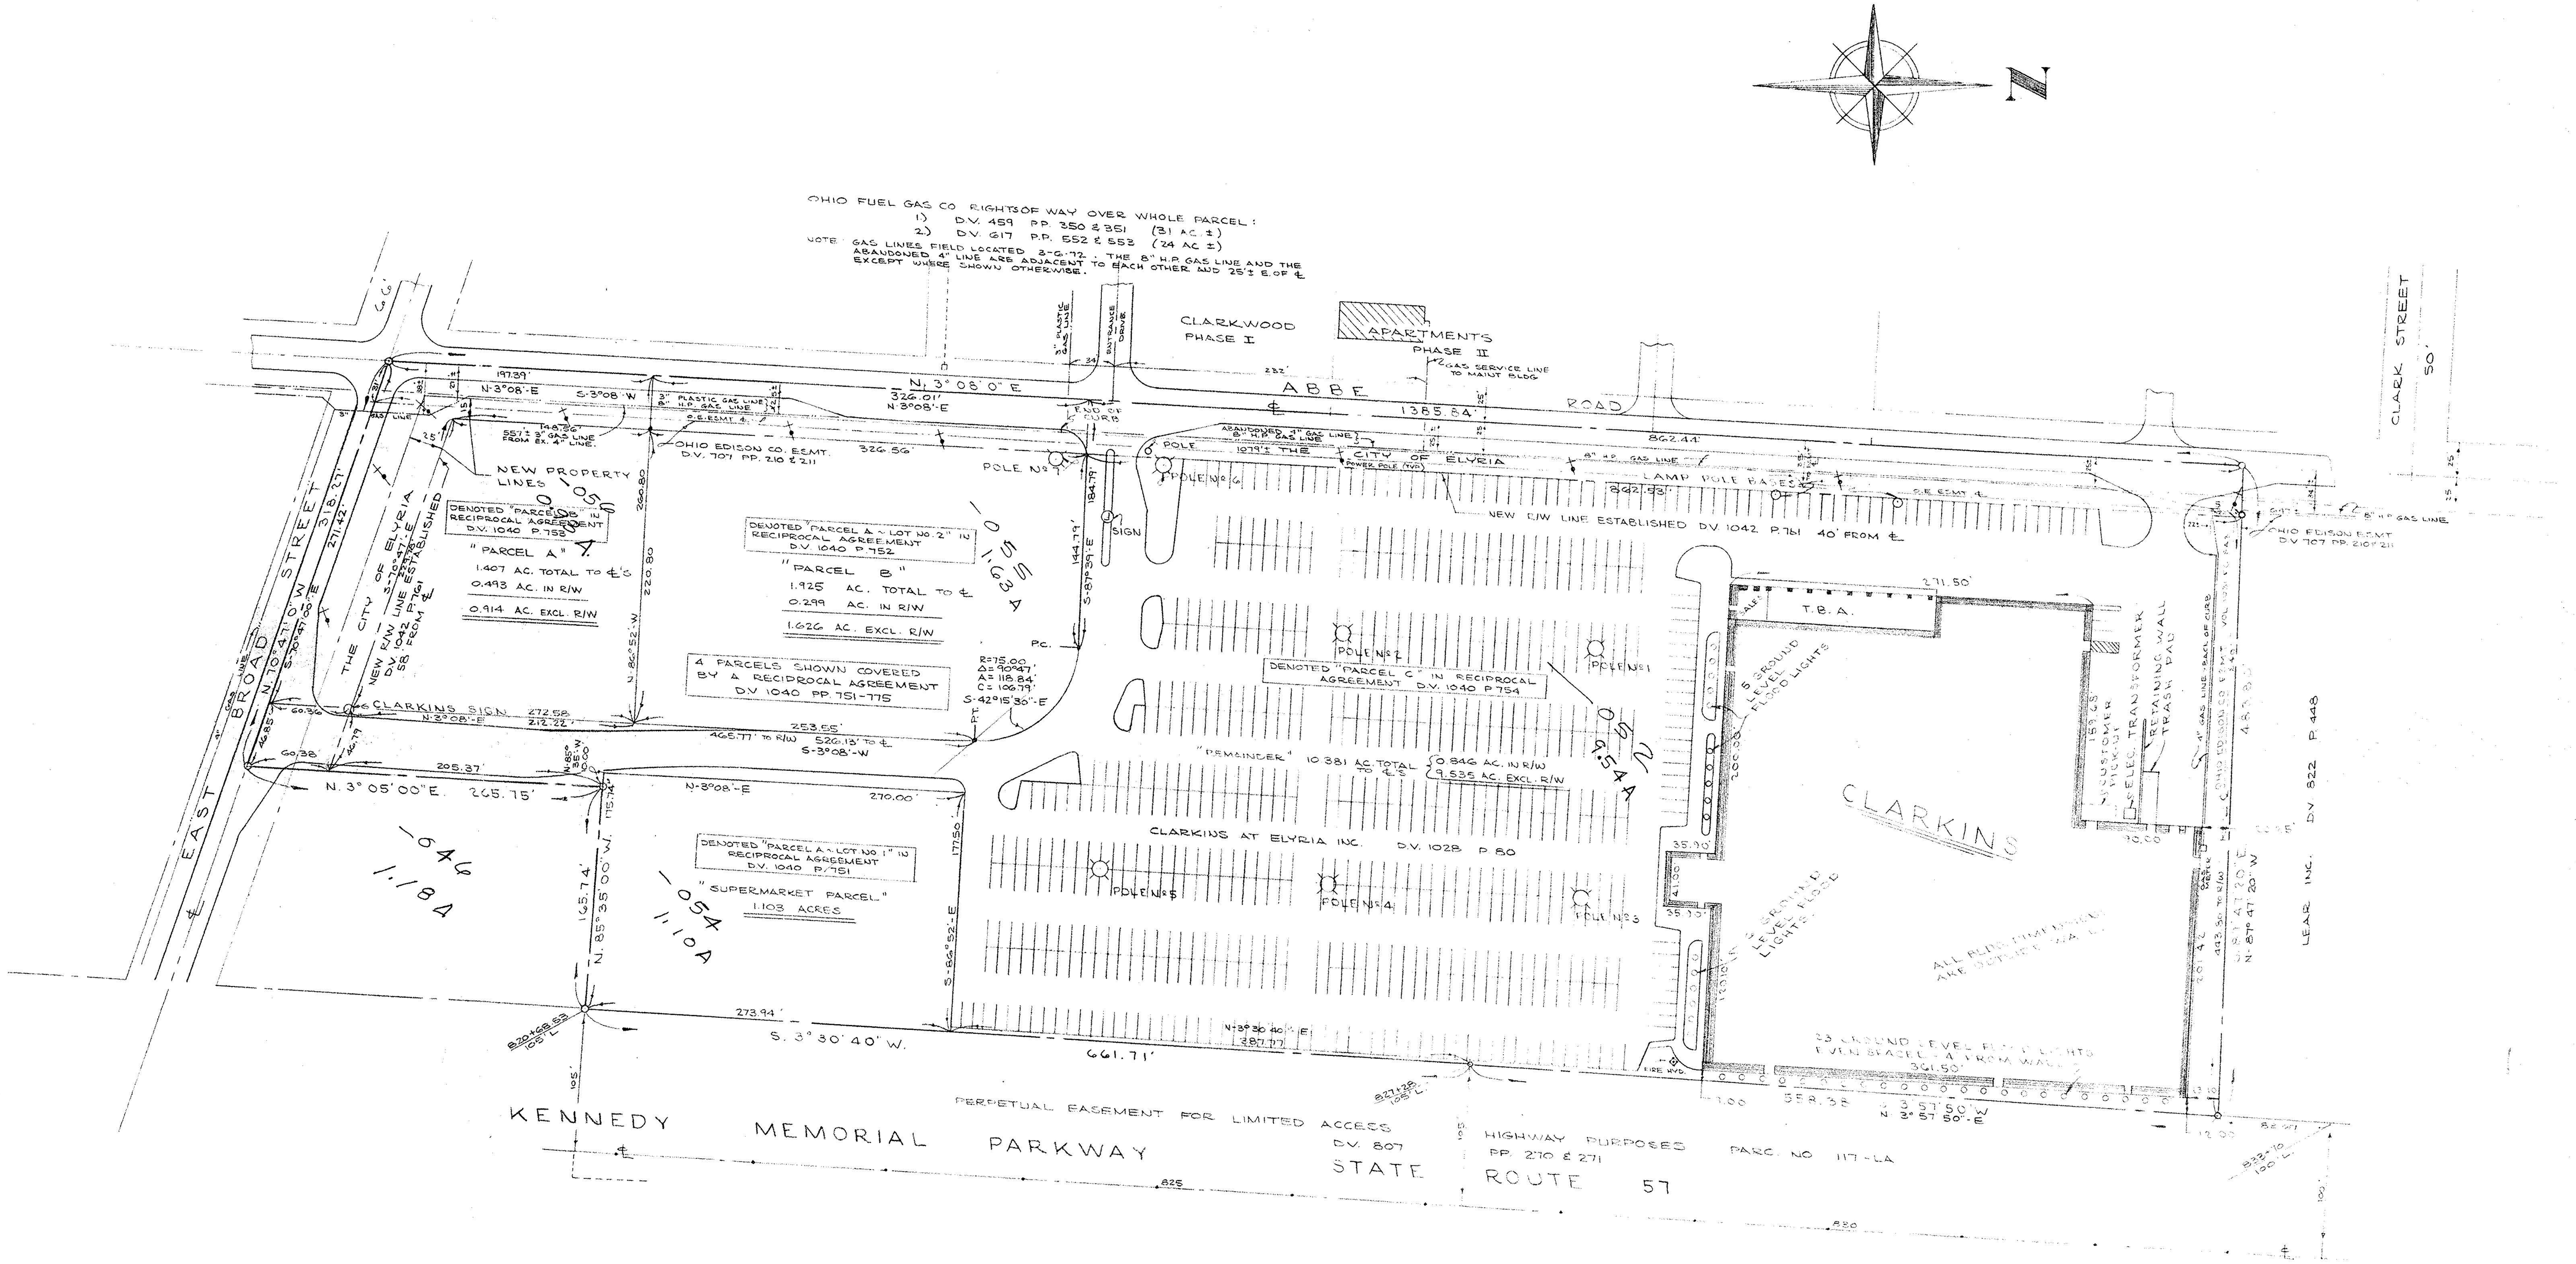

WE HEREBY CERTIFY THAT THIS SURVEY IS BASED UPON AN ACCURATE ONSITE SURVEY AND CERTIFIED TO BE CORRECT AND IS ISSUED IN THE INTEREST OF THE STATE OF WISCONSIN INVESTMENT BOARD, LAWYERS TITLE INSURANCE CORPORATION AND CLARKINS OF ELYRIA, INC.

James H. Schmidt

JAMES H. SCHMIDT
REGISTERED SURVEYOR

23.80
2.49
21.31

LOCATION SURVEY
CLARKINS/ELYRIA

PART OF
ORIGINAL ELYRIA TOWNSHIP LOT
Nº 7 EAST OF THE BLACK RIVER
COUNTY OF LORAIN STATE OF OHIO

SCALE: 1"=60'

DECEMBER 3, 1971
REVISED FEB. 18, 1972

PREPARED FOR
CLARKINS OF ELYRIA, INC.
ELYRIA, OHIO

PREPARED BY
JAMES H. SCHMIDT
REGISTERED SURVEYOR

REVISED: FEB. 18, 1972
REVISED MAR. 6, 1972

Tax Map Pg. 6-125