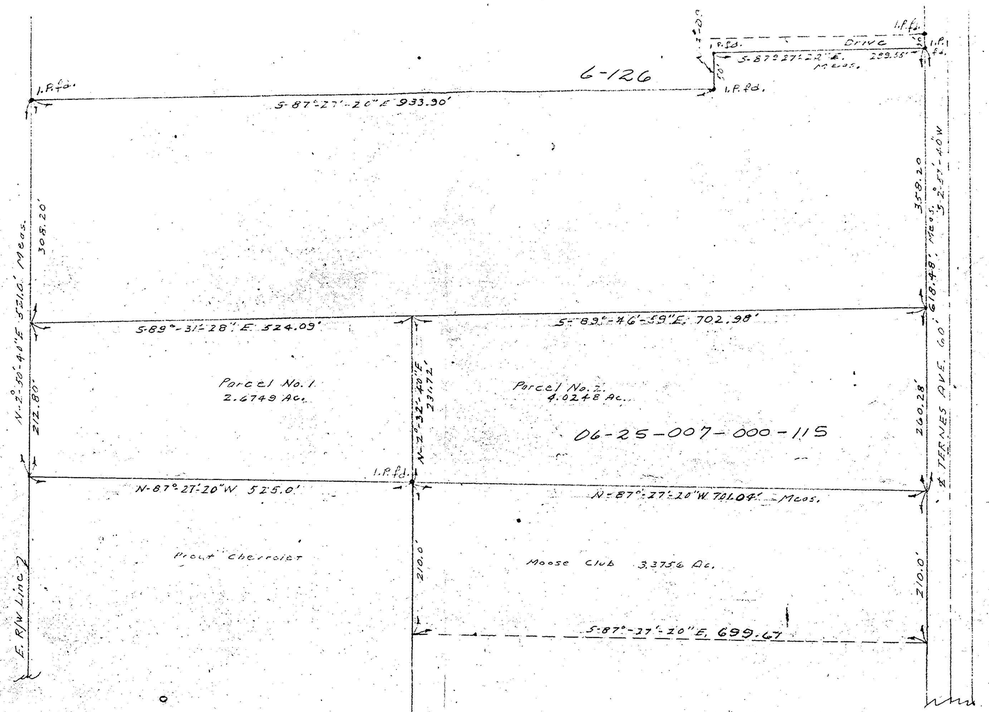

06-25-007-000-

SURVEY FOR HAROLD TERNES
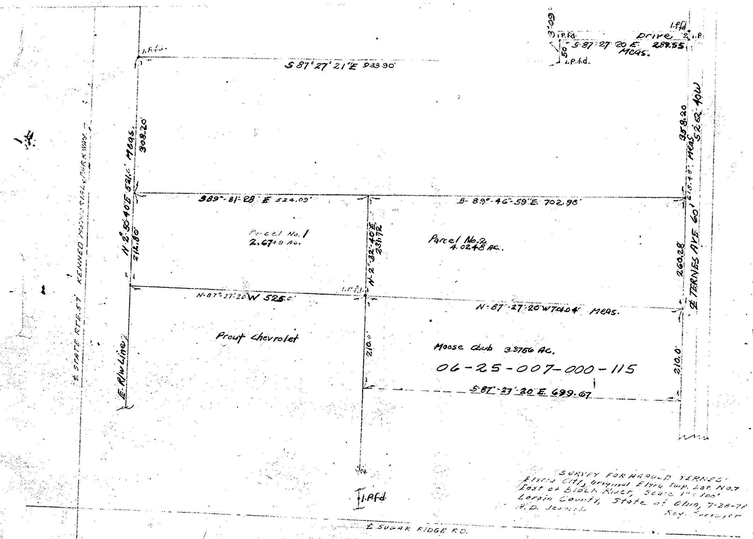
6-126