SURVEY MAP

OF

PART OF
ORIGINAL ELYRIA TOWNSHIP LOT NOS. 1 & 7
EAST OF THE BLACK RIVER
CITY OF ELYRIA COUNTY OF LORAIN STATE OF OHIO

100 0 100 200
SCALE IN FEET

SCALE: 1" = 100'

LEGEND
- O 5/8" CAPPED REBAR SET
- ◎ IRON PIN/PIPE FOUND
- ▣ EXISTING MONUMENT BOX

APPROVED LORAIN CO. ENG. DEPT.
DATE 5-23-02
PAGE 6-143
BY JHatfield
02-0089
01089

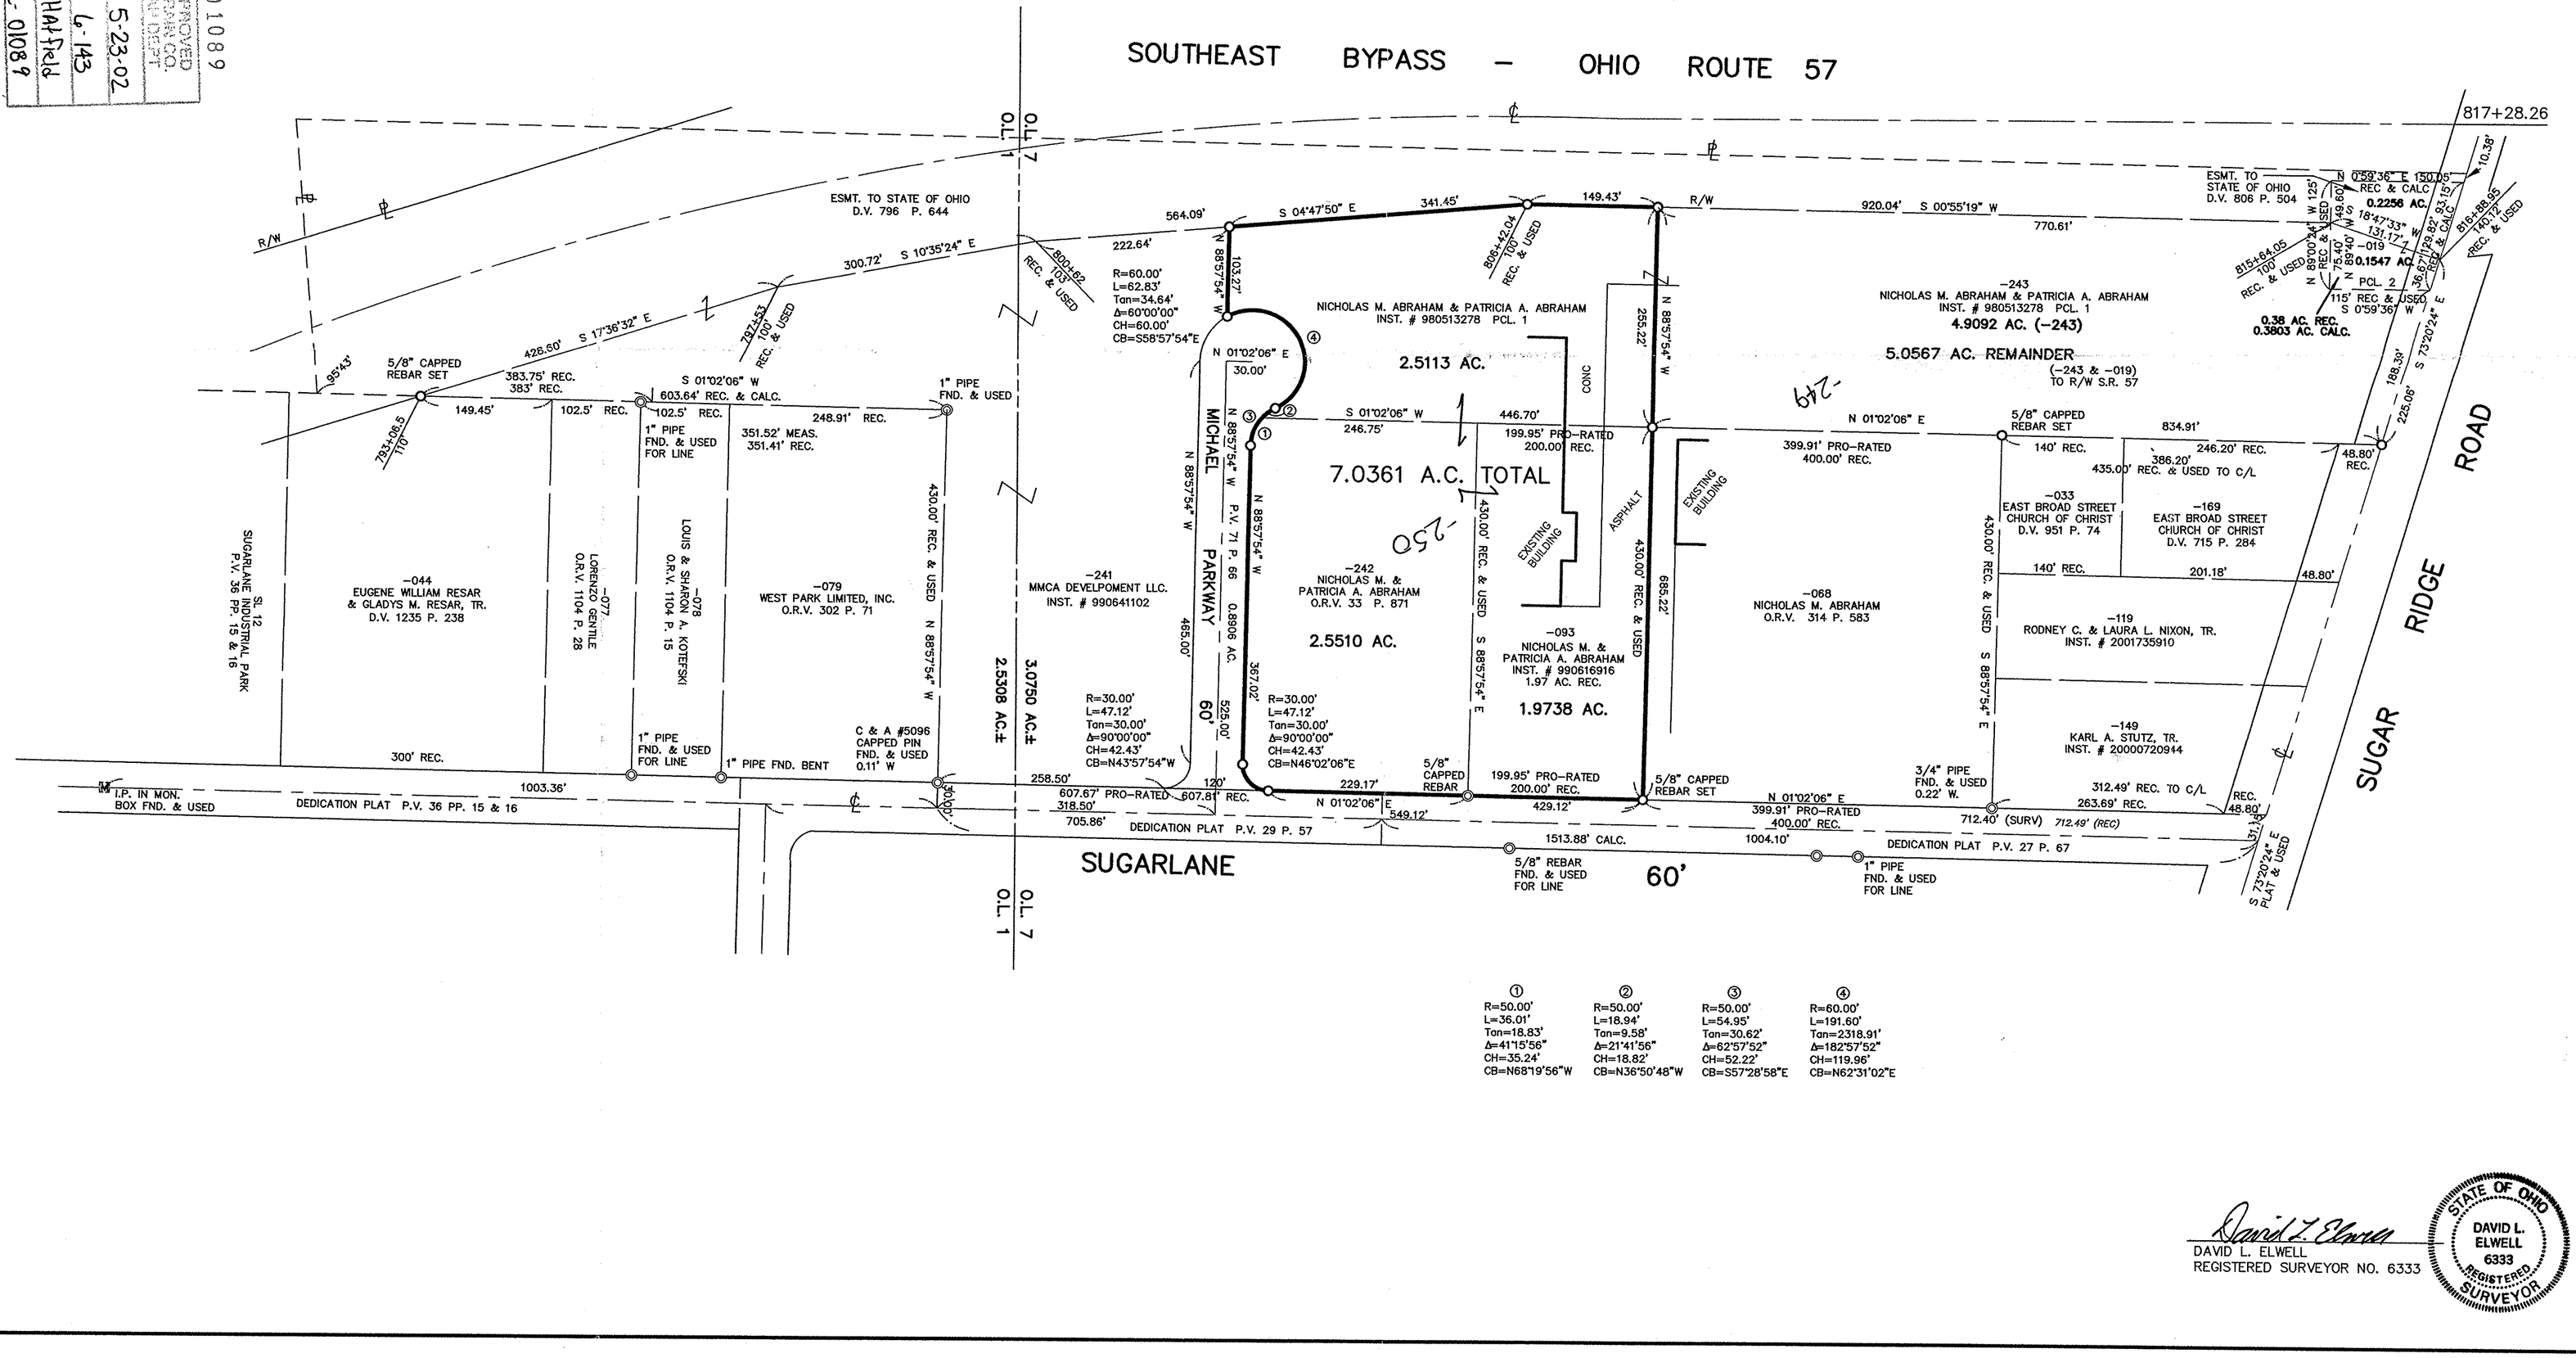

DAVID L. ELWELL
REGISTERED SURVEYOR NO. 6333

STATE OF OHIO
DAVID L. ELWELL
6333
REGISTERED SURVEYOR

REVISIONS		
DESCRIPTION	DATE	BY
ADDITION OF "MICHAEL PARKWAY"	5-09-02	ABR

DATE:
DRAWN BY: DAM
CH'D BY: DJE
DWG. NAME: O-SURV01.dwg
PATHFILE: \98231-02\DOT\CONTR
F.B.

KS ASSOCIATES, INC.
860 Burns Road, Suite 100
P.O. Box 569
Elyria, Ohio 44035
Phone (440) 365-4730
Fax (440) 365-4790
millroom@ksassoc.com
www.ksassoc.com

KS ASSOCIATES

SURVEY MAP

OF PART OF
ELYRIA TOWNSHIP ORIGINAL LOT NOS. 1 & 7, EAST OF THE BLACK RIVER
CITY OF ELYRIA COUNTY OF LORAIN STATE OF OHIO

SHEET 1 OF 1

JOB NO. 98231-02