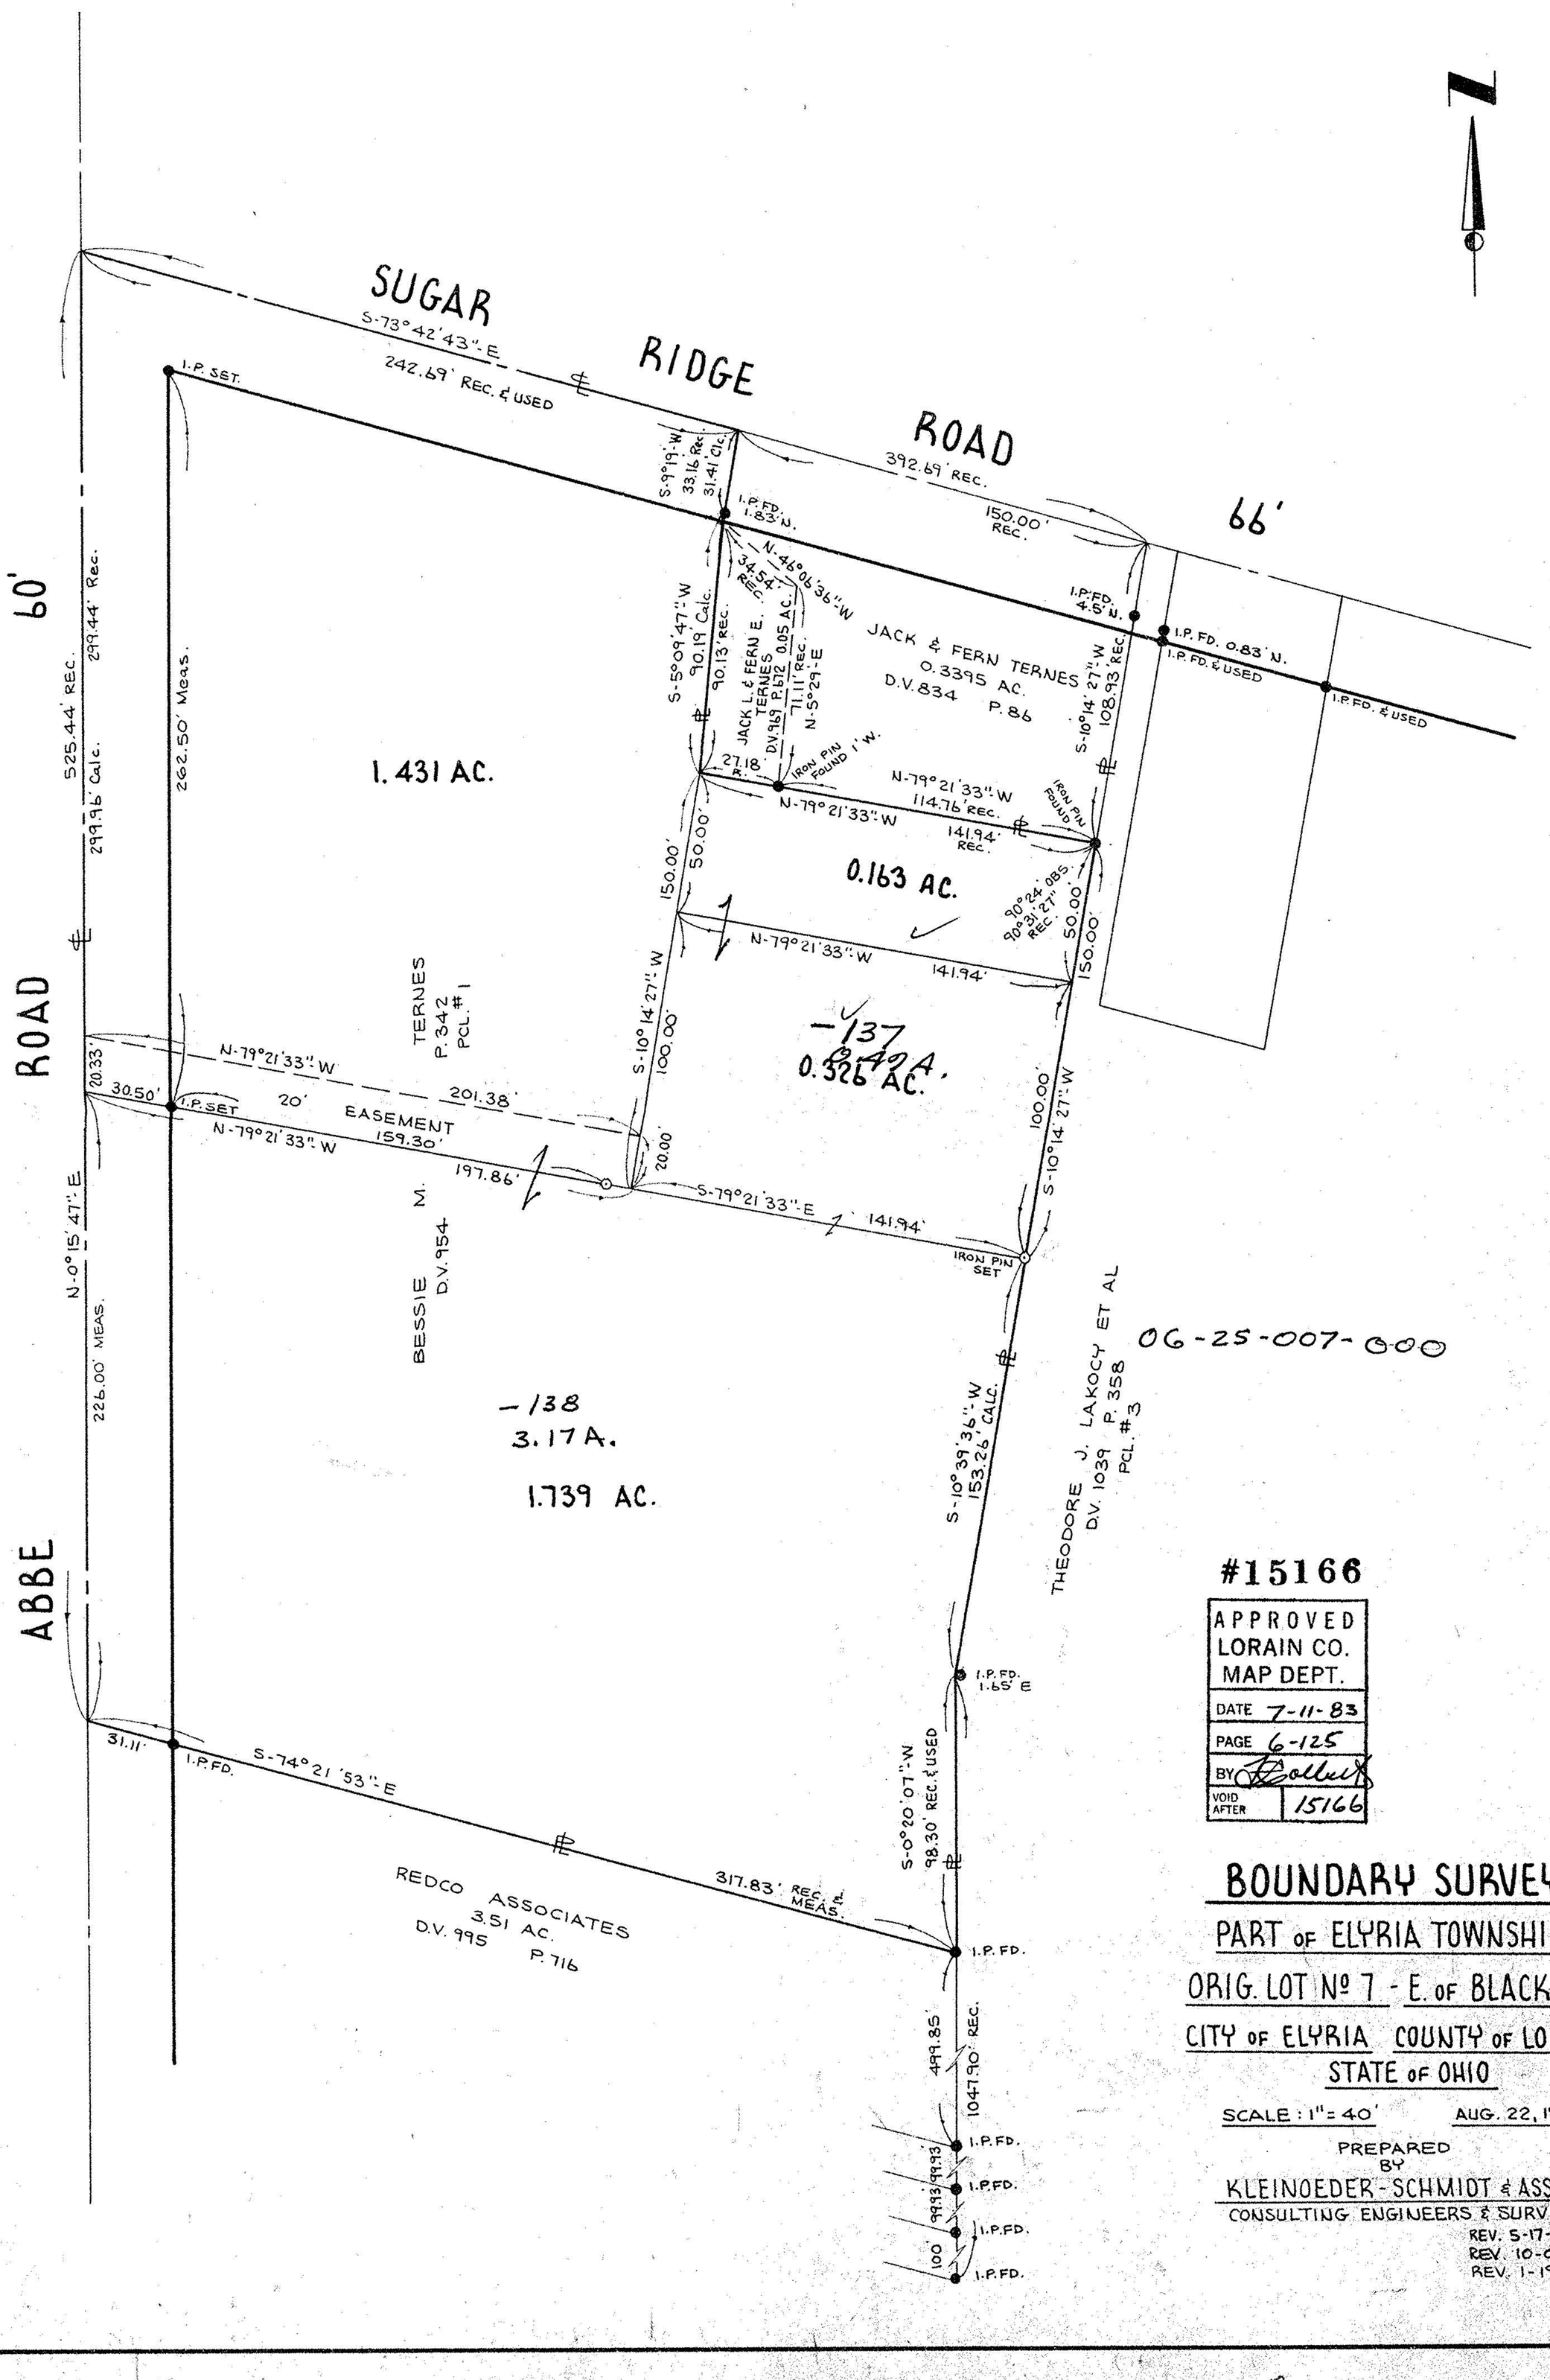

#15166

APPROVED
LORAIN CO.
MAP DEPT.

DATE	7-11-83
PAGE	6-125
BY	
VOID AFTER	15166

BOUNDARY SURVEY

PART OF ELYRIA TOWNSHIP

ORIG. LOT Nº 7 - E. OF BLACK RIV.

CITY OF ELYRIA COUNTY OF LORAIN

STATE OF OHIO

SCALE : 1" = 40' AUG. 22, 1981

PREPARED BY

KLEINOEDER - SCHMIOT & ASSOC.

CONSULTING ENGINEERS & SURV.

REV. 5-17-82
REV. 10-05-82
REV. 1-19-83

81-110