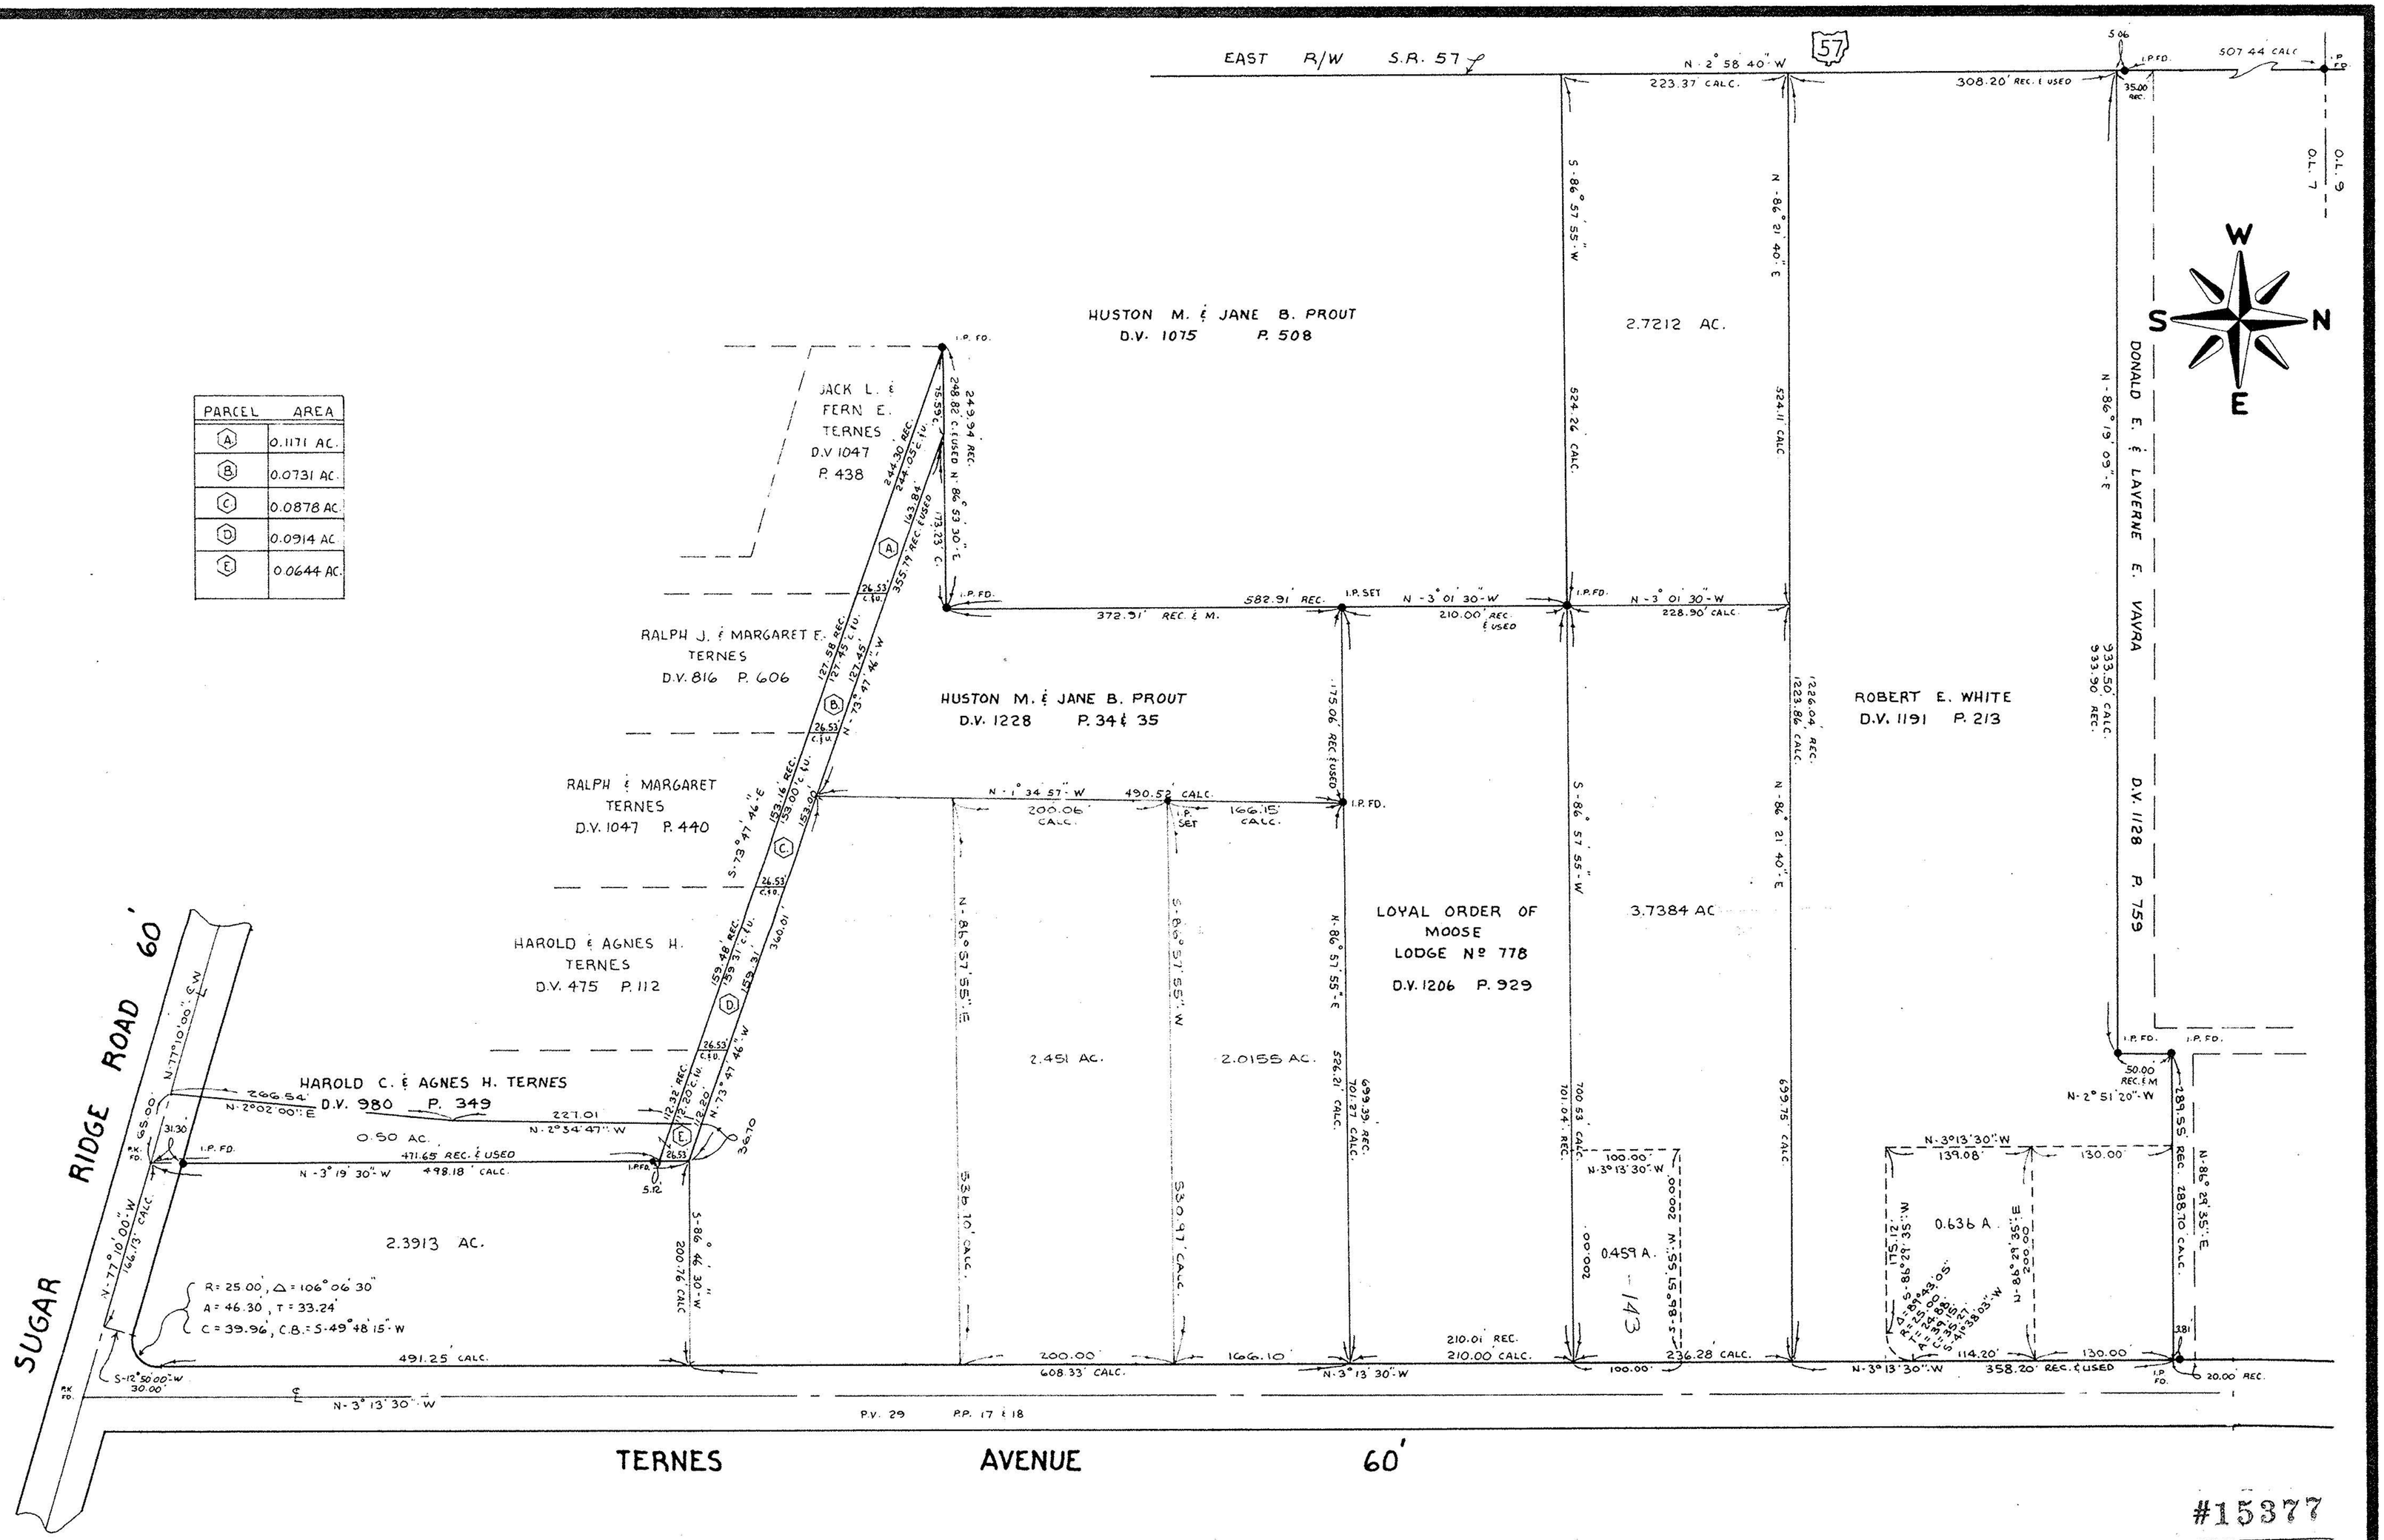

PARCEL	AREA
A	0.1171 AC.
B	0.0731 AC.
C	0.0878 AC.
D	0.0914 AC.
E	0.0644 AC.

#15377

PROJECT

BOUNDARY SURVEY

OF PART OF

ORIGINAL ELYRIA TOWNSHIP (EAST OF THE RIVER)

LOT Nº 7

CITY OF ELYRIA , COUNTY OF LORAIN

STATE OF OHIO

Prepared for: HAROLD TERNES

Rev.
10-19-83
10-3-83
8-3-83
12-10-82 K.V.S.
6-1-81
1-22-80

Drawn by: K.V.S.

Checked by:

App. by:

Scale: 1" = 100'

Date: OCTOBER, 1979

KLEINOEDER · SCHMIDT and ASSOCIATES

ENGINEERS — SURVEYORS — CONSULTANTS in LAND PLANNING

ELYRIA - NORWALK - MEDINA OHIO

REFERENCES

SHEET NO. 1 of 1

APPROVED LORAIN CO. MAP DEPT.

DATE 12-1-83

PAGE 6-126

BY T. McNair

VOID

JOB NO. 72-97