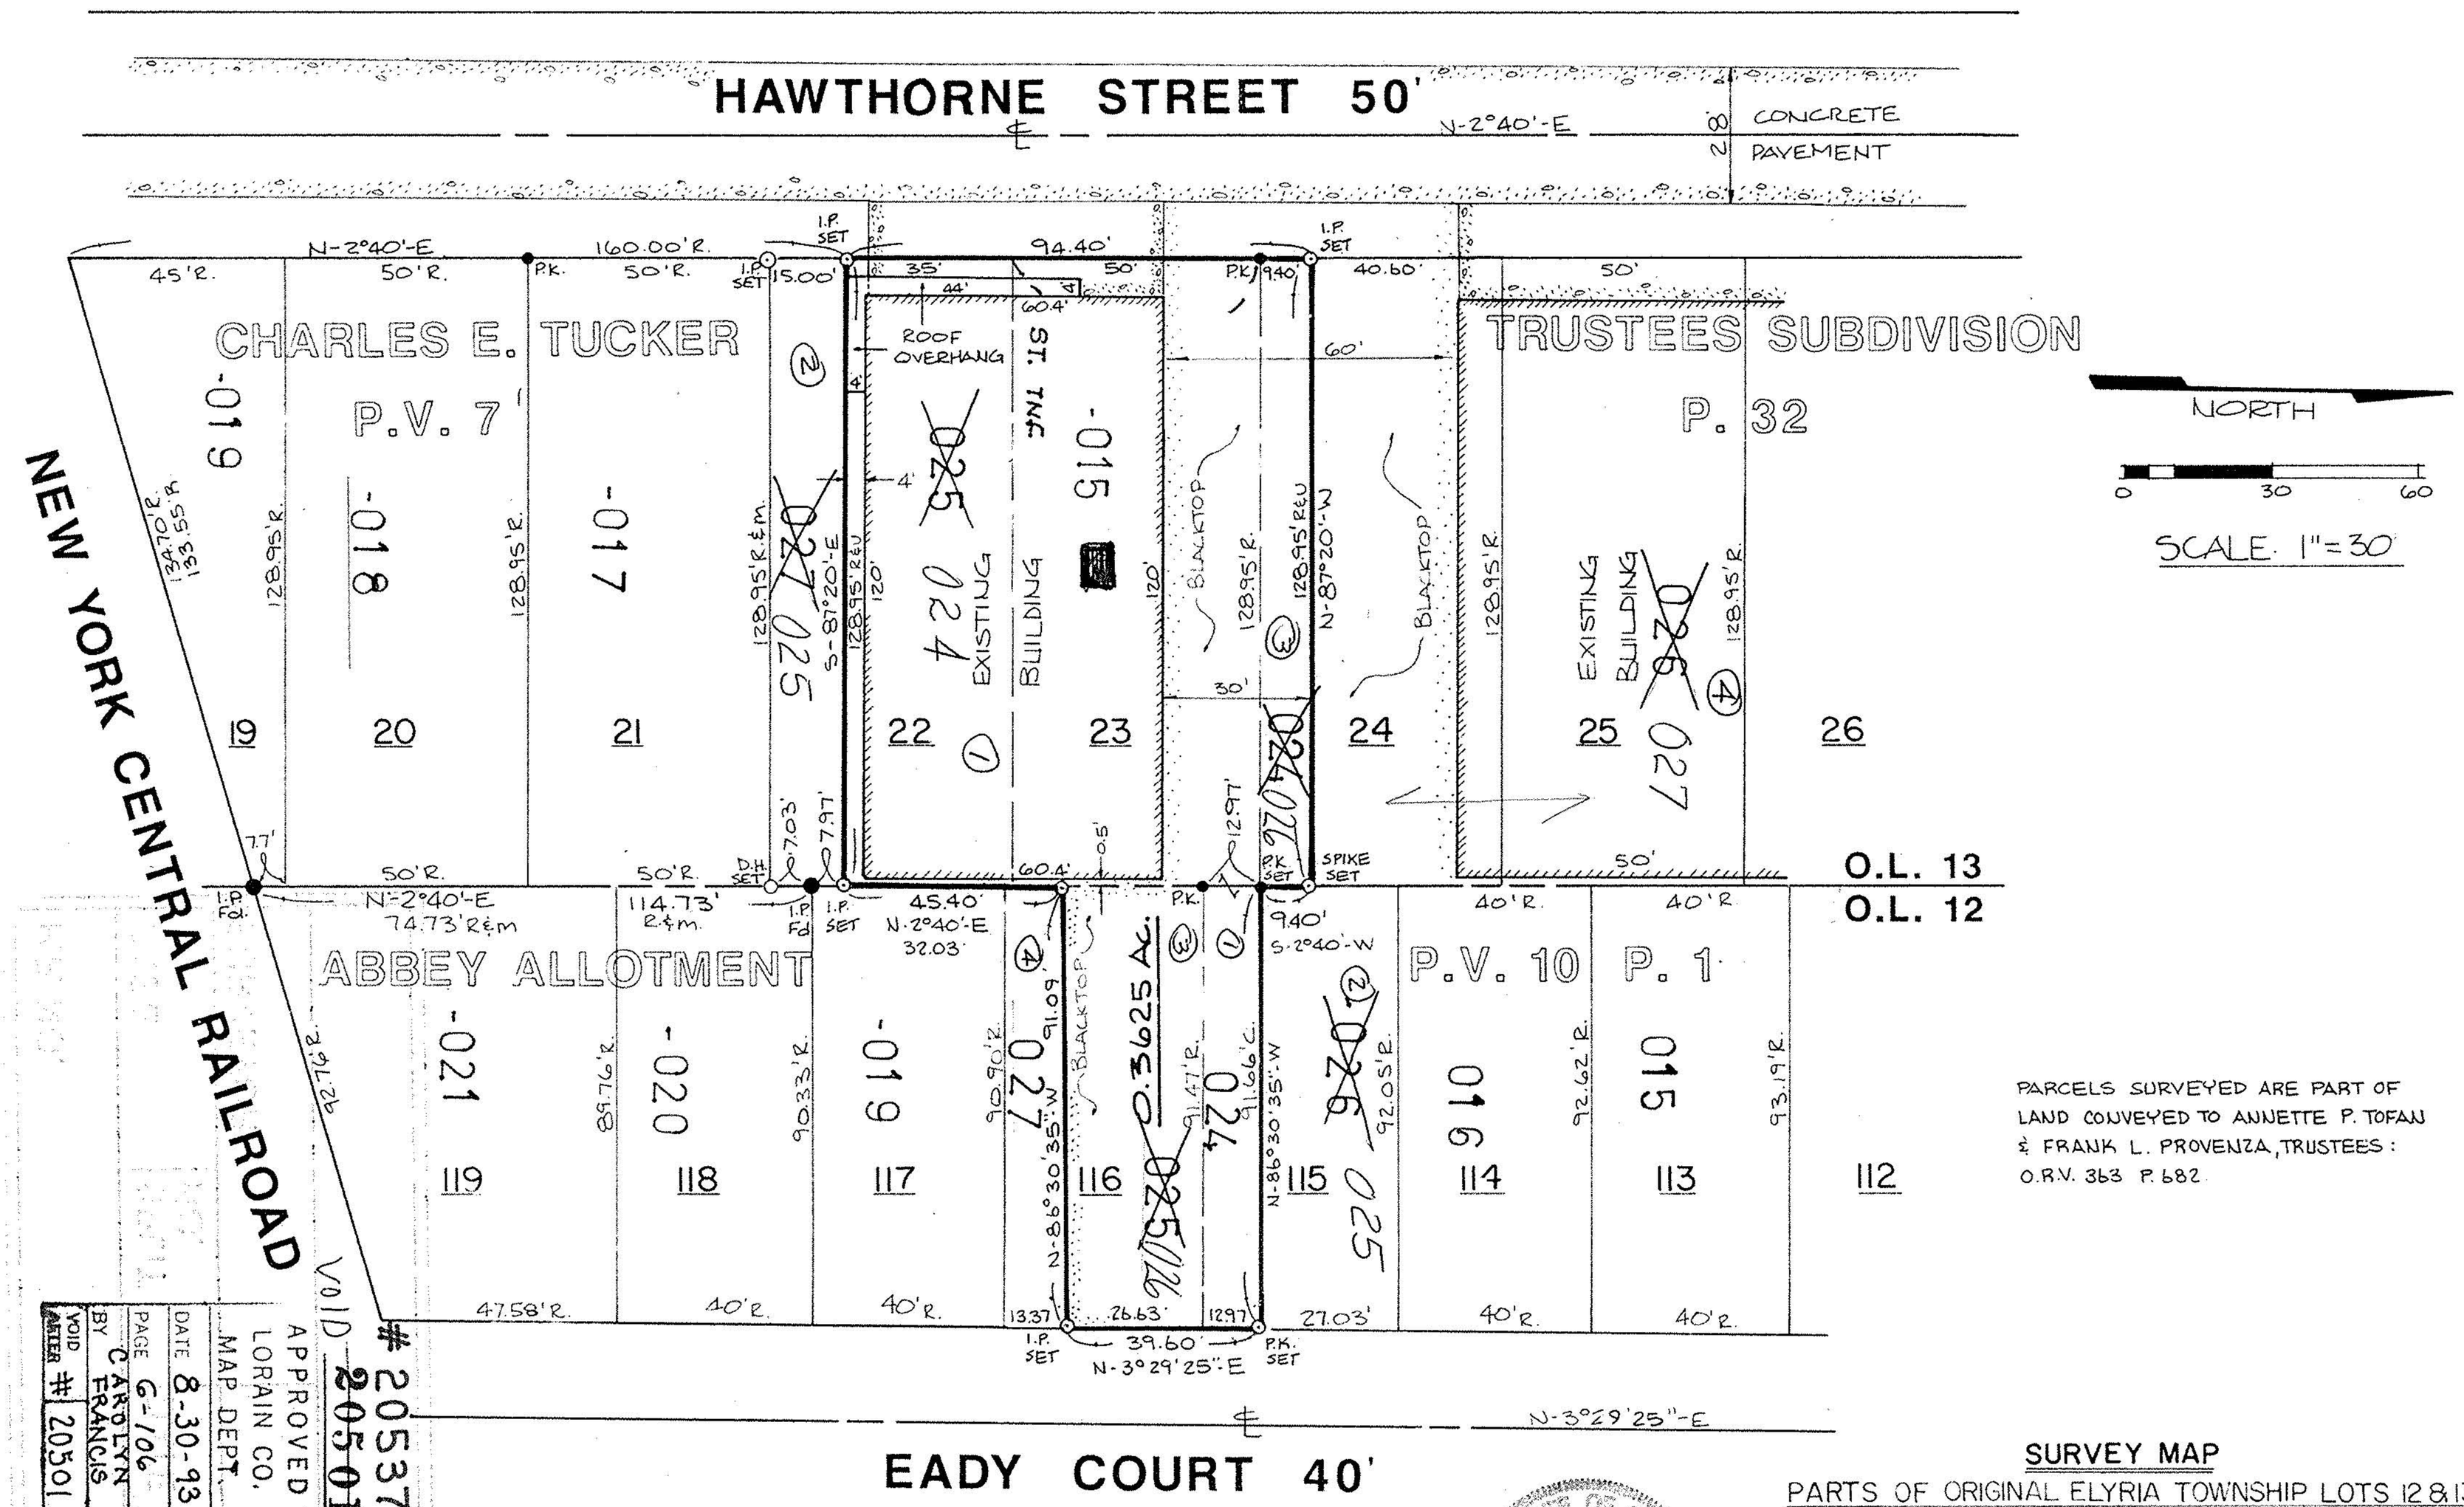

PARCELS SURVEYED ARE PART OF LAND CONVEYED TO ANNETTE P. TOFAN & FRANK L. PROVENZA, TRUSTEES: O.R.V. 363 P. 682

VOID #20537 20501

APPROVED LORAIN CO. MAP DEPT.
DATE 8-30-93
PAGE 6-106
BY CAROLYN FRANCIS
VOID AFTER # 20501

PREPARED BY:
KS ASSOCIATES INC.
ENGINEERS SURVEYORS

David L. Elwell
REG. SURVEYOR NO. 6333
9-15-92

STATE OF OHIO
DAVID L. ELWELL
6333
REGISTERED SURVEYOR

SURVEY MAP

PARTS OF ORIGINAL ELYRIA TOWNSHIP LOTS 12 & 13
EAST OF BLACK RIVER
CITY OF ELYRIA COUNTY OF LORAIN
STATE OF OHIO

JOB No. 92-341