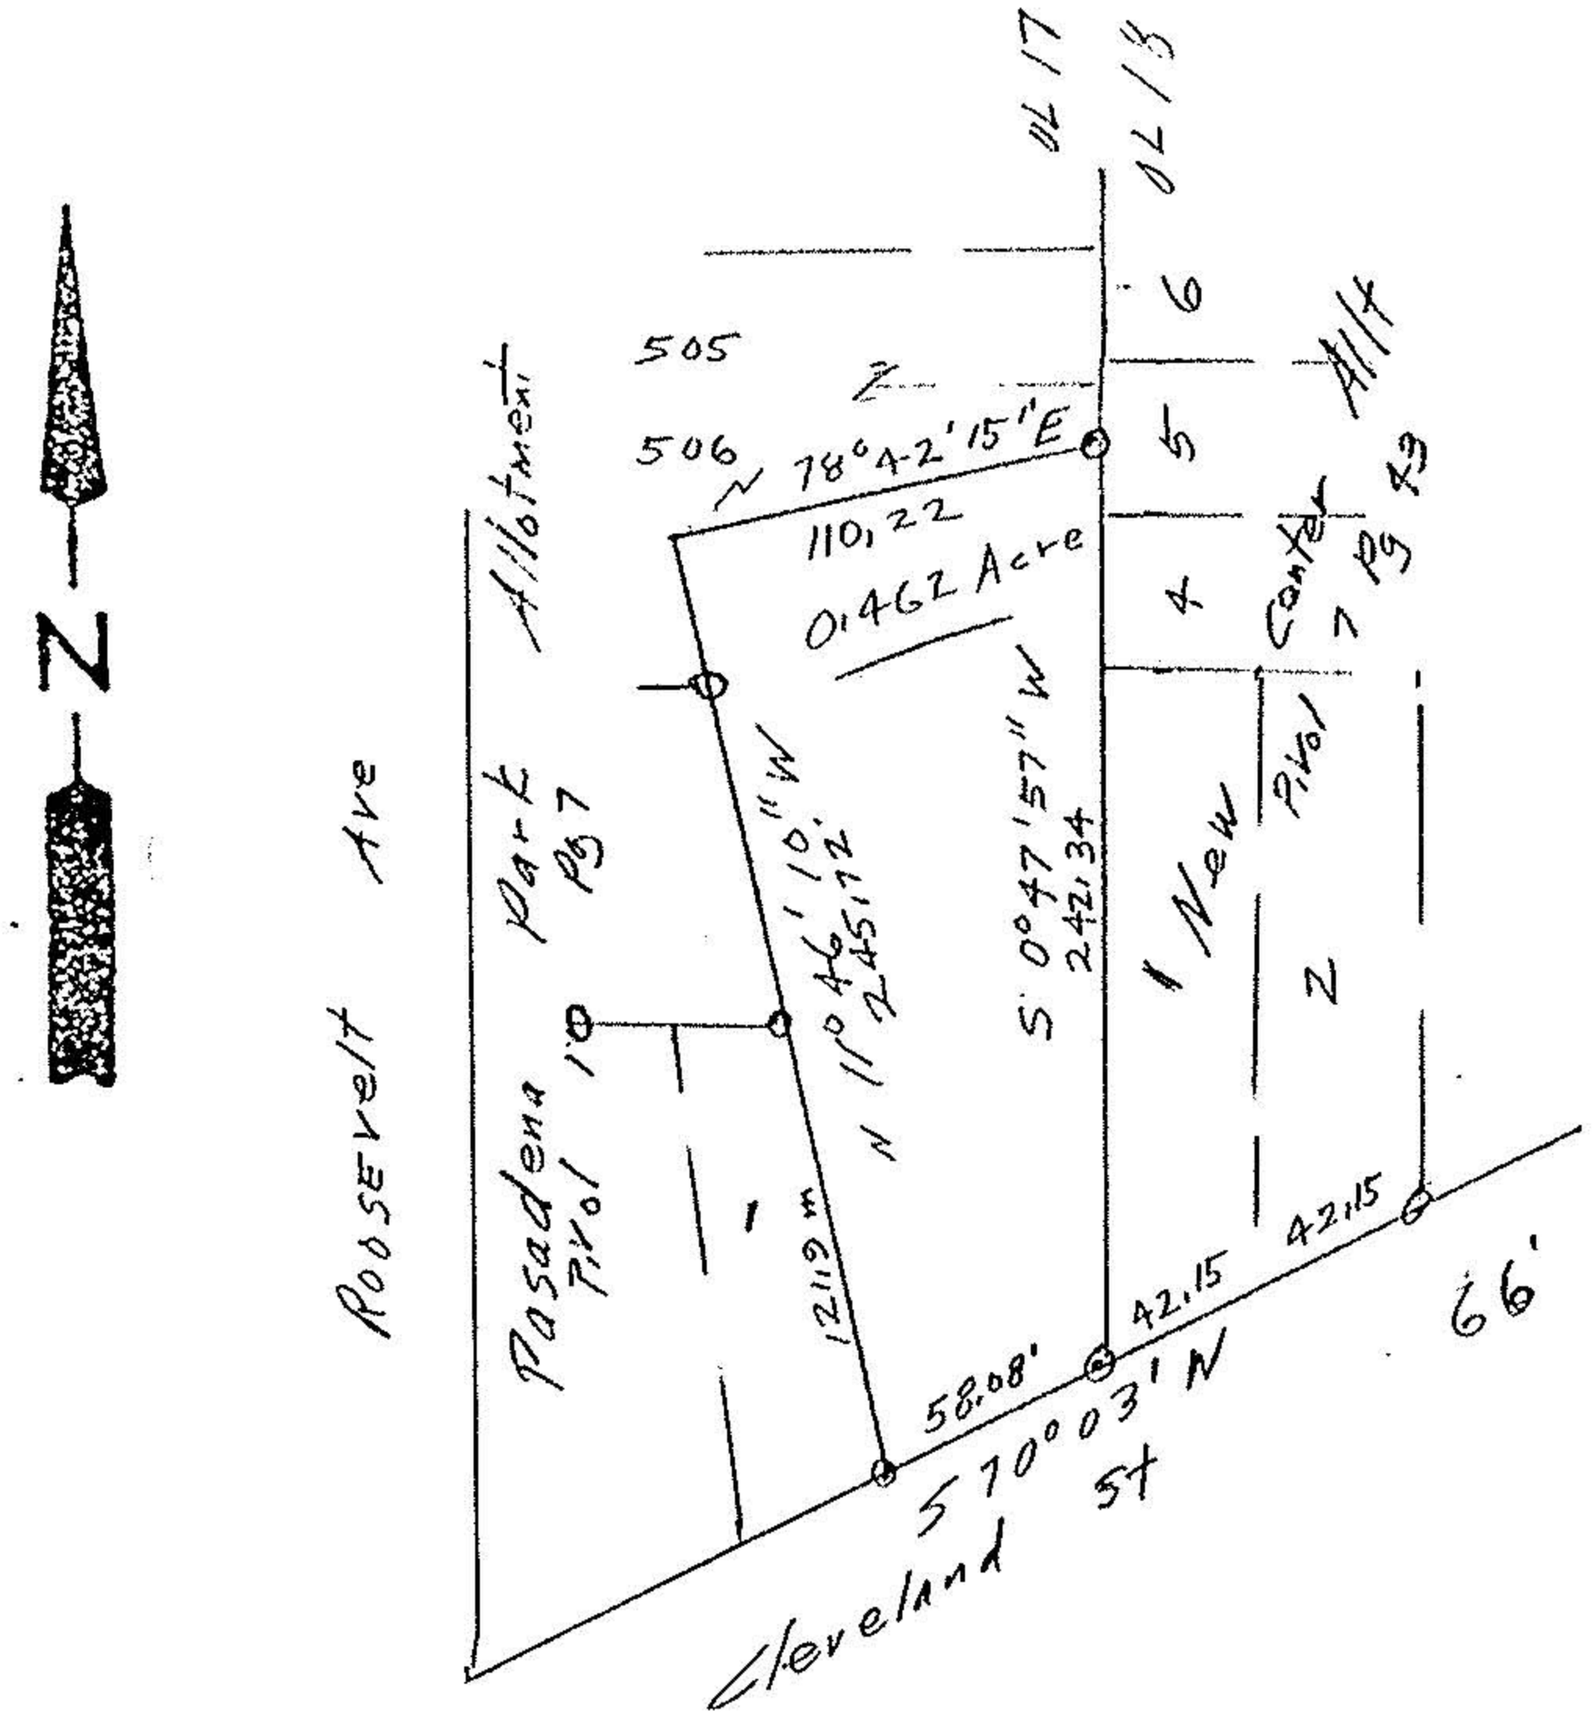

o iron pins fd
• iron pins set

Survey for
Gregory Horan
PPN 06250171100 26
Instrument No 200107255784
Original Elyria Twp Lot 17
East of Black River
City of Elyria Lorain County
Ohio Scale 1"=80' March 2001
pl #00540-X

John Pozywak

STATE OF OHIO
JOHN POZYWAK
5292
REGISTERED
SURVEYOR

APPROVED
LORAIN CO.
MAP DEPT.
DATE 3-22-01
DWG 6-105
BY R. MAINES
T. MENAIR
01-00540X