




Carl R. Anderson

PREPARED FOR: SCOTT EMERSON
541 E. BROAD ST.
ELYRIA, OHIO 44035

PREPARED BY: CARL R. ANDERSON P.S.
866 SALEM AVENUE
ELYRIA, OHIO 44035
TELE: (216) 365-8104

SURVEY P.P. 06-25-016-114-002
CITY OF ELYRIA - COUNTY OF LORAIN
STATE OF OHIO - ORIGINAL LOT 16
EAST OF THE EAST BRANCH OF THE BLACK RIVER

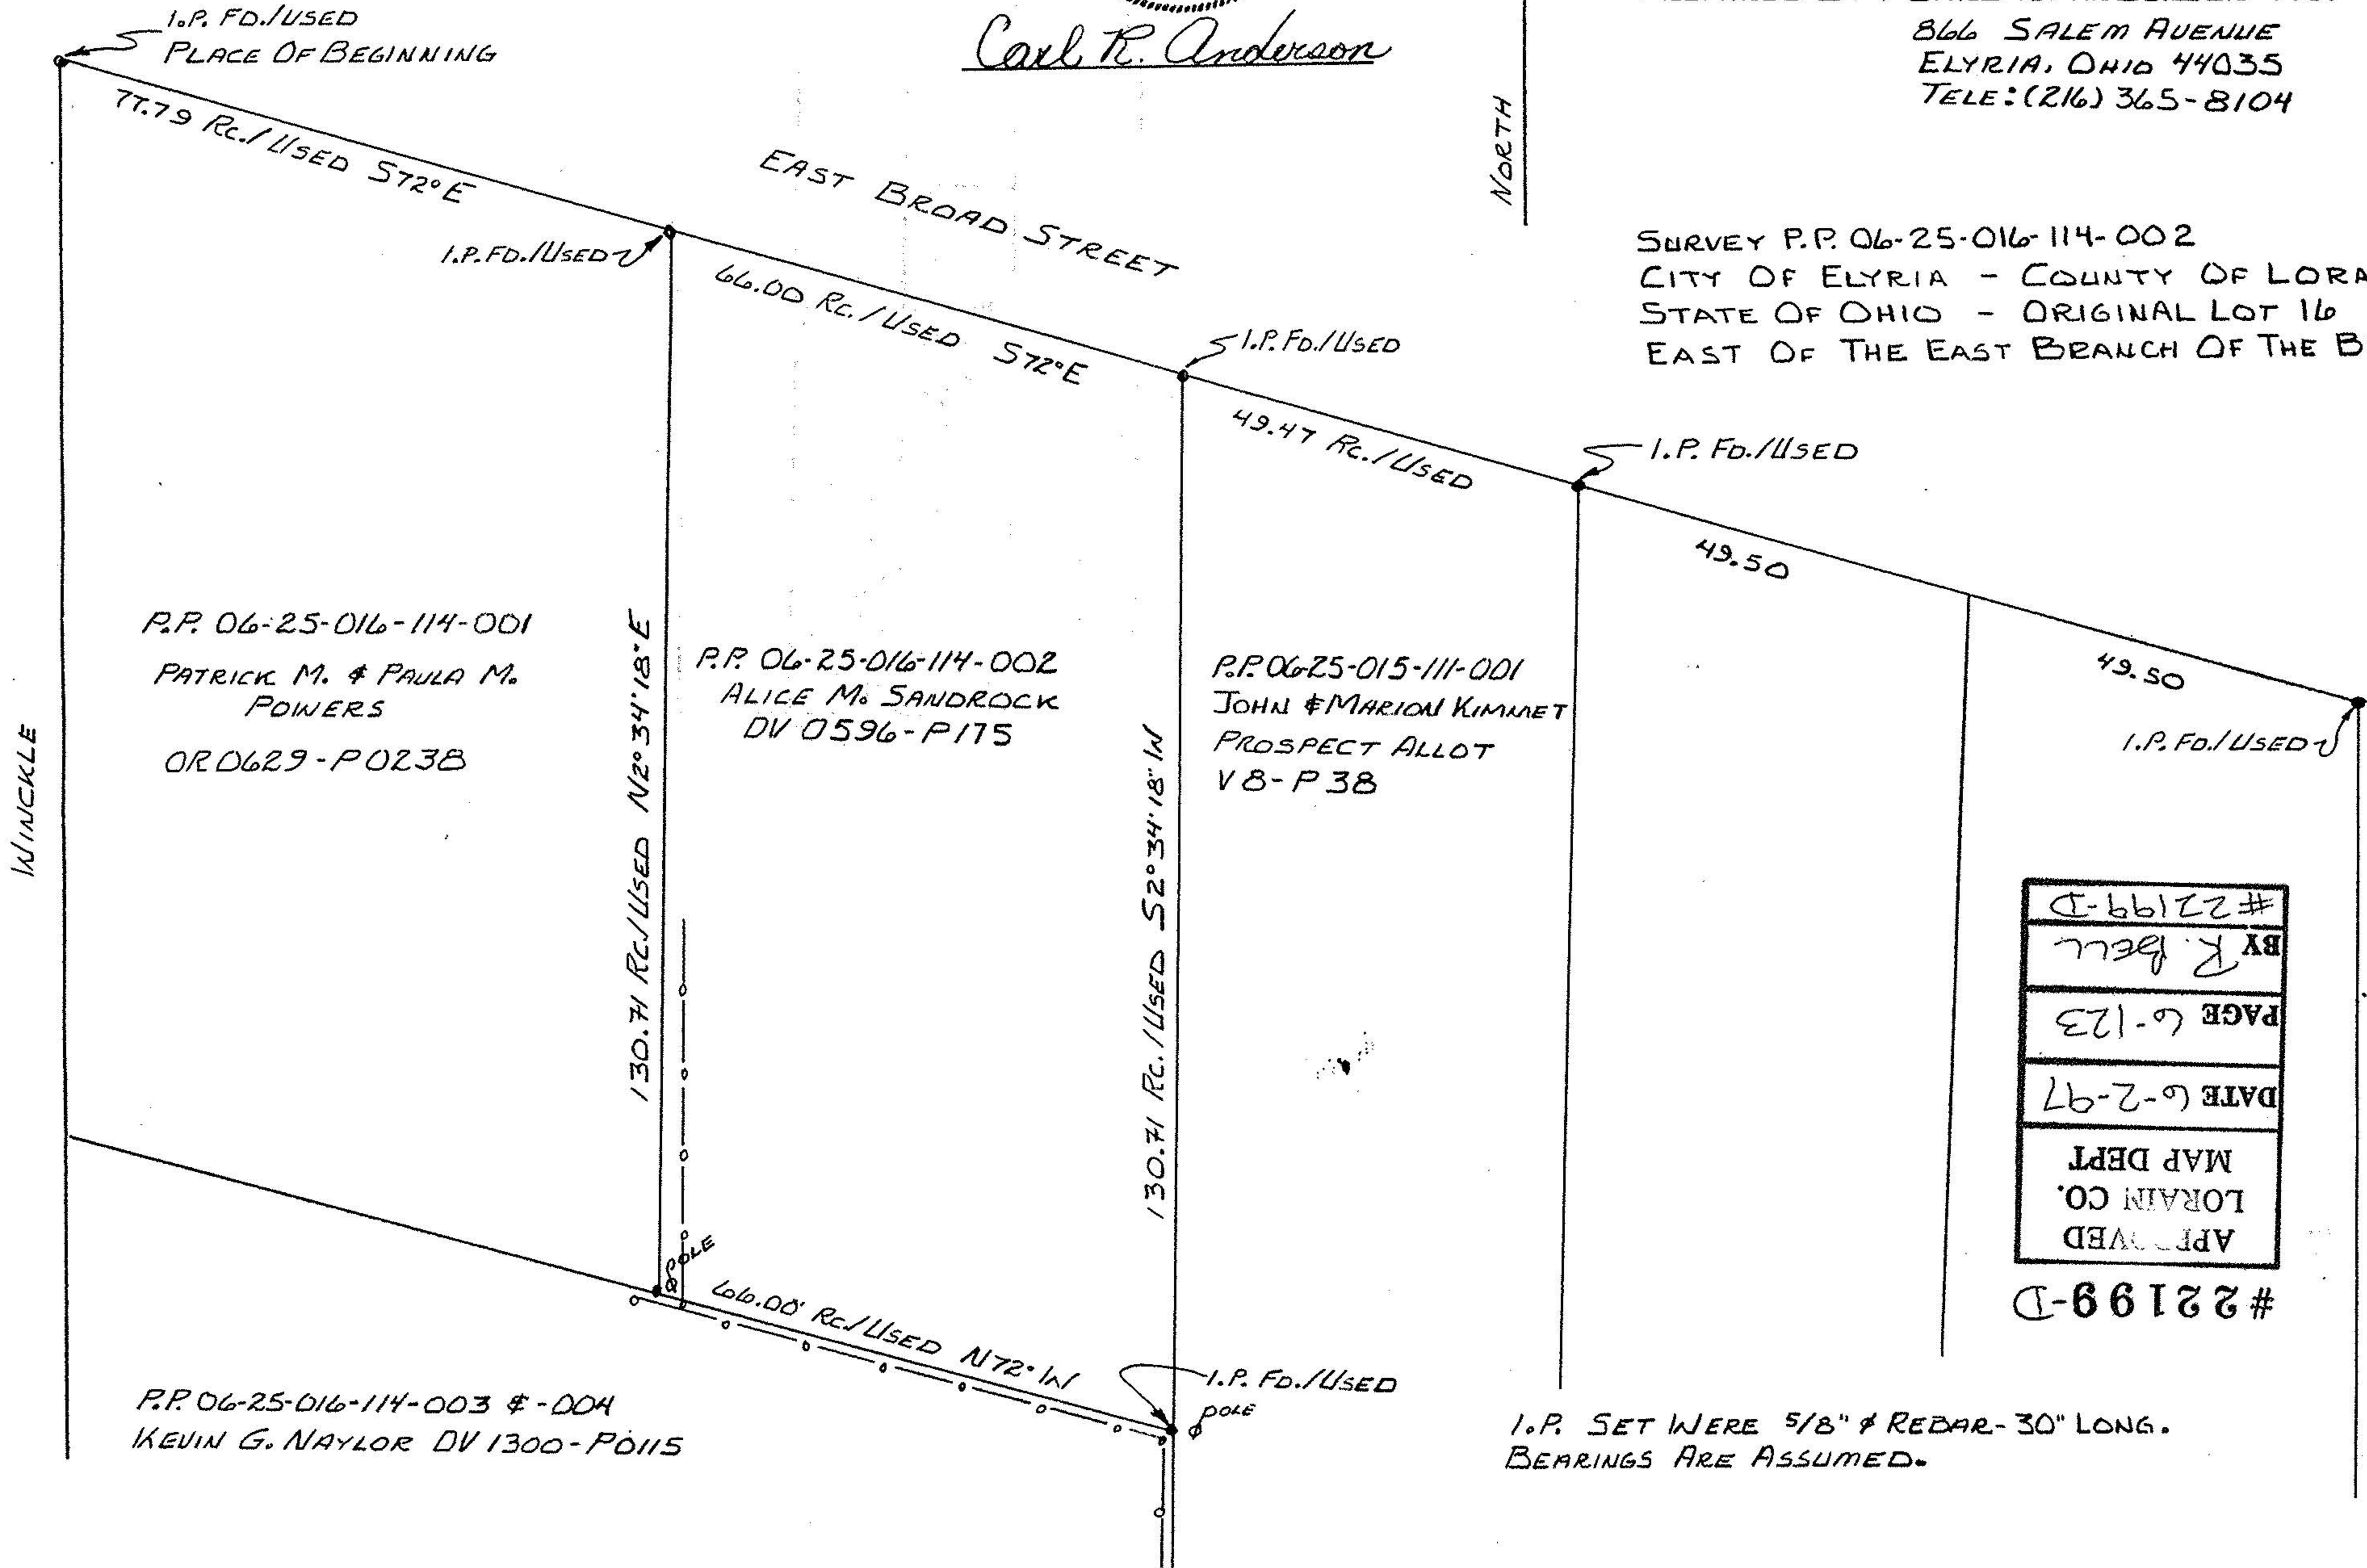

| |
|-------------------------|
| # 22199-D |
| BY R. Bell |
| PAGE 6-123 |
| DATE 6-2-97 |
| MAP DEPT. LORAIN CO. |
| APPROVED |

22199-D

I.P. SET WERE 5/8" ϕ REBAR-30" LONG.
BEARINGS ARE ASSUMED.