

FARMS ALLOTMENT



East of Black River.

Lorain Co Ohio

Scale 1 inch = 100 feet

6-89

6-71

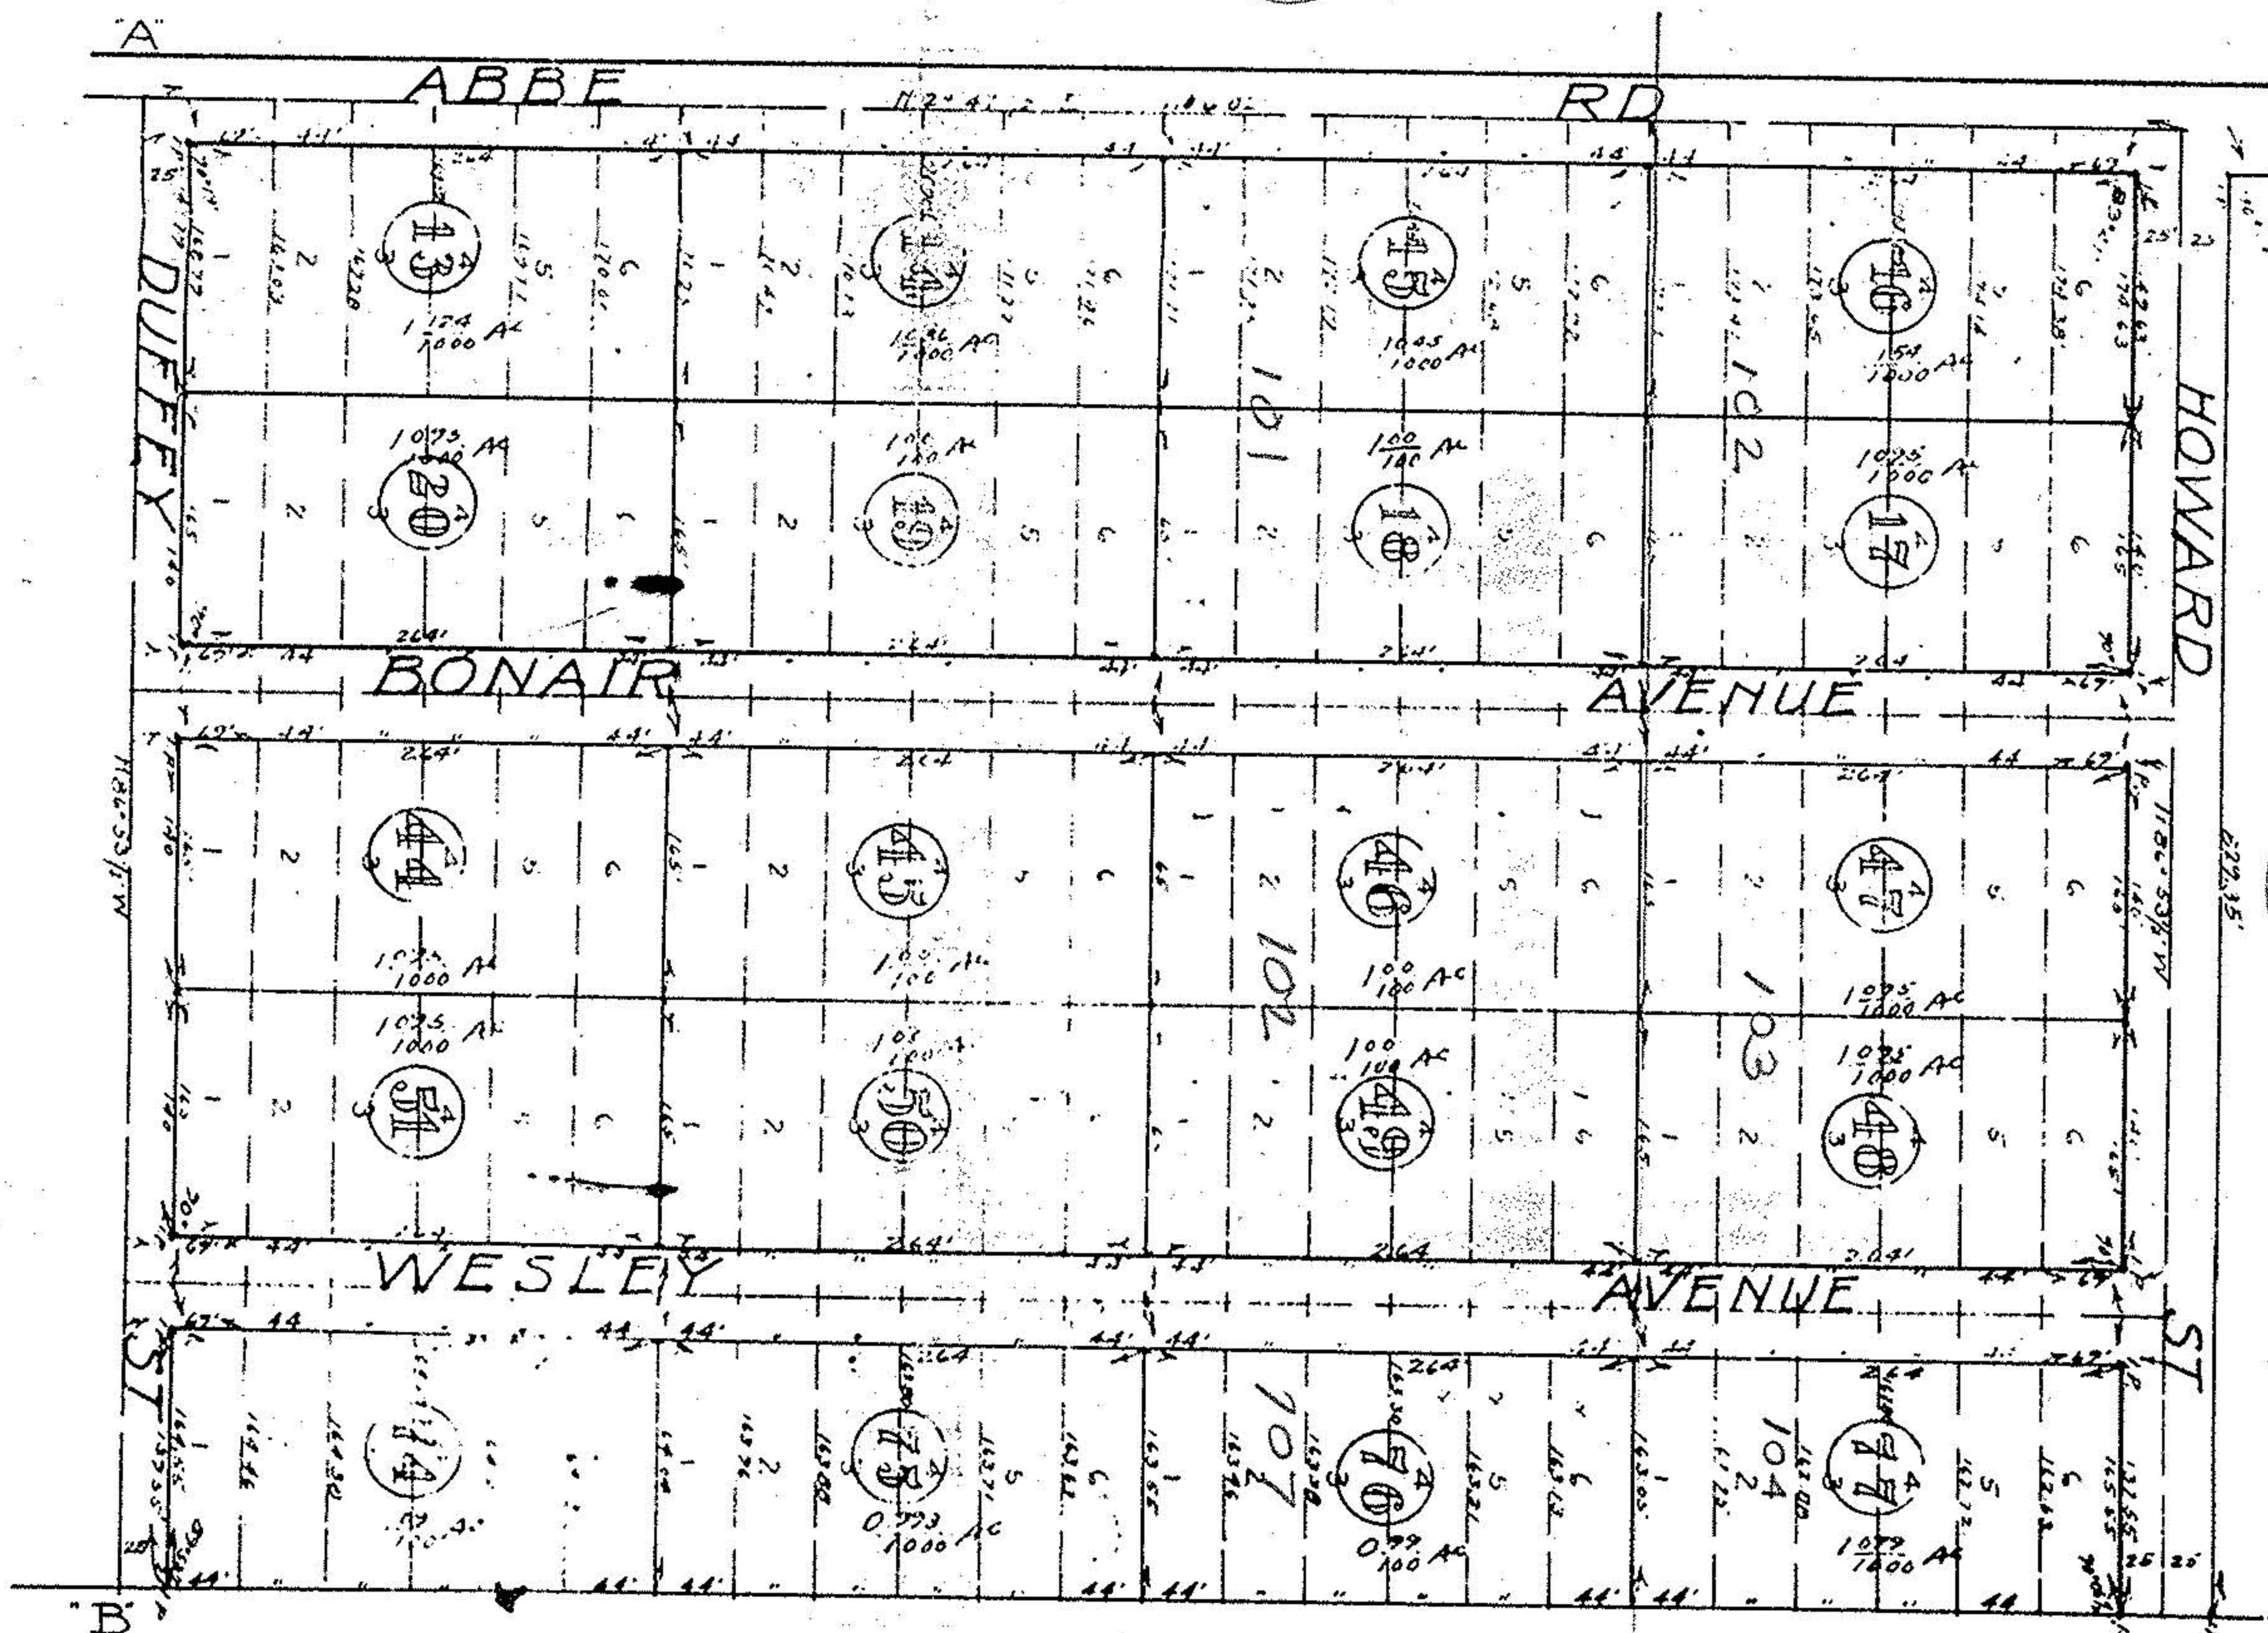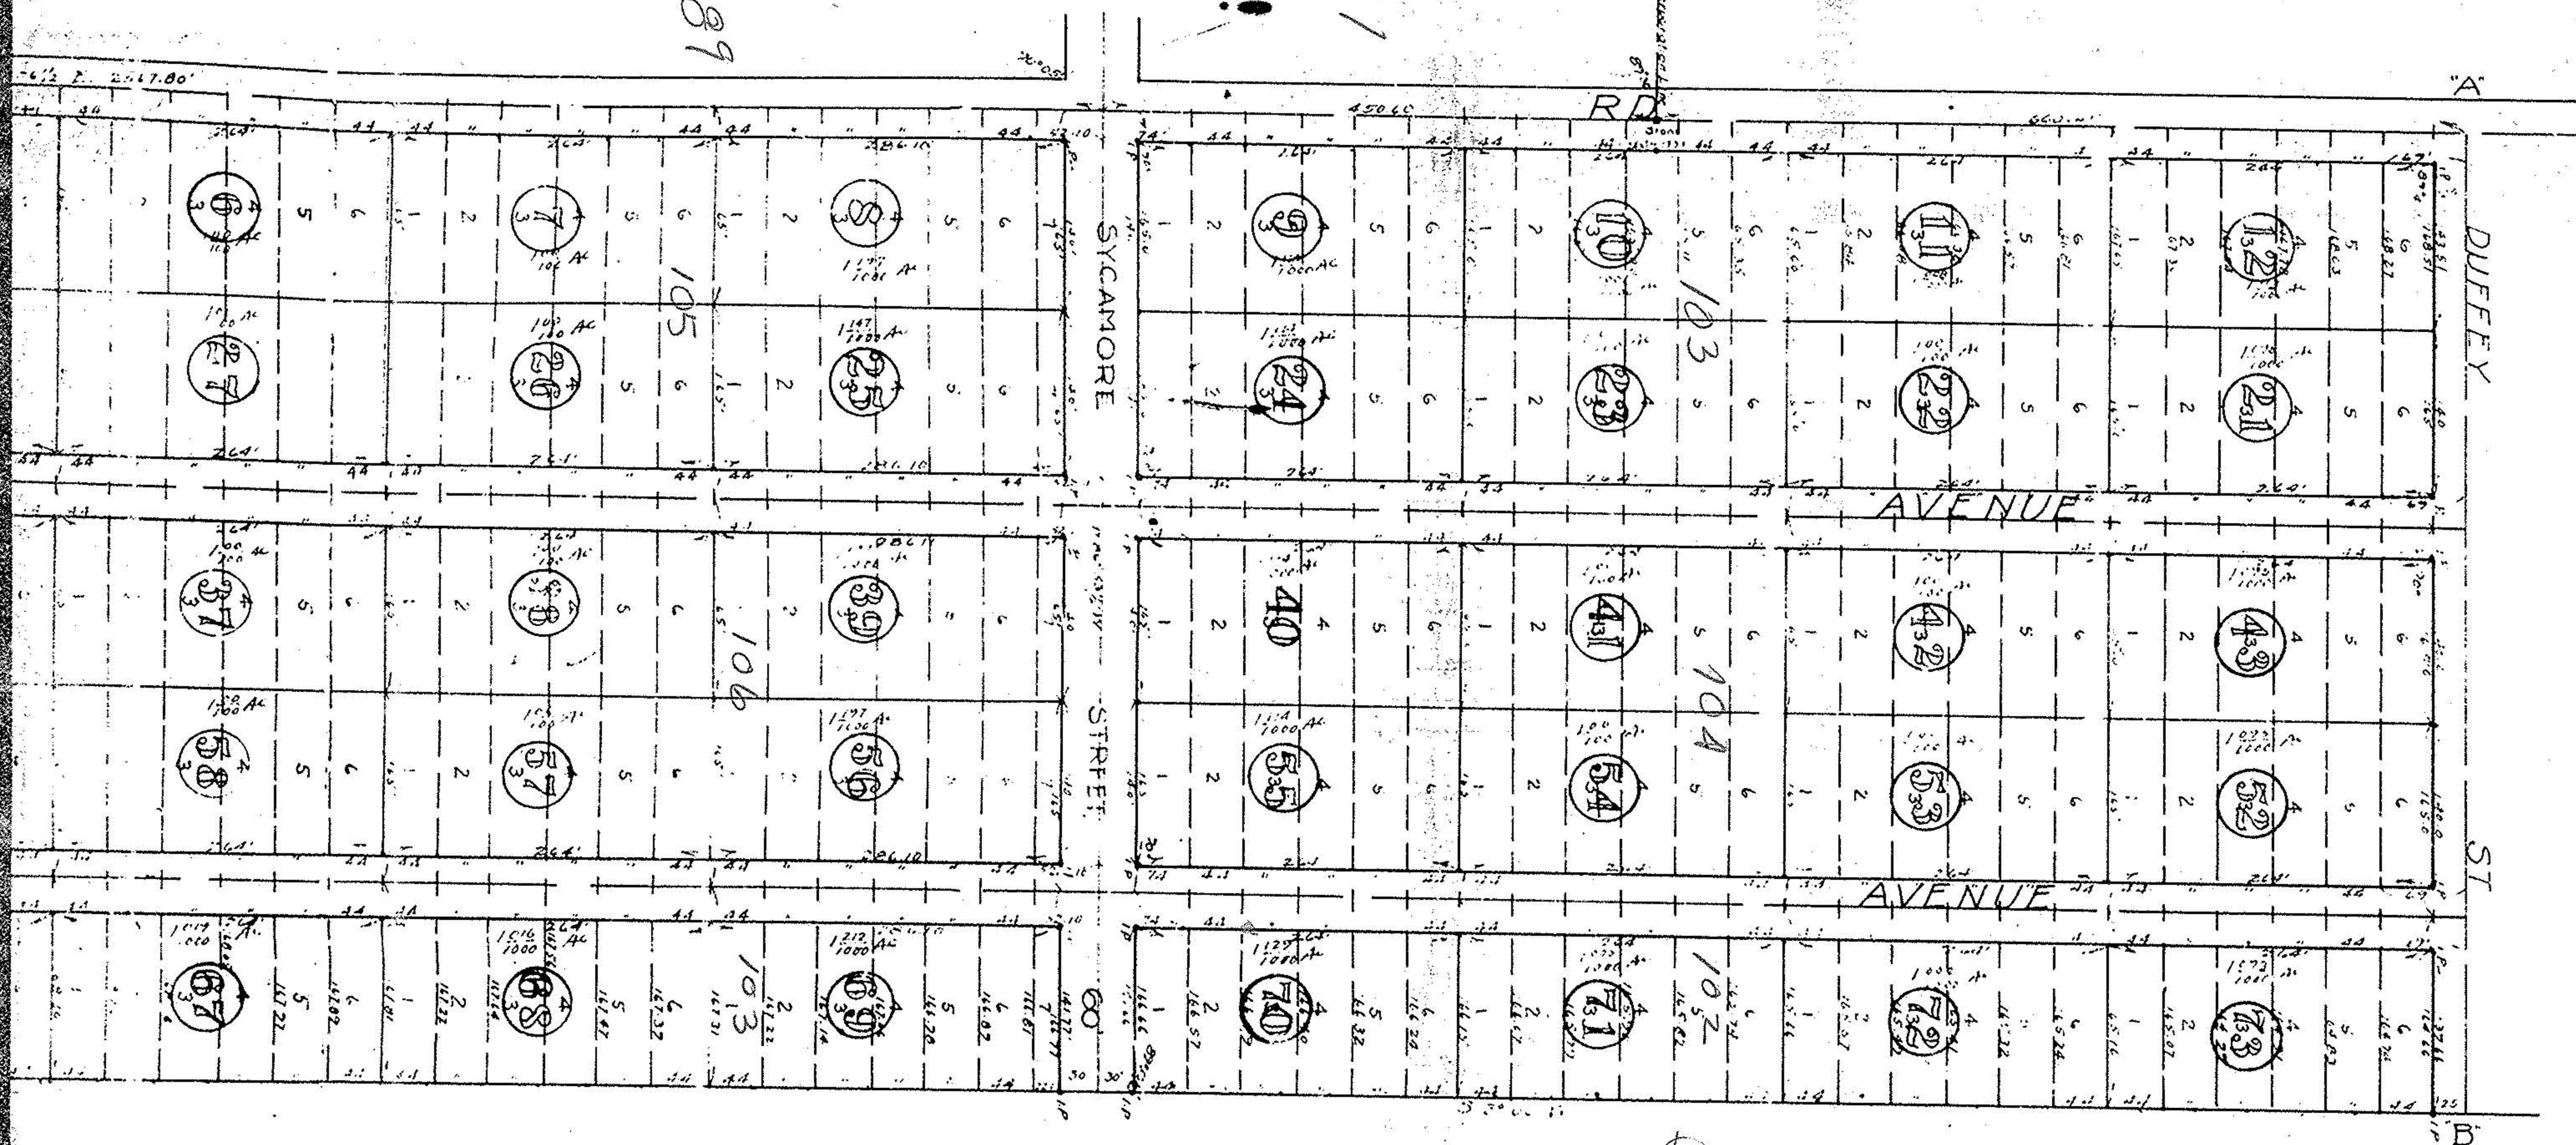

COPY