KLEINOEDER · SCHMIDT and ASSOCIATES

ENGINEERS — SURVEYORS — CONSULTANTS in LAND PLANNING

ELYRIA · NORWALK · NEVADA OHIO

SURVEY

Sublot(s) 3 AND PART OF 4
BLOCK 24
Subd'n CITY FARMS ALLOTMENT
P.V. 9 P. 3

Township ELYRIA
Orig. Lot(s) 22
County of LORAIN
Corporation CITY OF ELYRIA

Tract EAST OF BLACK RIVER
Sec.
State of Ohio

6-71

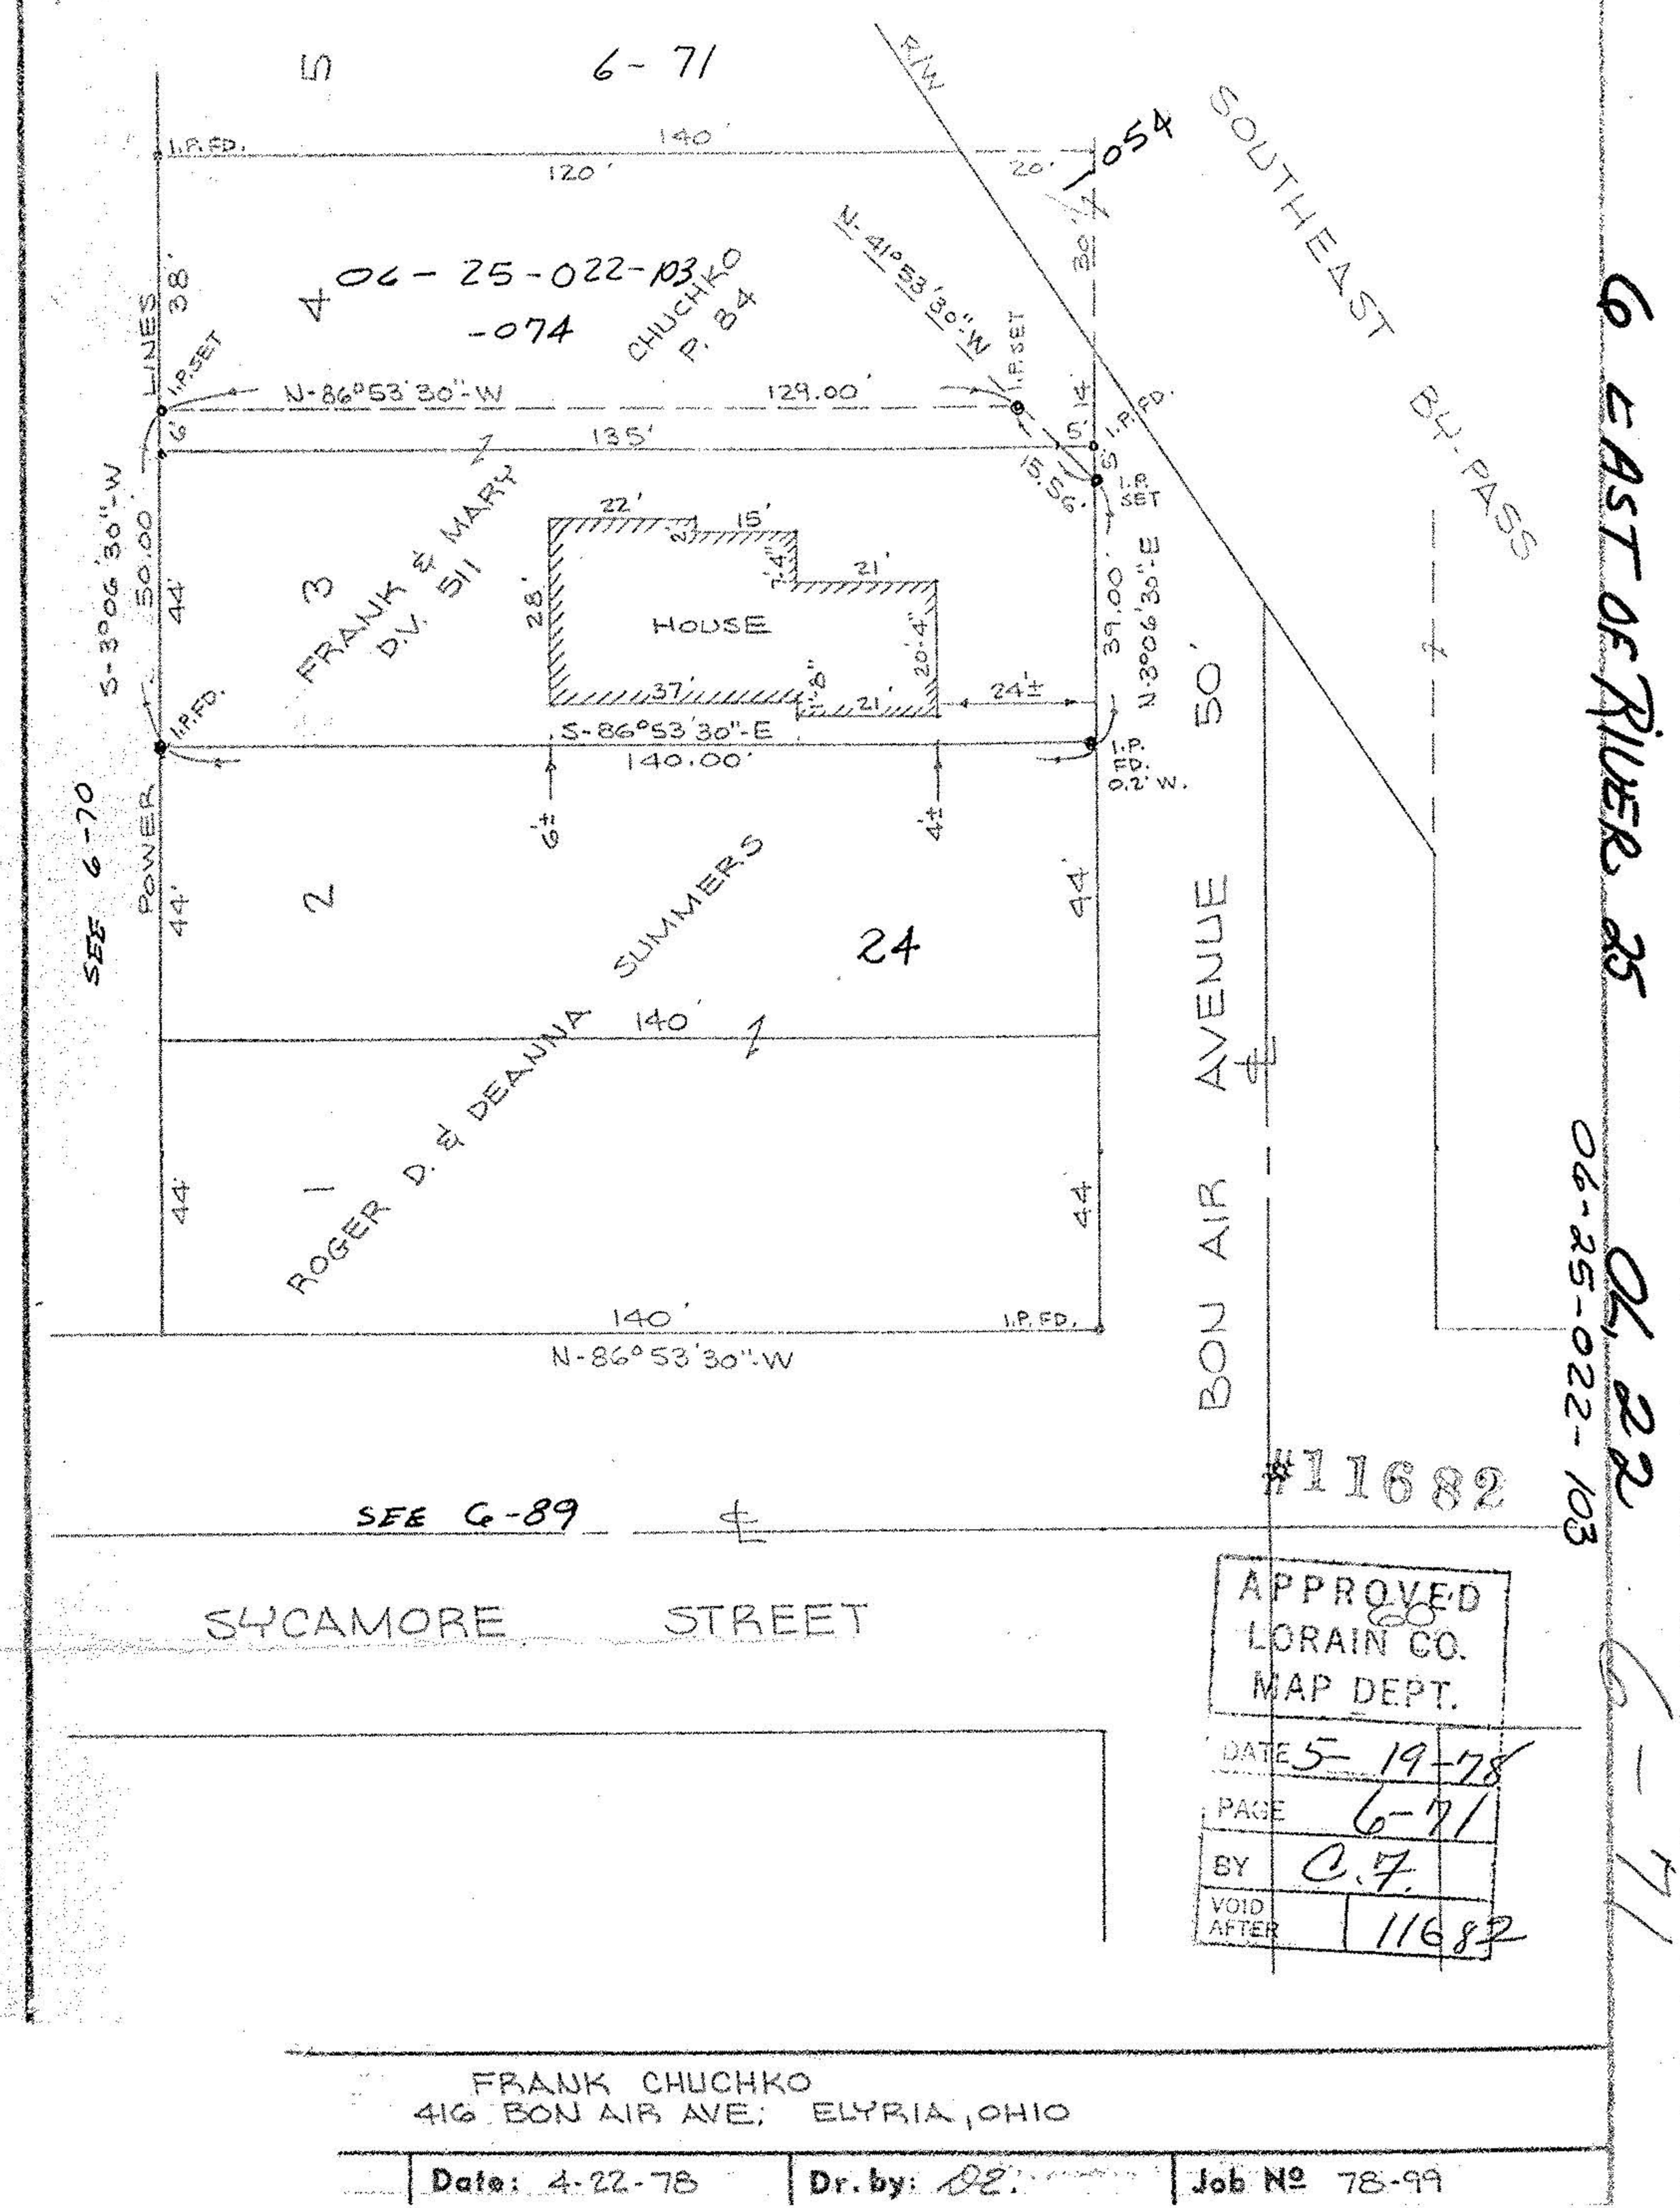

APPROVED
LORAIN CO.
MAP DEPT.
DATE 5-19-78
PAGE 6-71
BY C.T.
VOID AFTER 11682

FRANK CHUCHKO
416 BON AIR AVE; ELYRIA, OHIO

Date: 4-22-78	Dr. by: DE.	Job No 78-99