6-25-021-106

#18416 OR

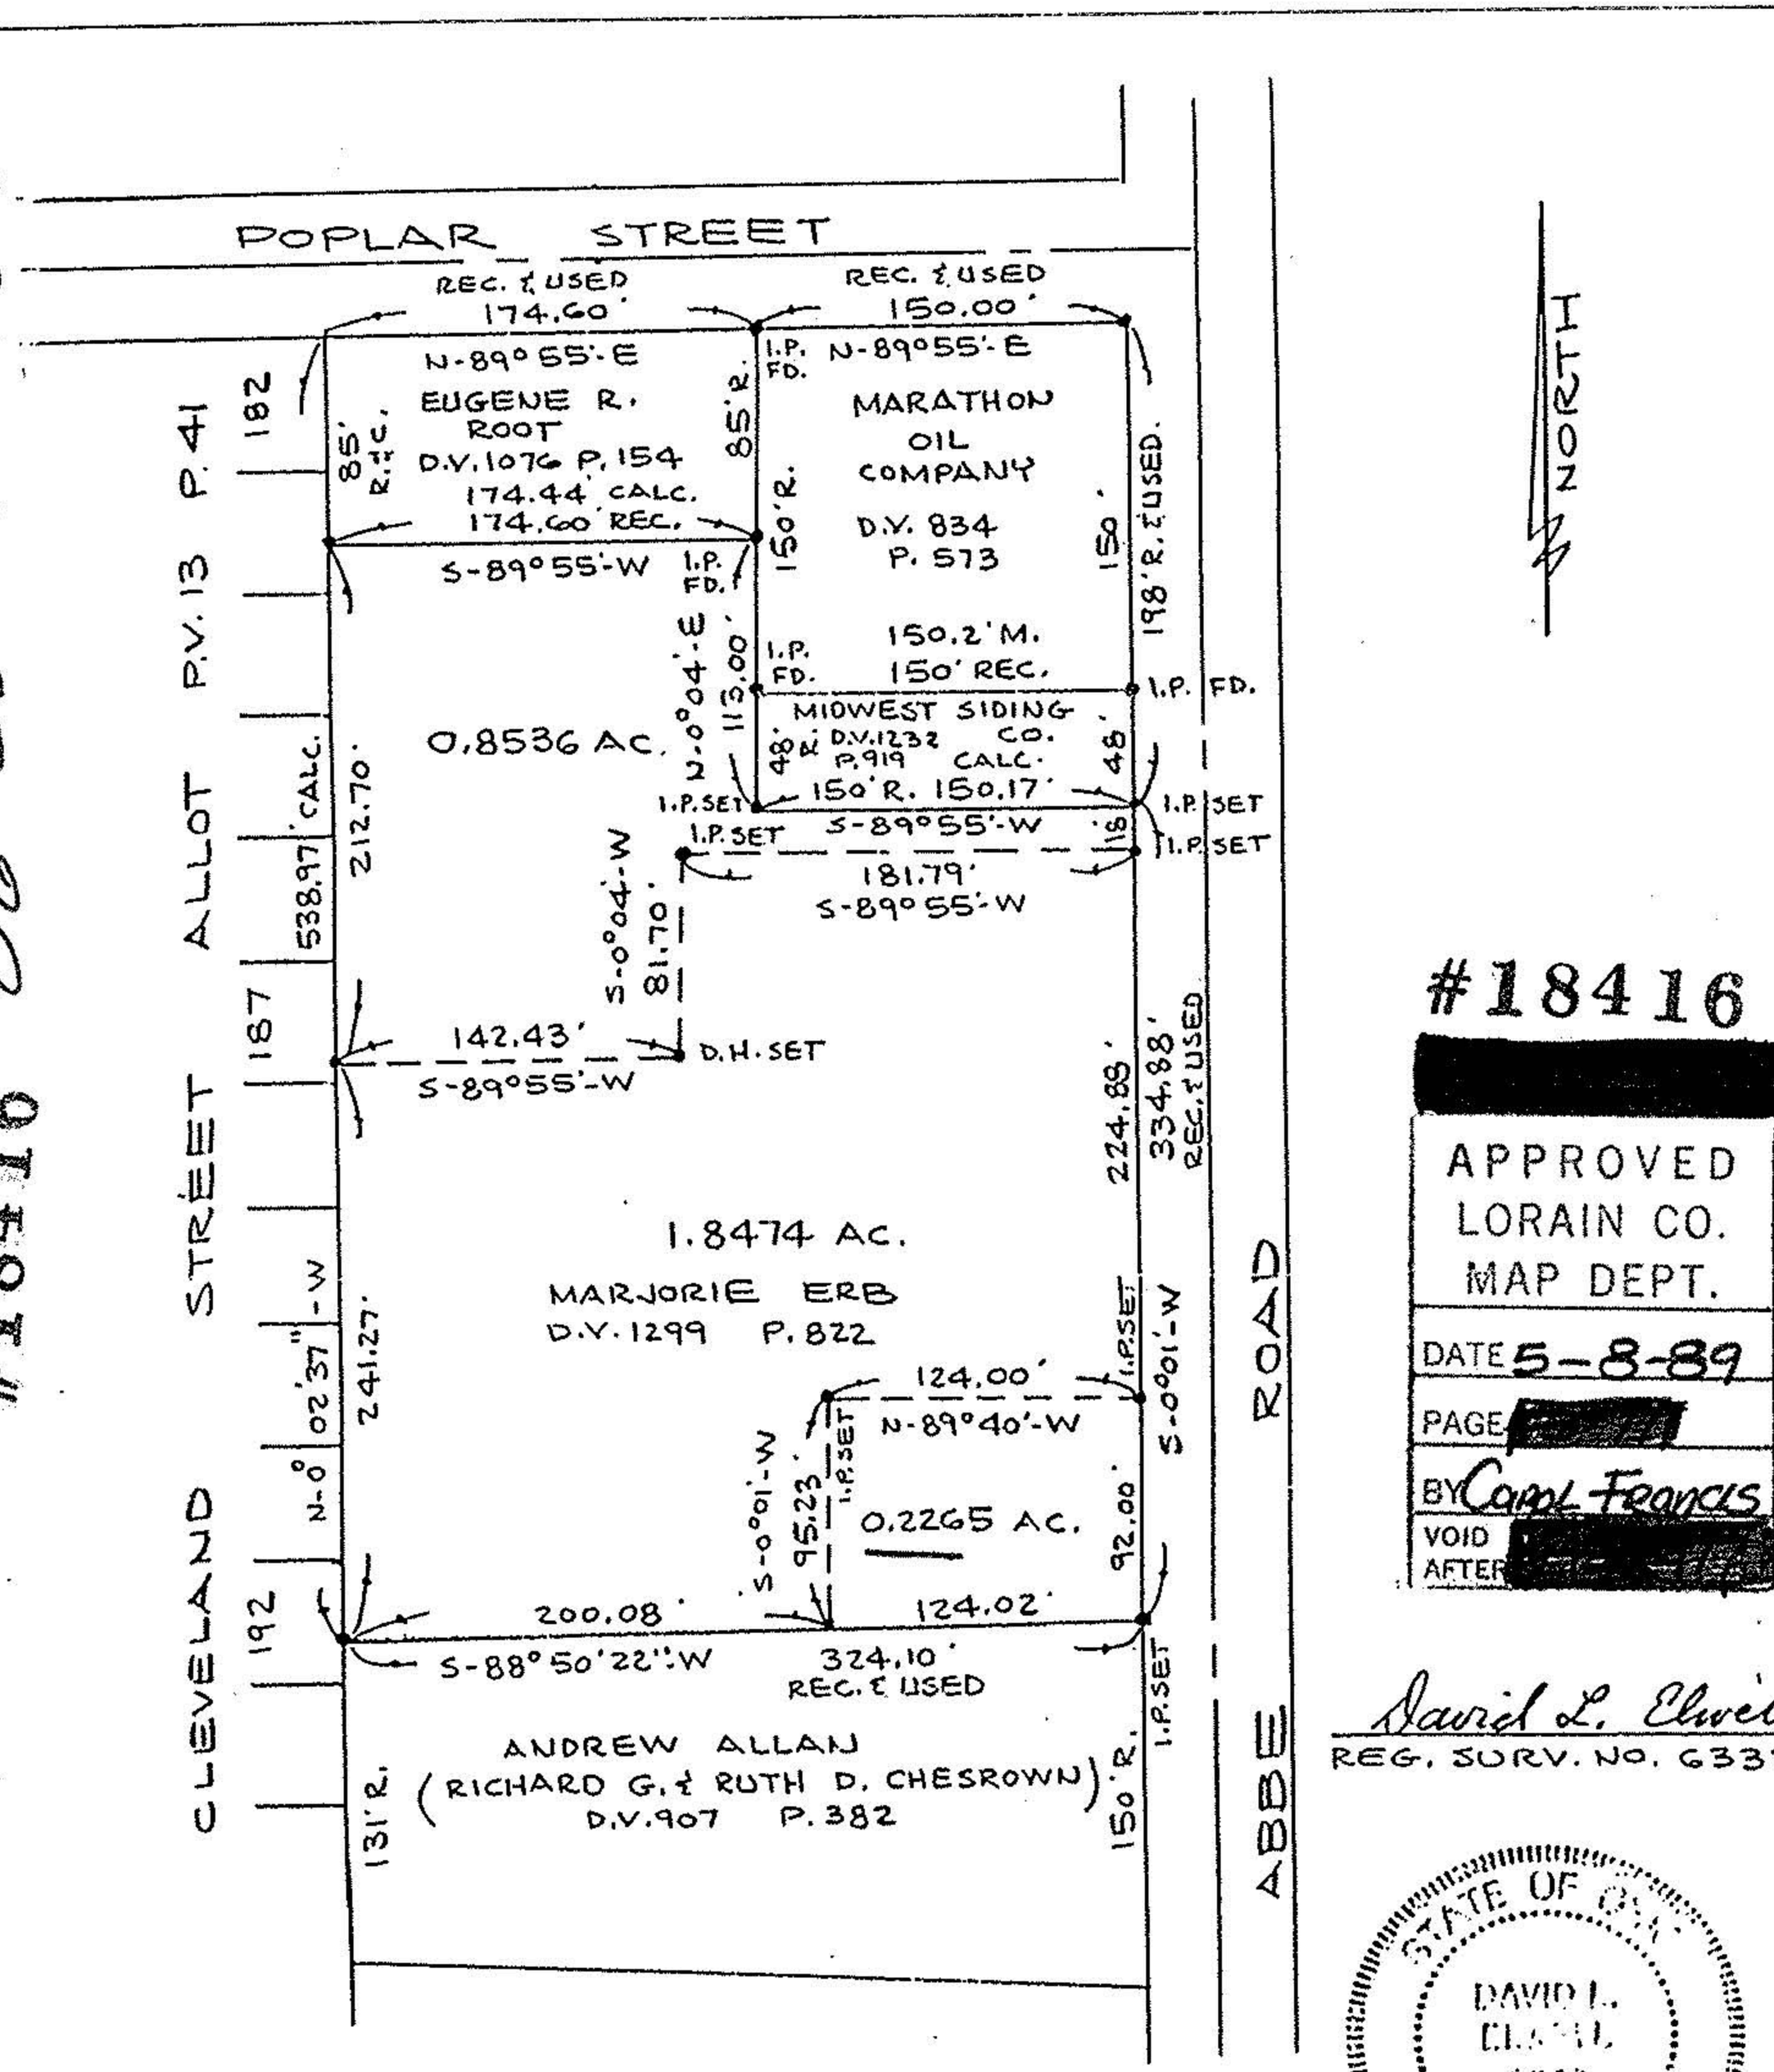

#18416

[redacted]

APPROVED
LORAIN CO.
MAP DEPT.
DATE 5-8-89
PAGE [redacted]
BY Carol Francis
VOID AFTER [redacted]

David L. Elwell
REG. SURV. NO. 6333

STATE OF OHIO
DAVID L. ELWELL
REGISTERED SURVEYOR

BOUNDARY SURVEY

PART OF ELYRIA TWP.
ORIG. LOT 21 - E. OF RIVER
CITY OF ELYRIA
COUNTY OF LORAIN
STATE OF OHIO

5-8-89

PREPARED BY:
KS ASSOCIATES INC.
ENGINEERS SURVEYORS

89-029