



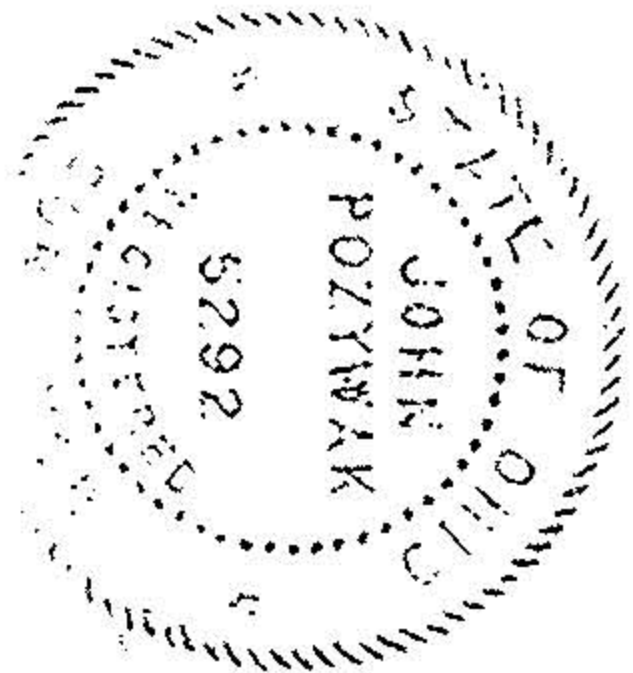

0' 30'
SCALE: 1" = 30'

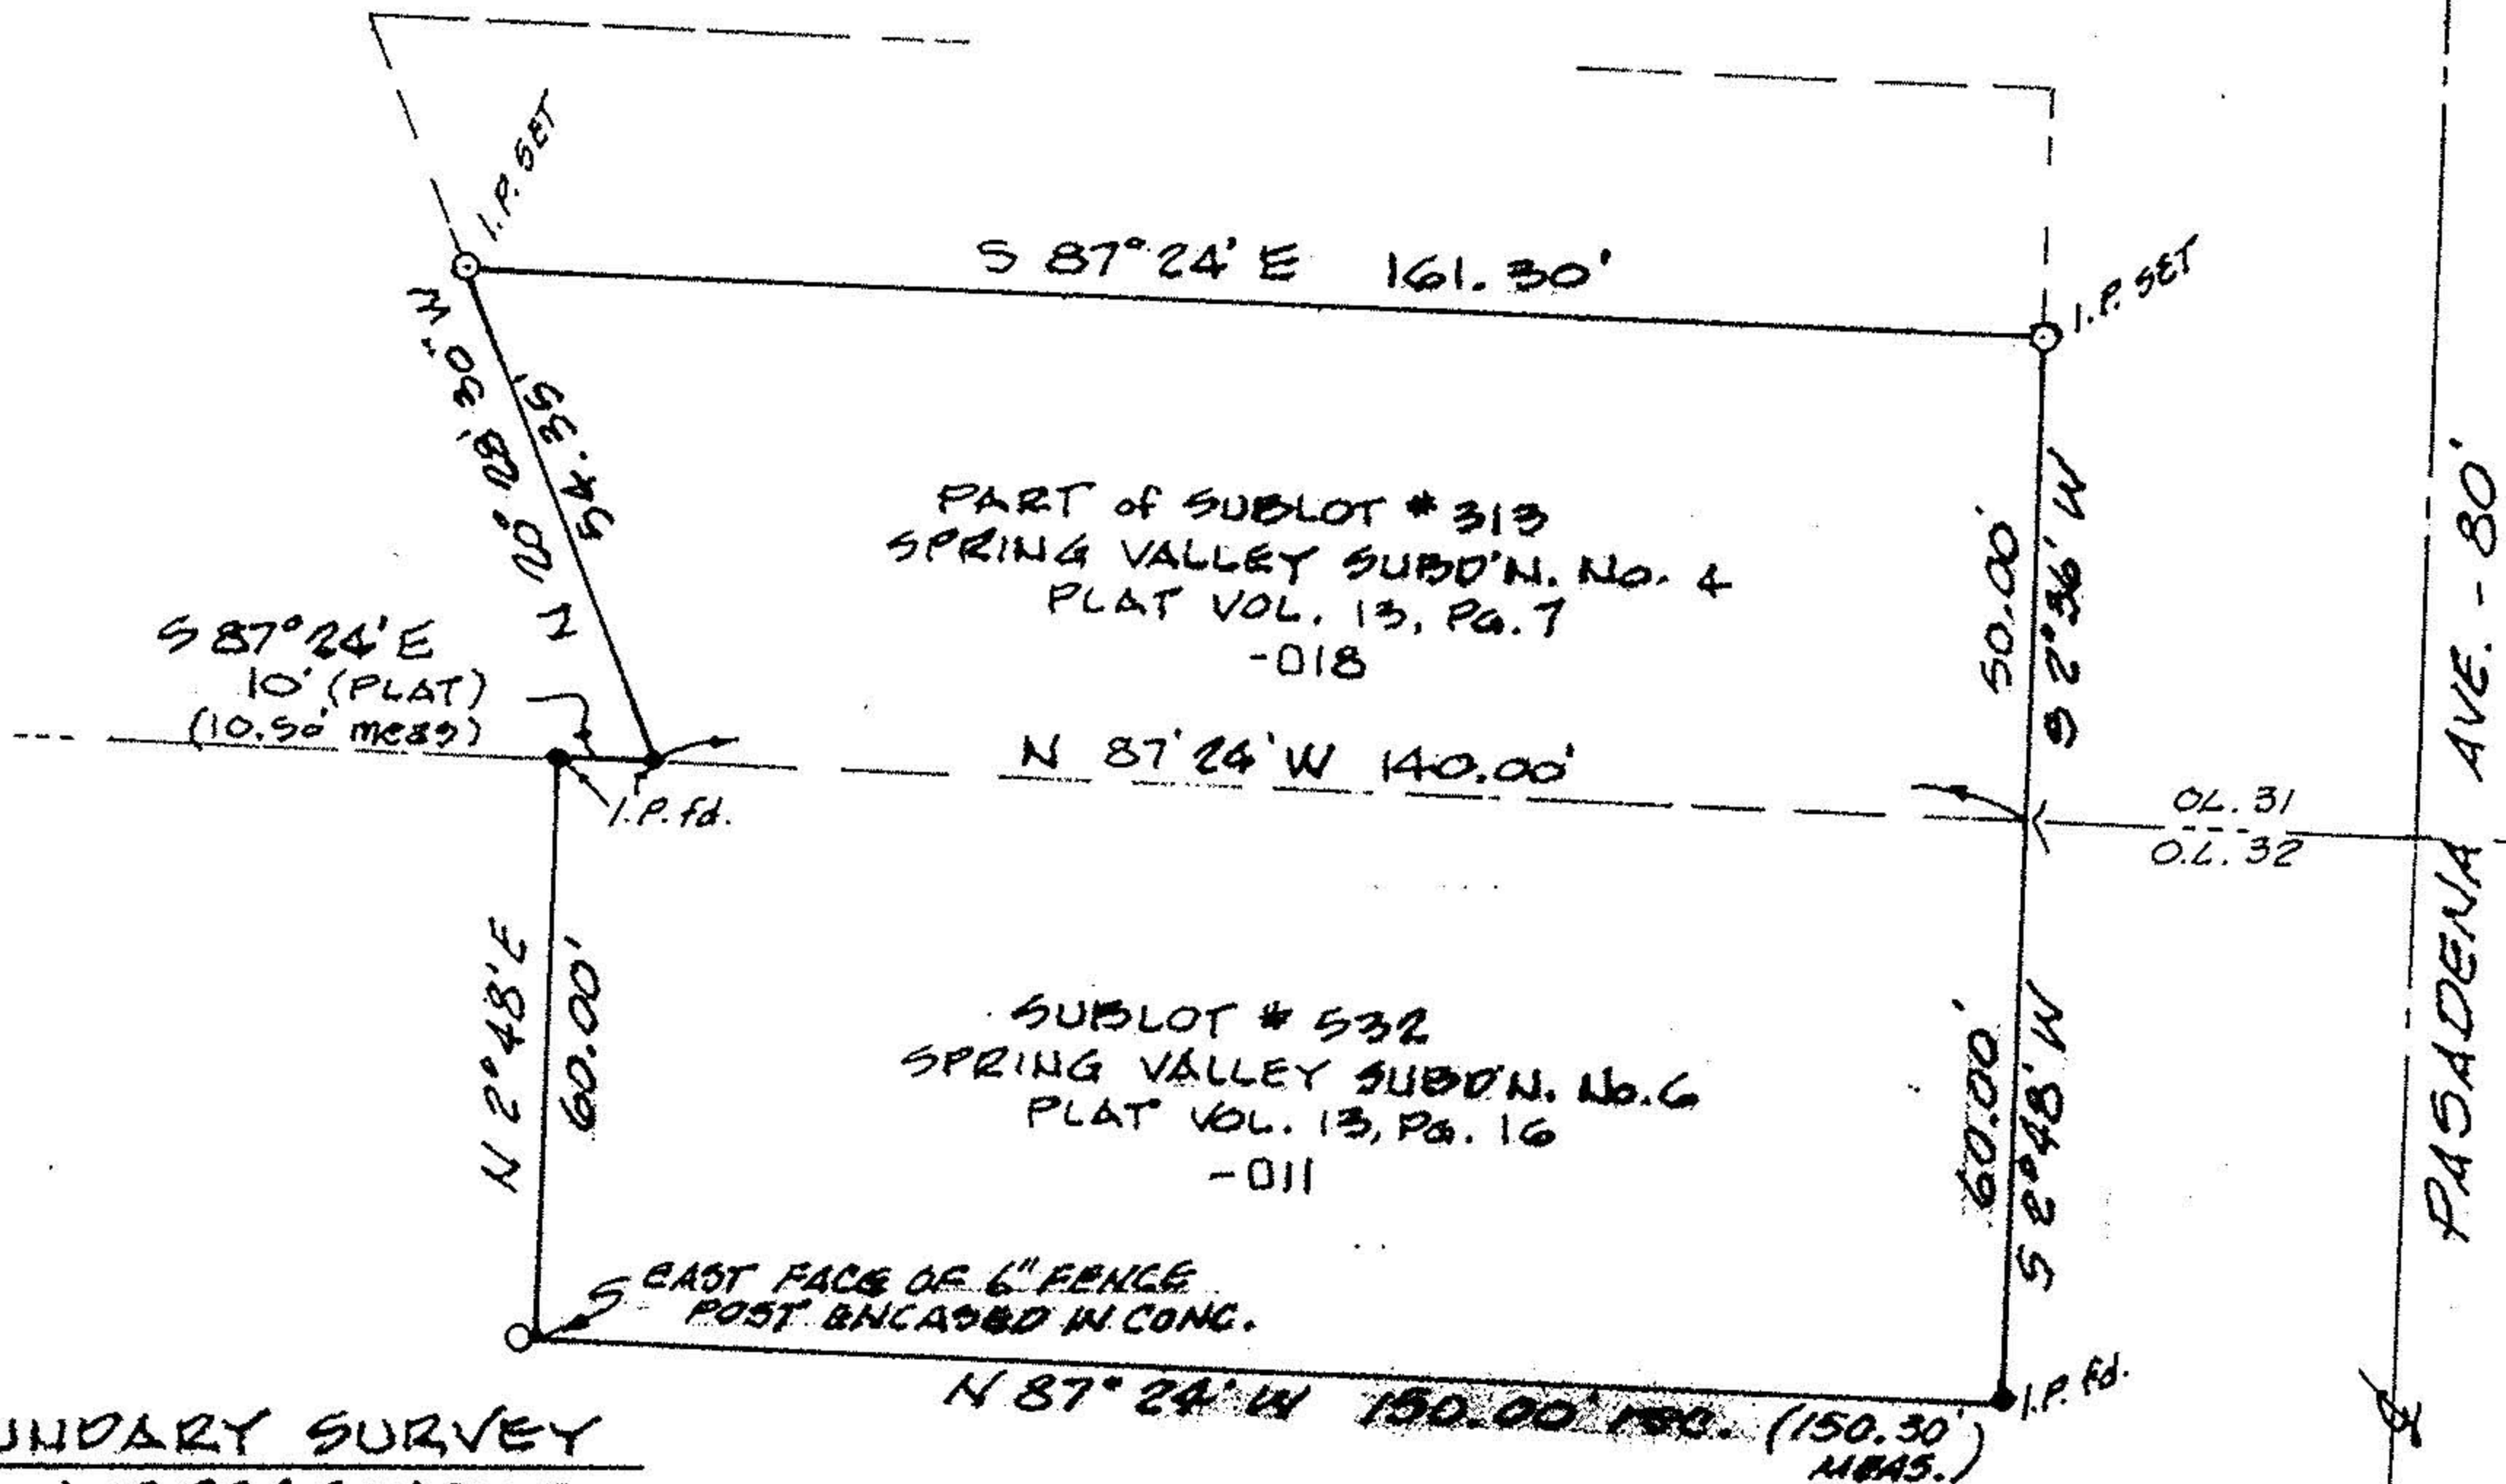

MAP of BOUNDARY SURVEY

PREPARED FOR: AUBREY SCHOLLE
 PART of SUDLOT No. 313 and ALL of SUDLOT No. 532 of
 SPRING VALLEY SUBDIVISION NOS. 4 & 6
 PLAT VOL. 13, PAGES 7 & 16
 PART of ORIG. ELYRIA TWP. LOTS 31 & 32, EAST of RIVER
 NOW in CITY of ELYRIA , OHIO
 P.P. Nos. 06-25-031-104-018
 06-25-032-107-011

K. E. McCARTNEY & ASSOCIATES
 OCTOBER, 1991 #9136859