



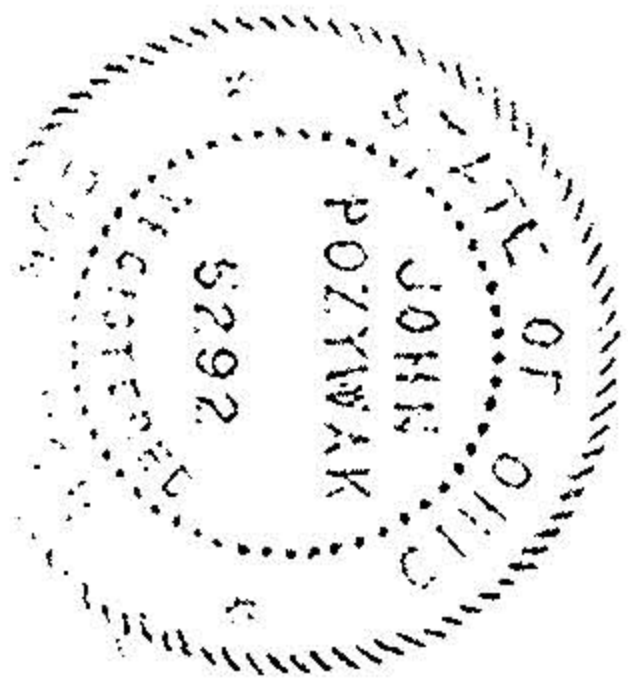

0' 30'  
SCALE: 1" = 30'

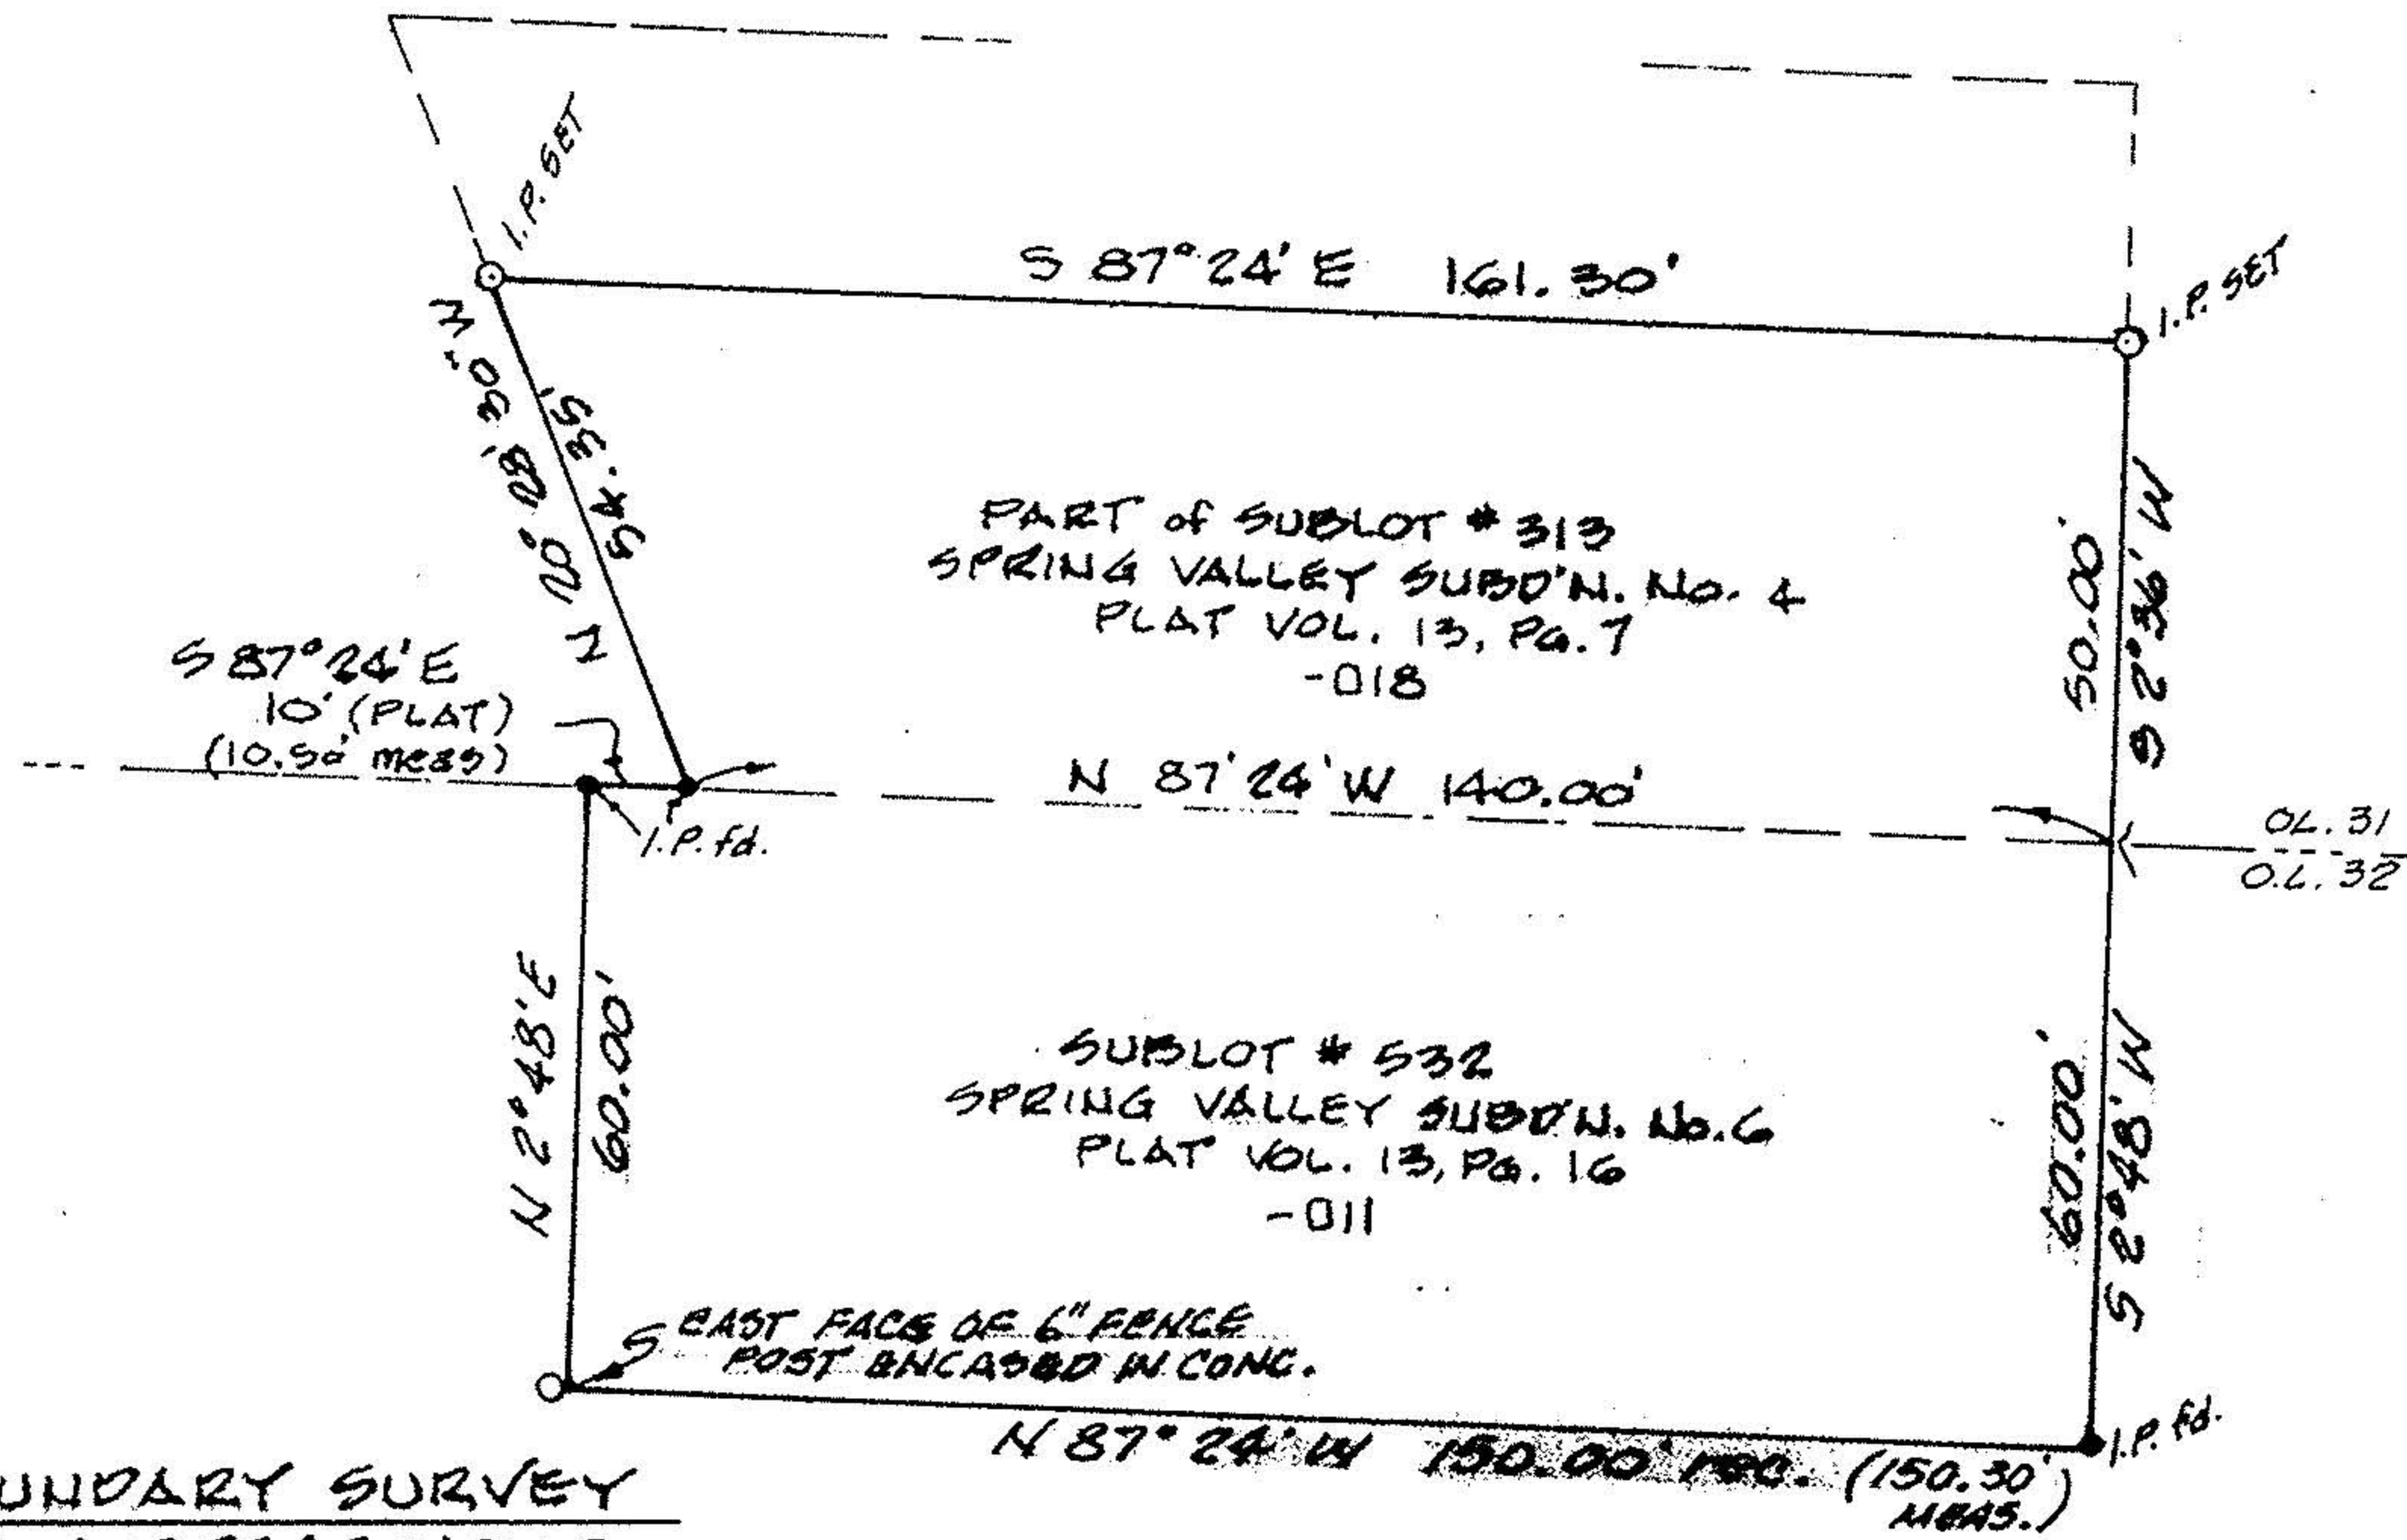

**MAP of BOUNDARY SURVEY**

PREPARED FOR: AUBREY SCHOLLE  
 PART of SUDLOT No. 313 and ALL of SUDLOT No. 532 of  
 SPRING VALLEY SUBDIVISION Nos. 4 & 6  
 PLAT VOL. 13, PAGES 7 & 16  
 PART of ORIG. ELYRIA TWP. LOTS 31 & 32, EAST of RIVER  
 NOW in CITY of ELYRIA, OHIO  
 P.P. Nos. 06-25-031-104-018  
 06-25-032-107-011

**K. E. McCARTNEY & ASSOCIATES**  
 OCTOBER, 1991 #9136859