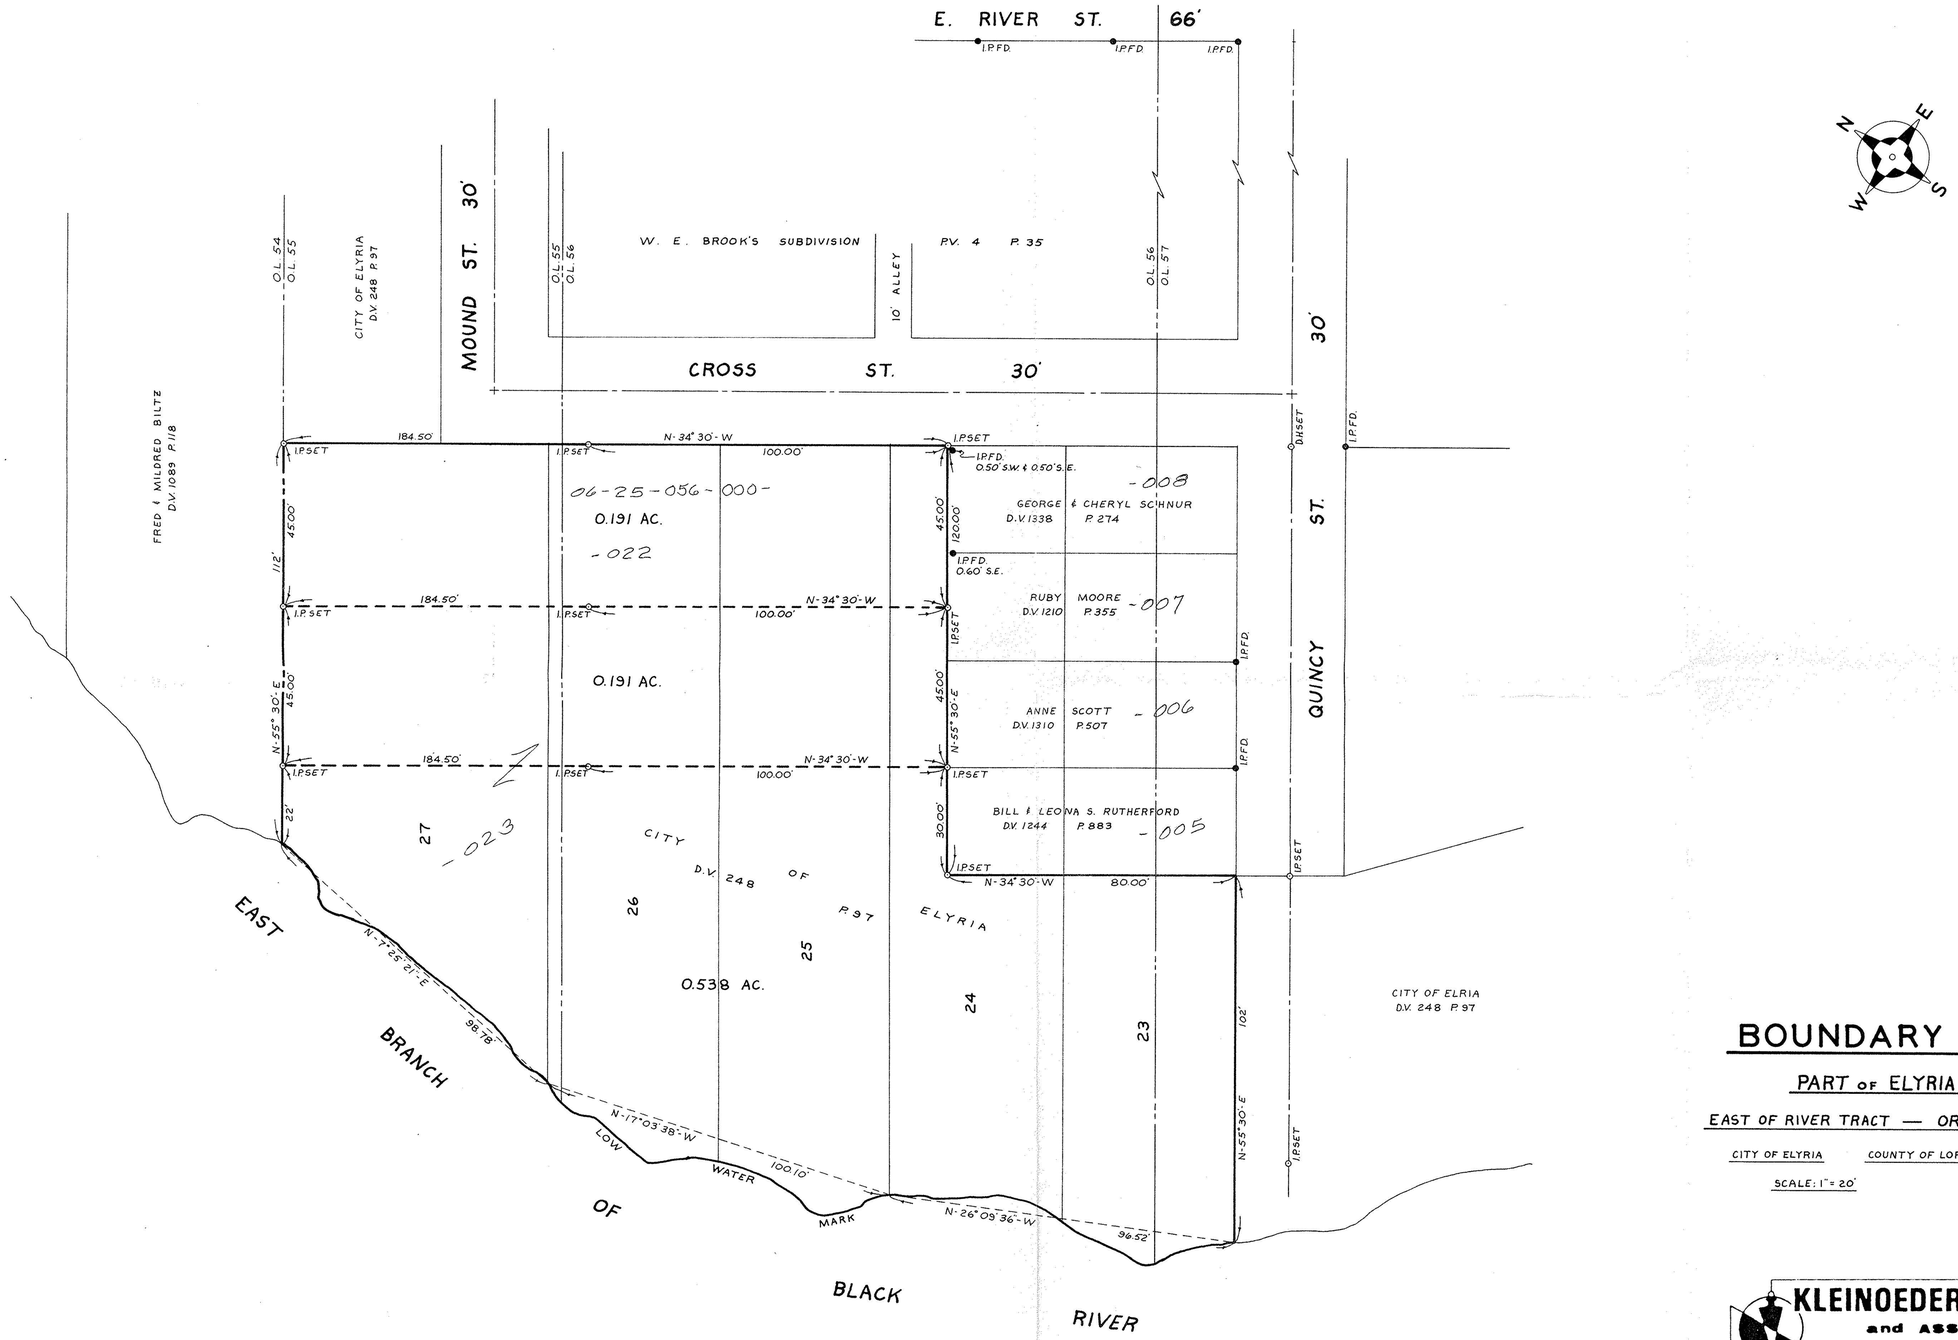

BOUNDARY SURVEY

PART OF ELYRIA TOWNSHIP

EAST OF RIVER TRACT — ORIG. LOT NO.'s 55, 56, 57

CITY OF ELYRIA | COUNTY OF LORAIN | STATE OF OHIO

SCALE: 1" = 20' | NOVEMBER 14, 1984

KLEINOEDER · SCHMIDT and ASSOCIATES
ENGINEERS — SURVEYORS — CONSULTANTS in LAND PLANNING
ELYRIA OHIO

#16149
APPROVED
LORAIN CO.
MAP DEPT.
DATE 4-29-85
PAGE 6-103
BY T. McNair
VOID

JOB NO. 84-169

6-103
06-25-056-000
#16149