


023 East Black River Elyria Ohio
 06-25-085

6-139

Frank & Lena Defazio D. Vol. 203 Pg. 422
 Robert J. & Marcia J. Gardner D. Vol. 913 Pg. 613

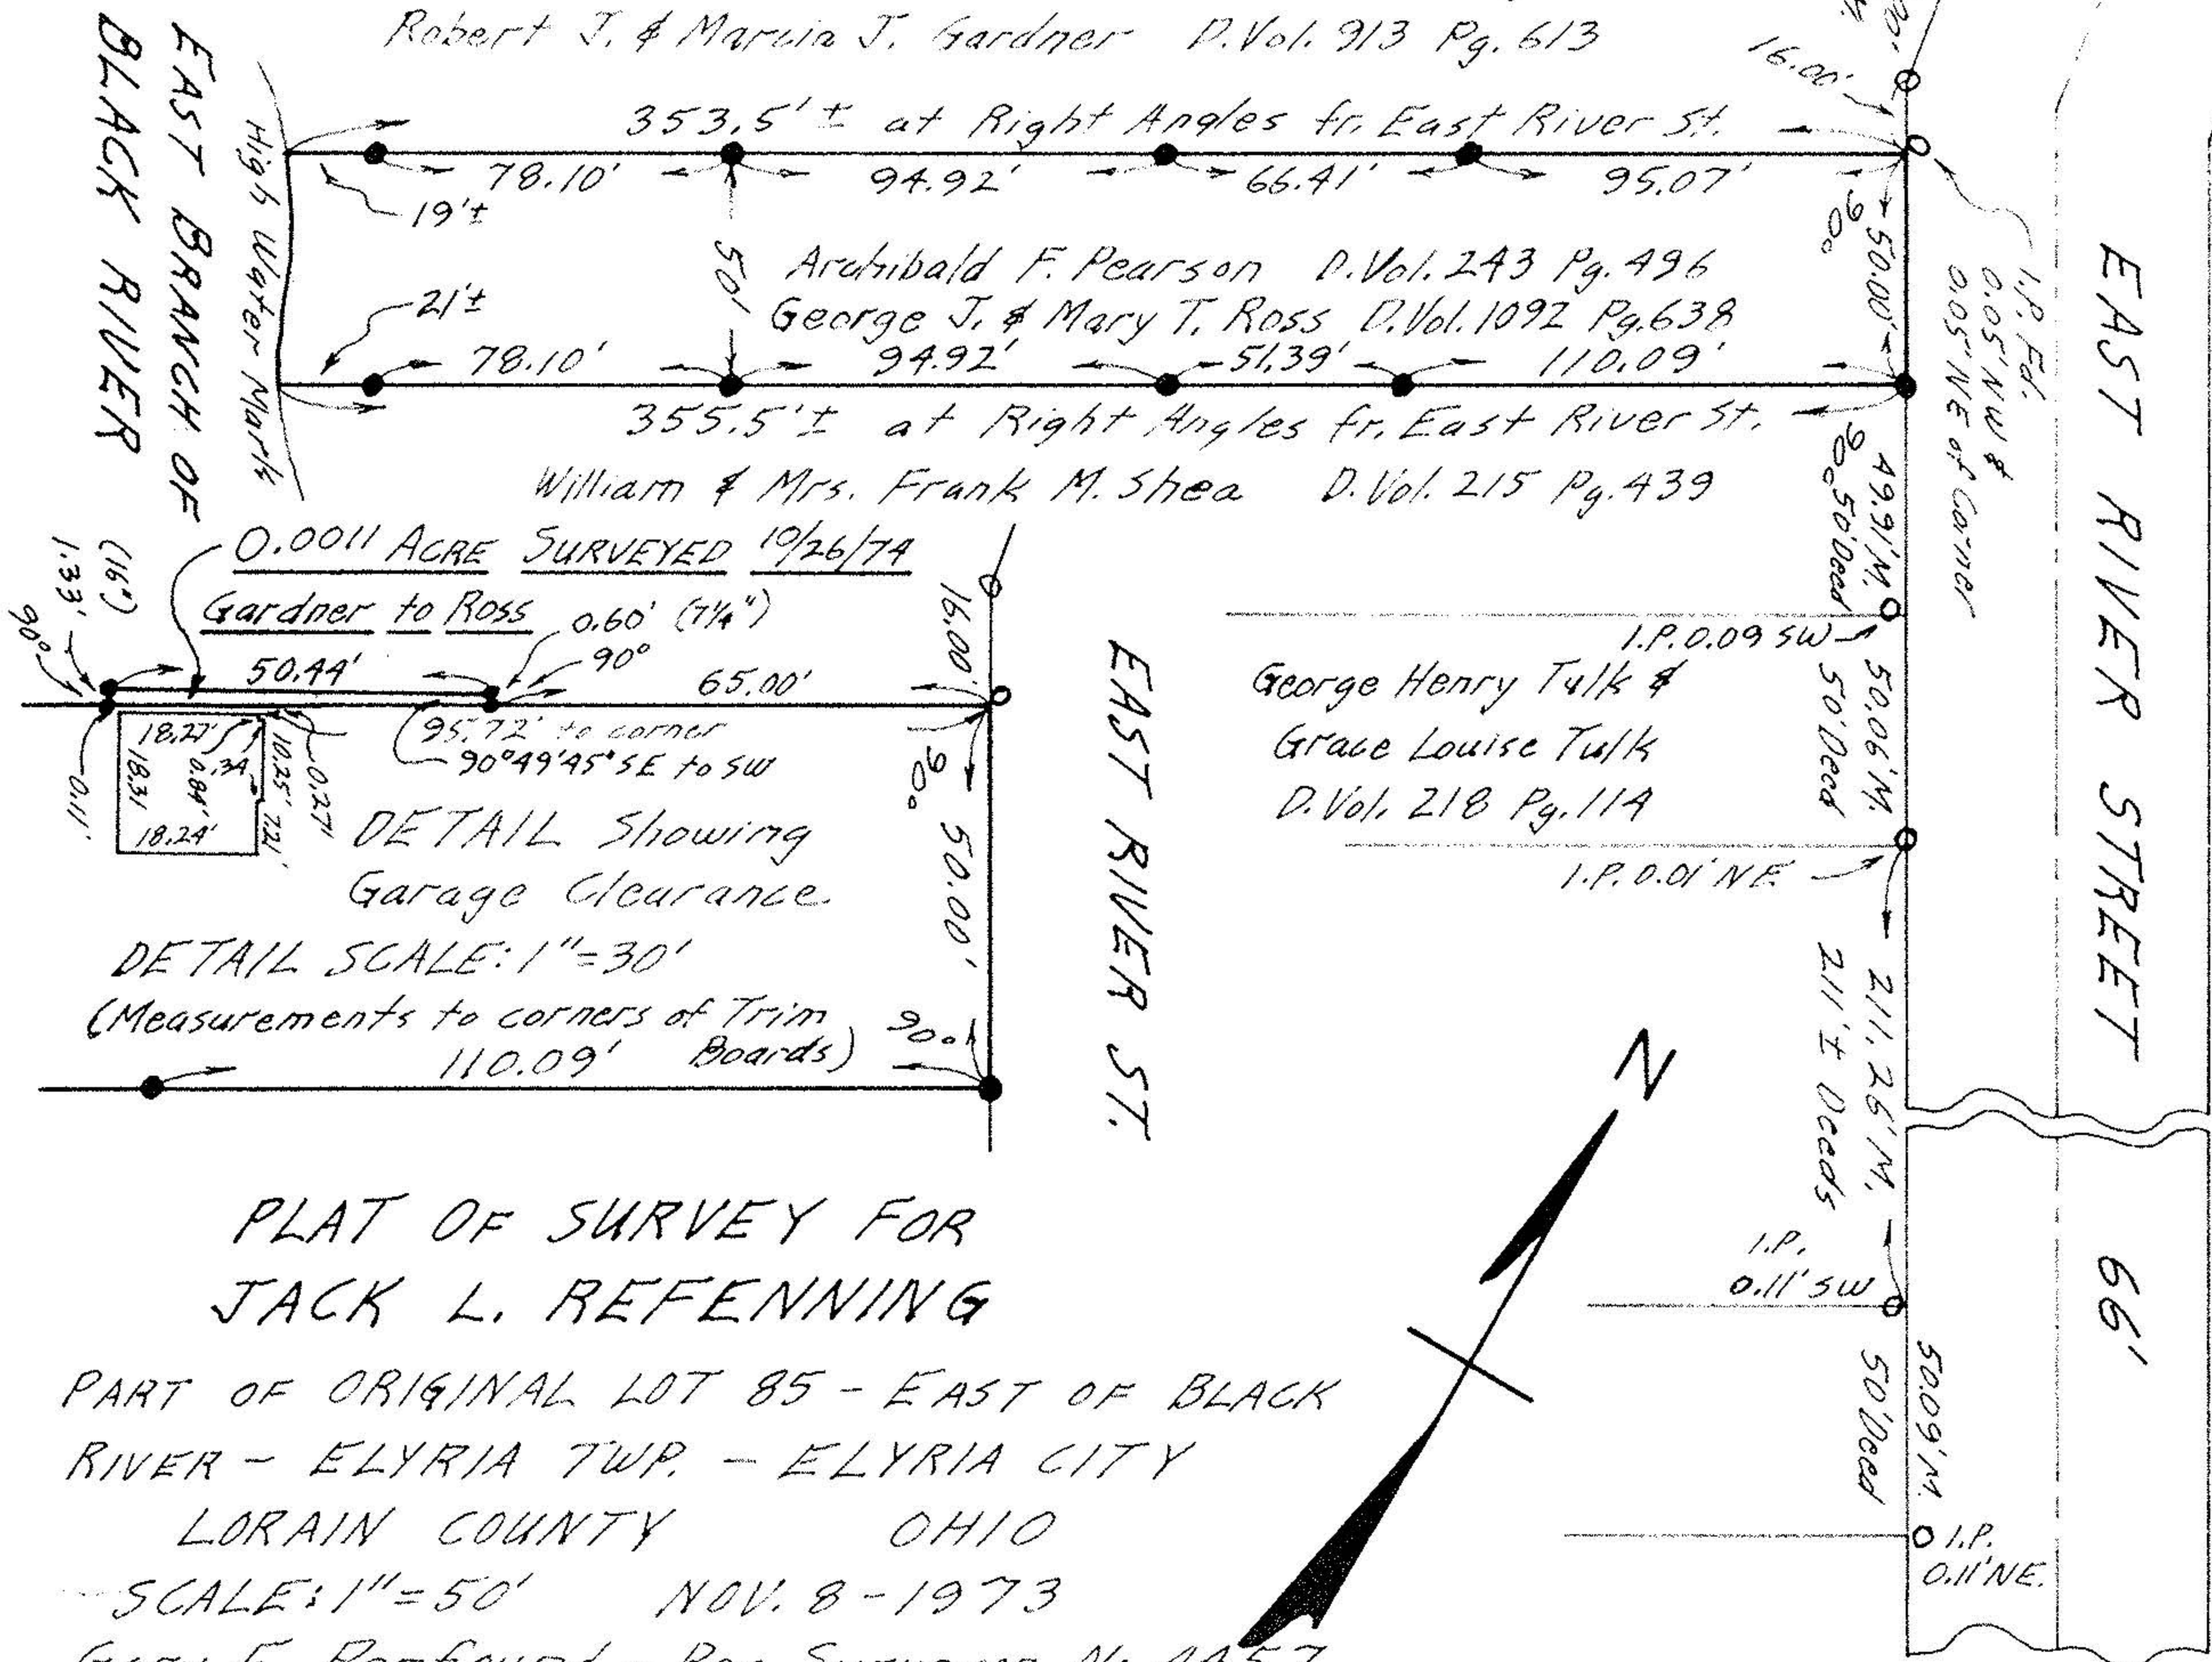

NOTES: ○ indicates iron pin found.
 ● indicates iron pin set.

PLAT OF SURVEY FOR
 JACK L. REFENNING

PART OF ORIGINAL LOT 85 - EAST OF BLACK
 RIVER - ELYRIA TWP. - ELYRIA CITY
 LORAIN COUNTY OHIO

SCALE: 1" = 50' NOV. 8 - 1973
 Gary E. Penfound - Reg. Surveyor No. 4457