KLEINOEDER · SCHMIDT and ASSOCIATES

ENGINEERS — SURVEYORS — CONSULTANTS in LAND PLANNING

ELYRIA · NORWALK · MEDINA OHIO

SURVEY

Sublot(s) 9 & 10

Subd'n GULF FARMS ADDN.

Township ELYRIA

Orig. Lot(s) 162, 161

County of LORAIN

Corporation ELYRIA

Tract EAST OF THE RIVER

Sec.

State of Ohio

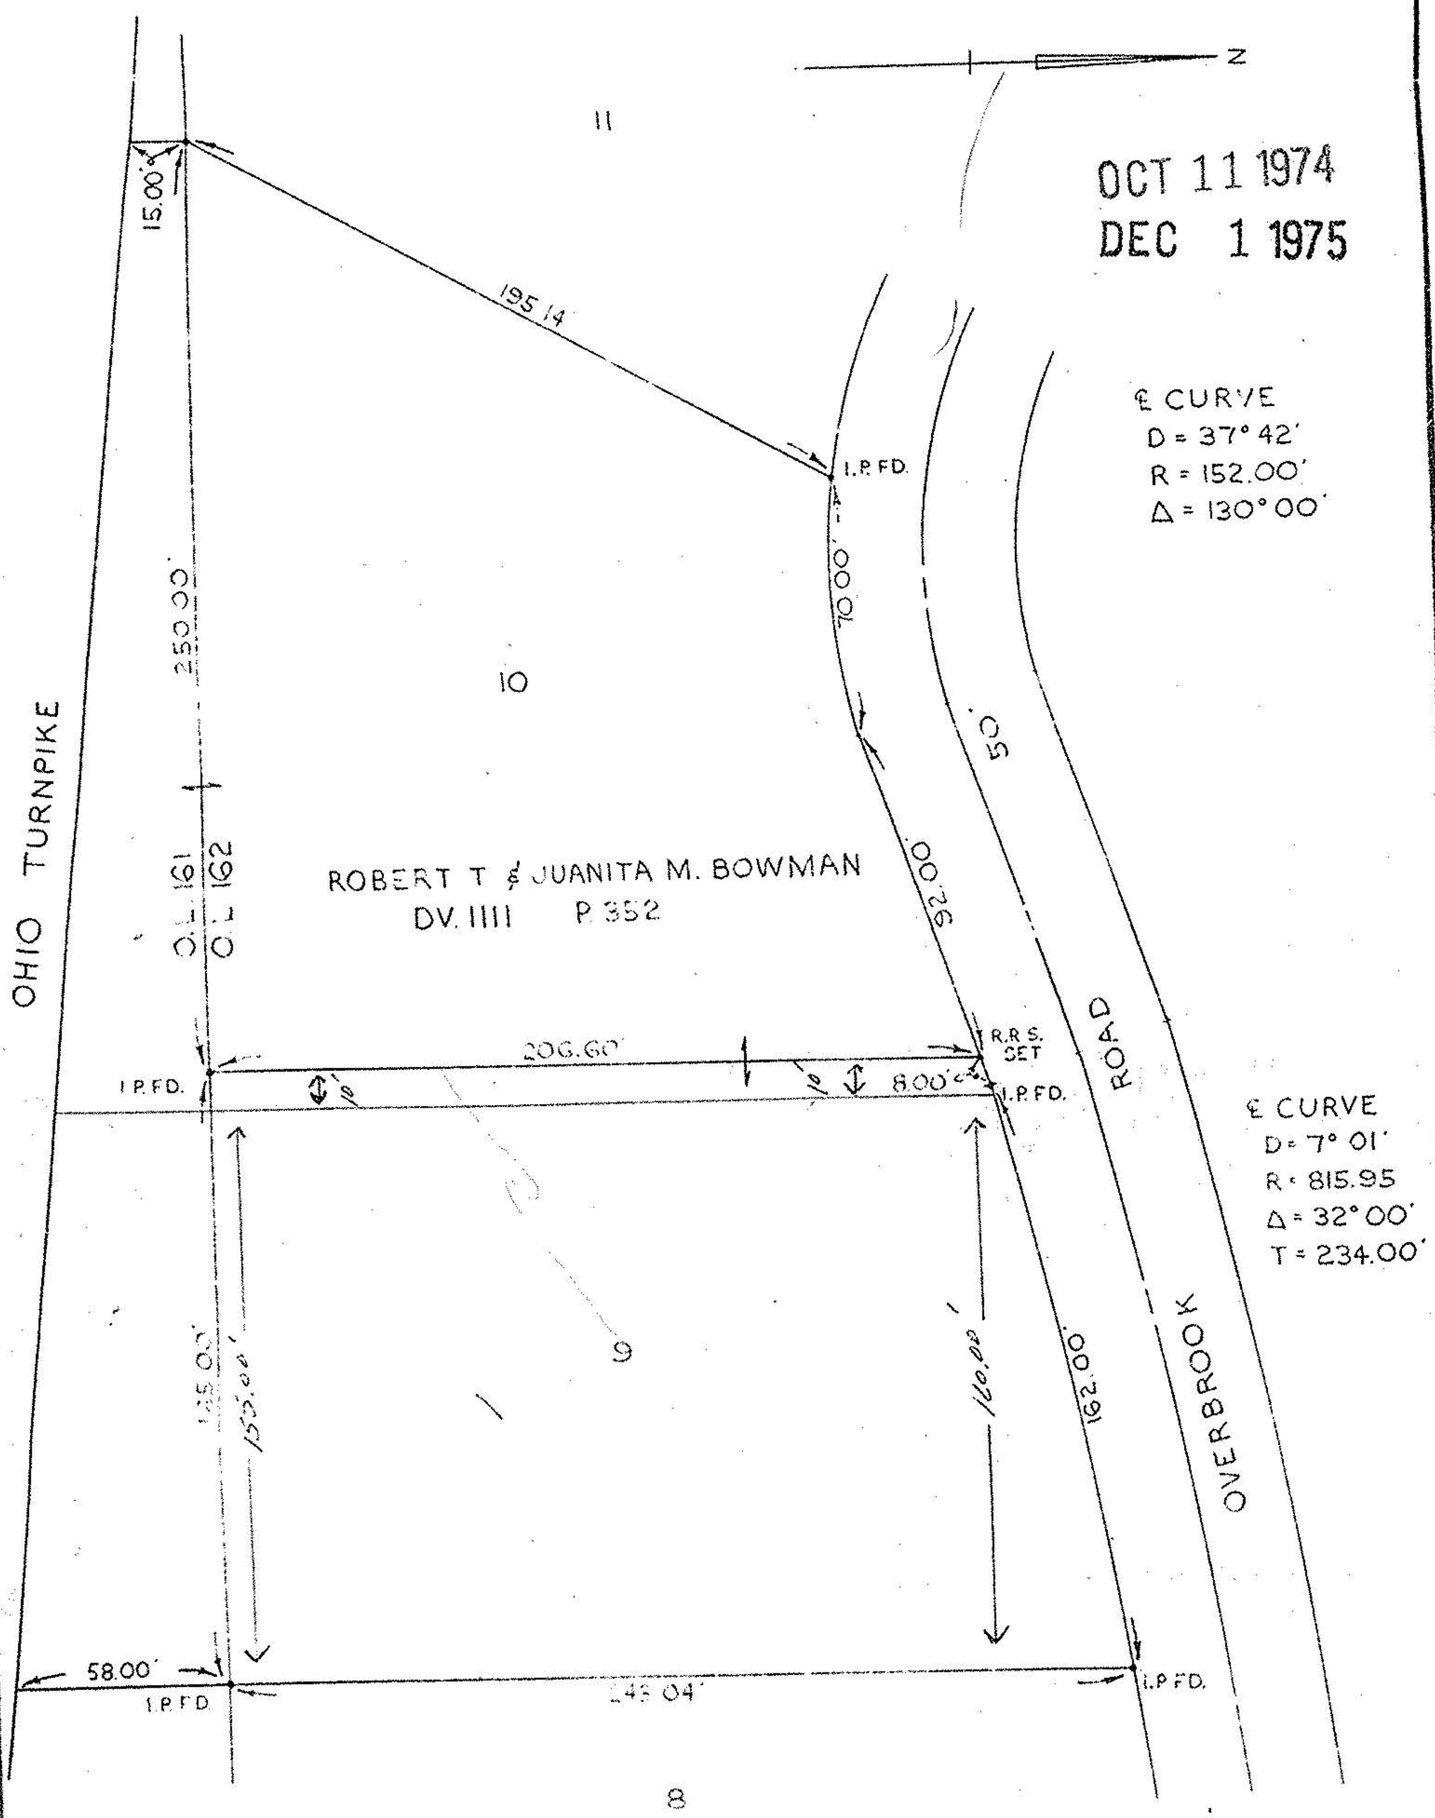

Prepared for: ROBERT T. BOWMAN

Scale: 1" = 50'	Date: 9-9-74	Dr. by:	Job No 74-238