6-67 6-85

KLEINOEDER · SCHMIDT and ASSOCIATES

ENGINEERS — SURVEYORS — CONSULTANTS in LAND PLANNING

ELYRIA · NORWALK · MEDINA OHIO

SURVEY

Sublot(s) 5 & 6, SECTION A

Subd'n GULF FARMS ALLOT. P.V. 10 P. 24

Township ELYRIA

Tract EAST OF THE RIVER

Orig. Lot(s) 161 & 162

Sec.

County of LORAIN

State of Ohio

Corporation ELYRIA

06-25-161-000
162-101

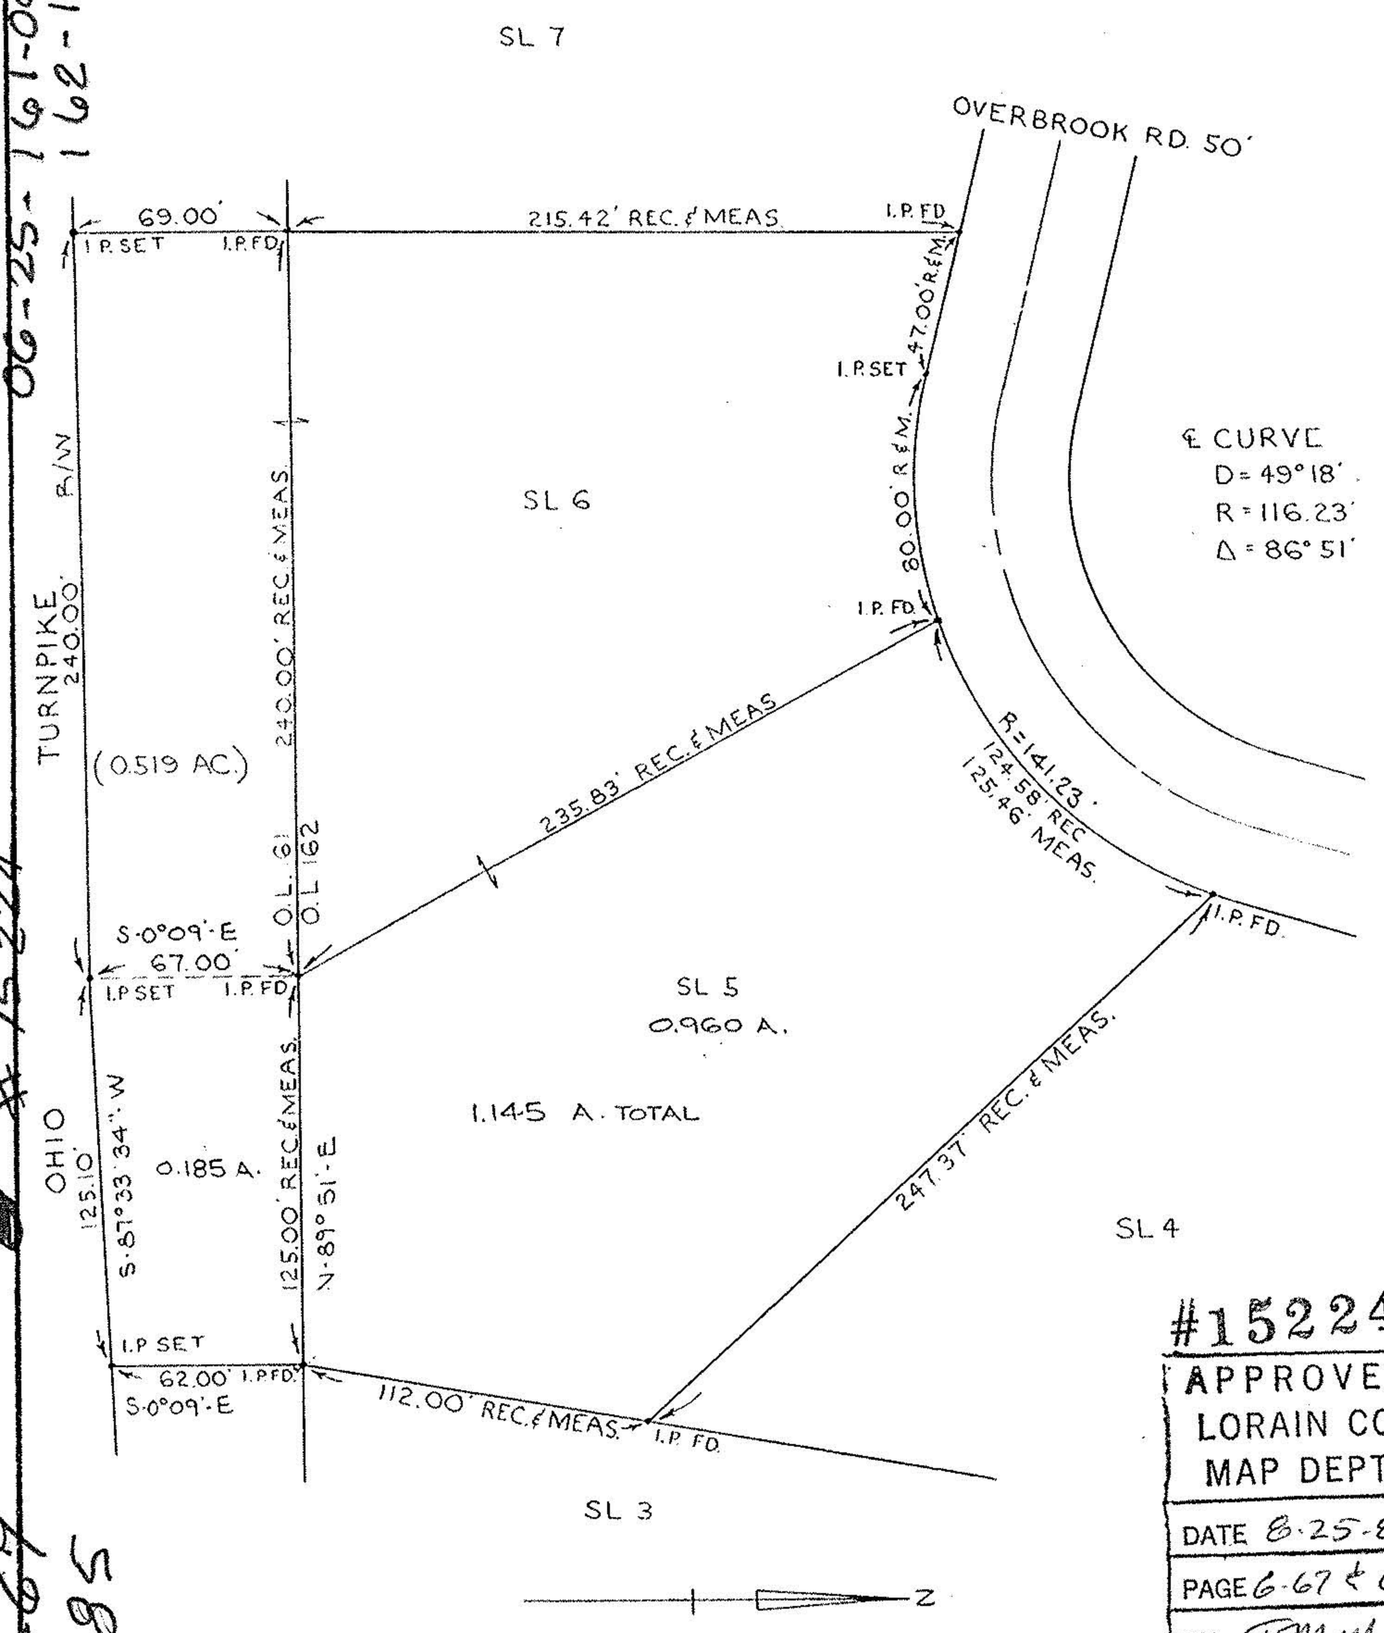

#15224

APPROVED
LORAIN CO.
MAP DEPT.
DATE 8-25-83
PAGE 6-67 & 6-85
BY T. McNair
VOID AFTER

#15224

6-67
6-85

Prepared for: HARVEY C. HATFIELD

REVISED 8-12-83

Scale: 1" = 60'	Date: NOV. 27, 1974	Dr. by: DLH	Job № 74-290