06-25-172
173

6-50

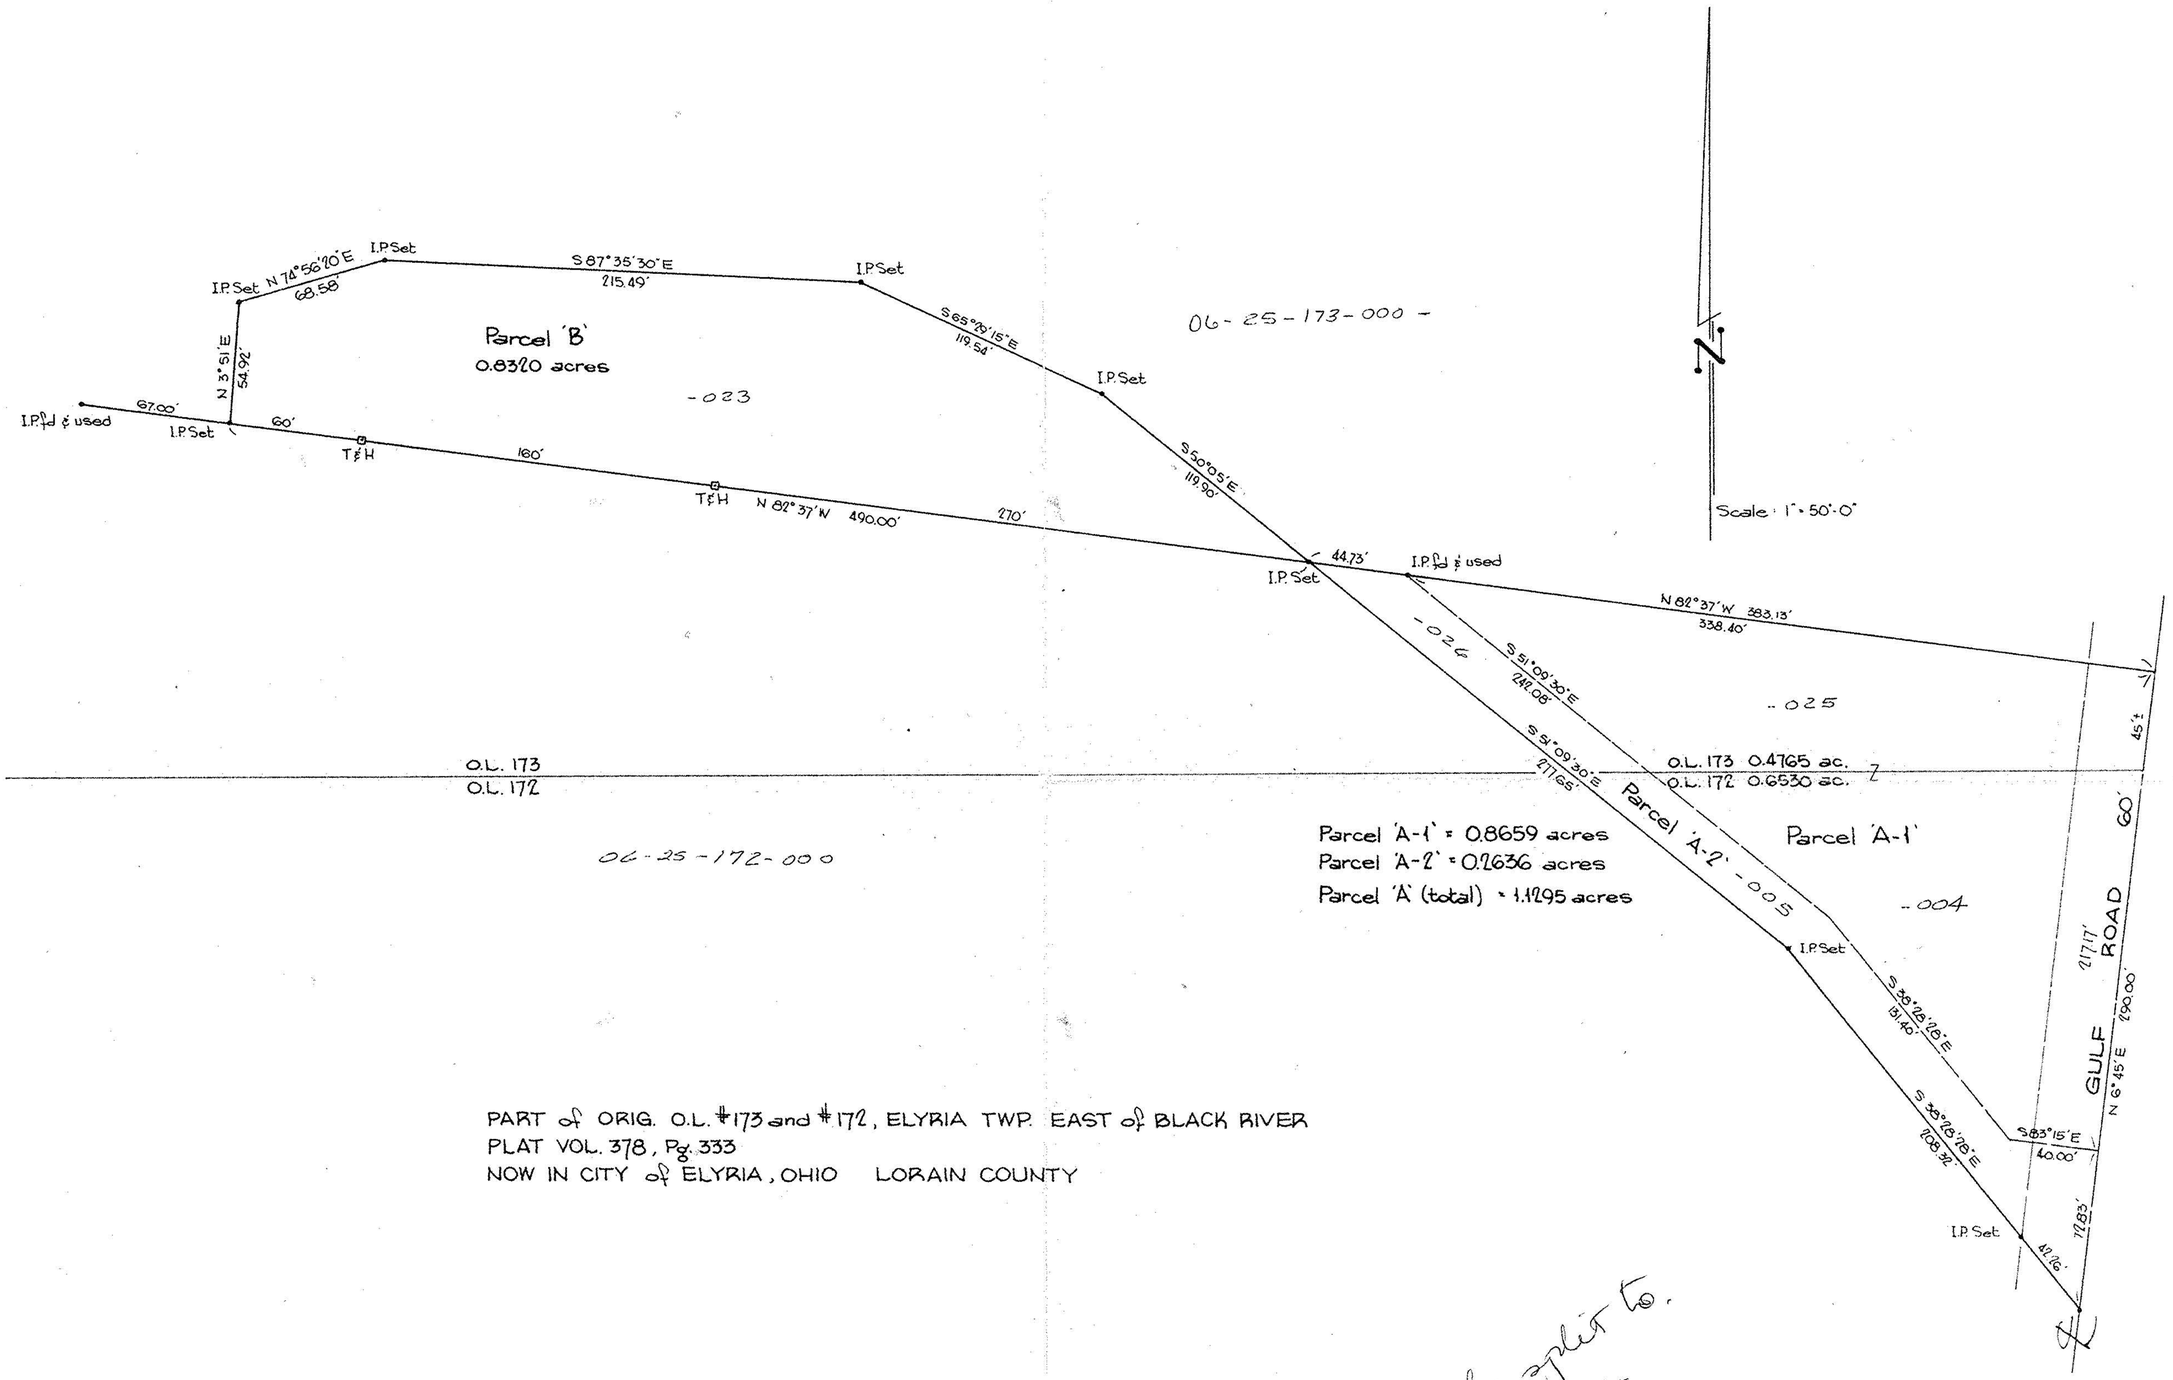

#9876
6-50

Parcel 'A-1' = 0.8659 acres
Parcel 'A-2' = 0.2636 acres
Parcel 'A' (total) = 1.1295 acres

PART of ORIG. O.L. #173 and #172, ELYRIA TWP. EAST of BLACK RIVER
PLAT VOL. 378, Pg. 333
NOW IN CITY of ELYRIA, OHIO LORAIN COUNTY

this split to. comes

McGLINCHY and ASSOCIATES
PROFESSIONAL ENGINEERS & SURVEYORS
538 WEST BROAD ST. ELYRIA, OHIO
MAY 12, 1976 #76899

ELR 06-25-173 172