LAUNDON . SIMON . CAHL & ASSOC. INC.
CONSULTING ENGINEERS & SURVEYORS
ELYRIA, OHIO 44035

SURVEY FOR:

MATT McGUIRE
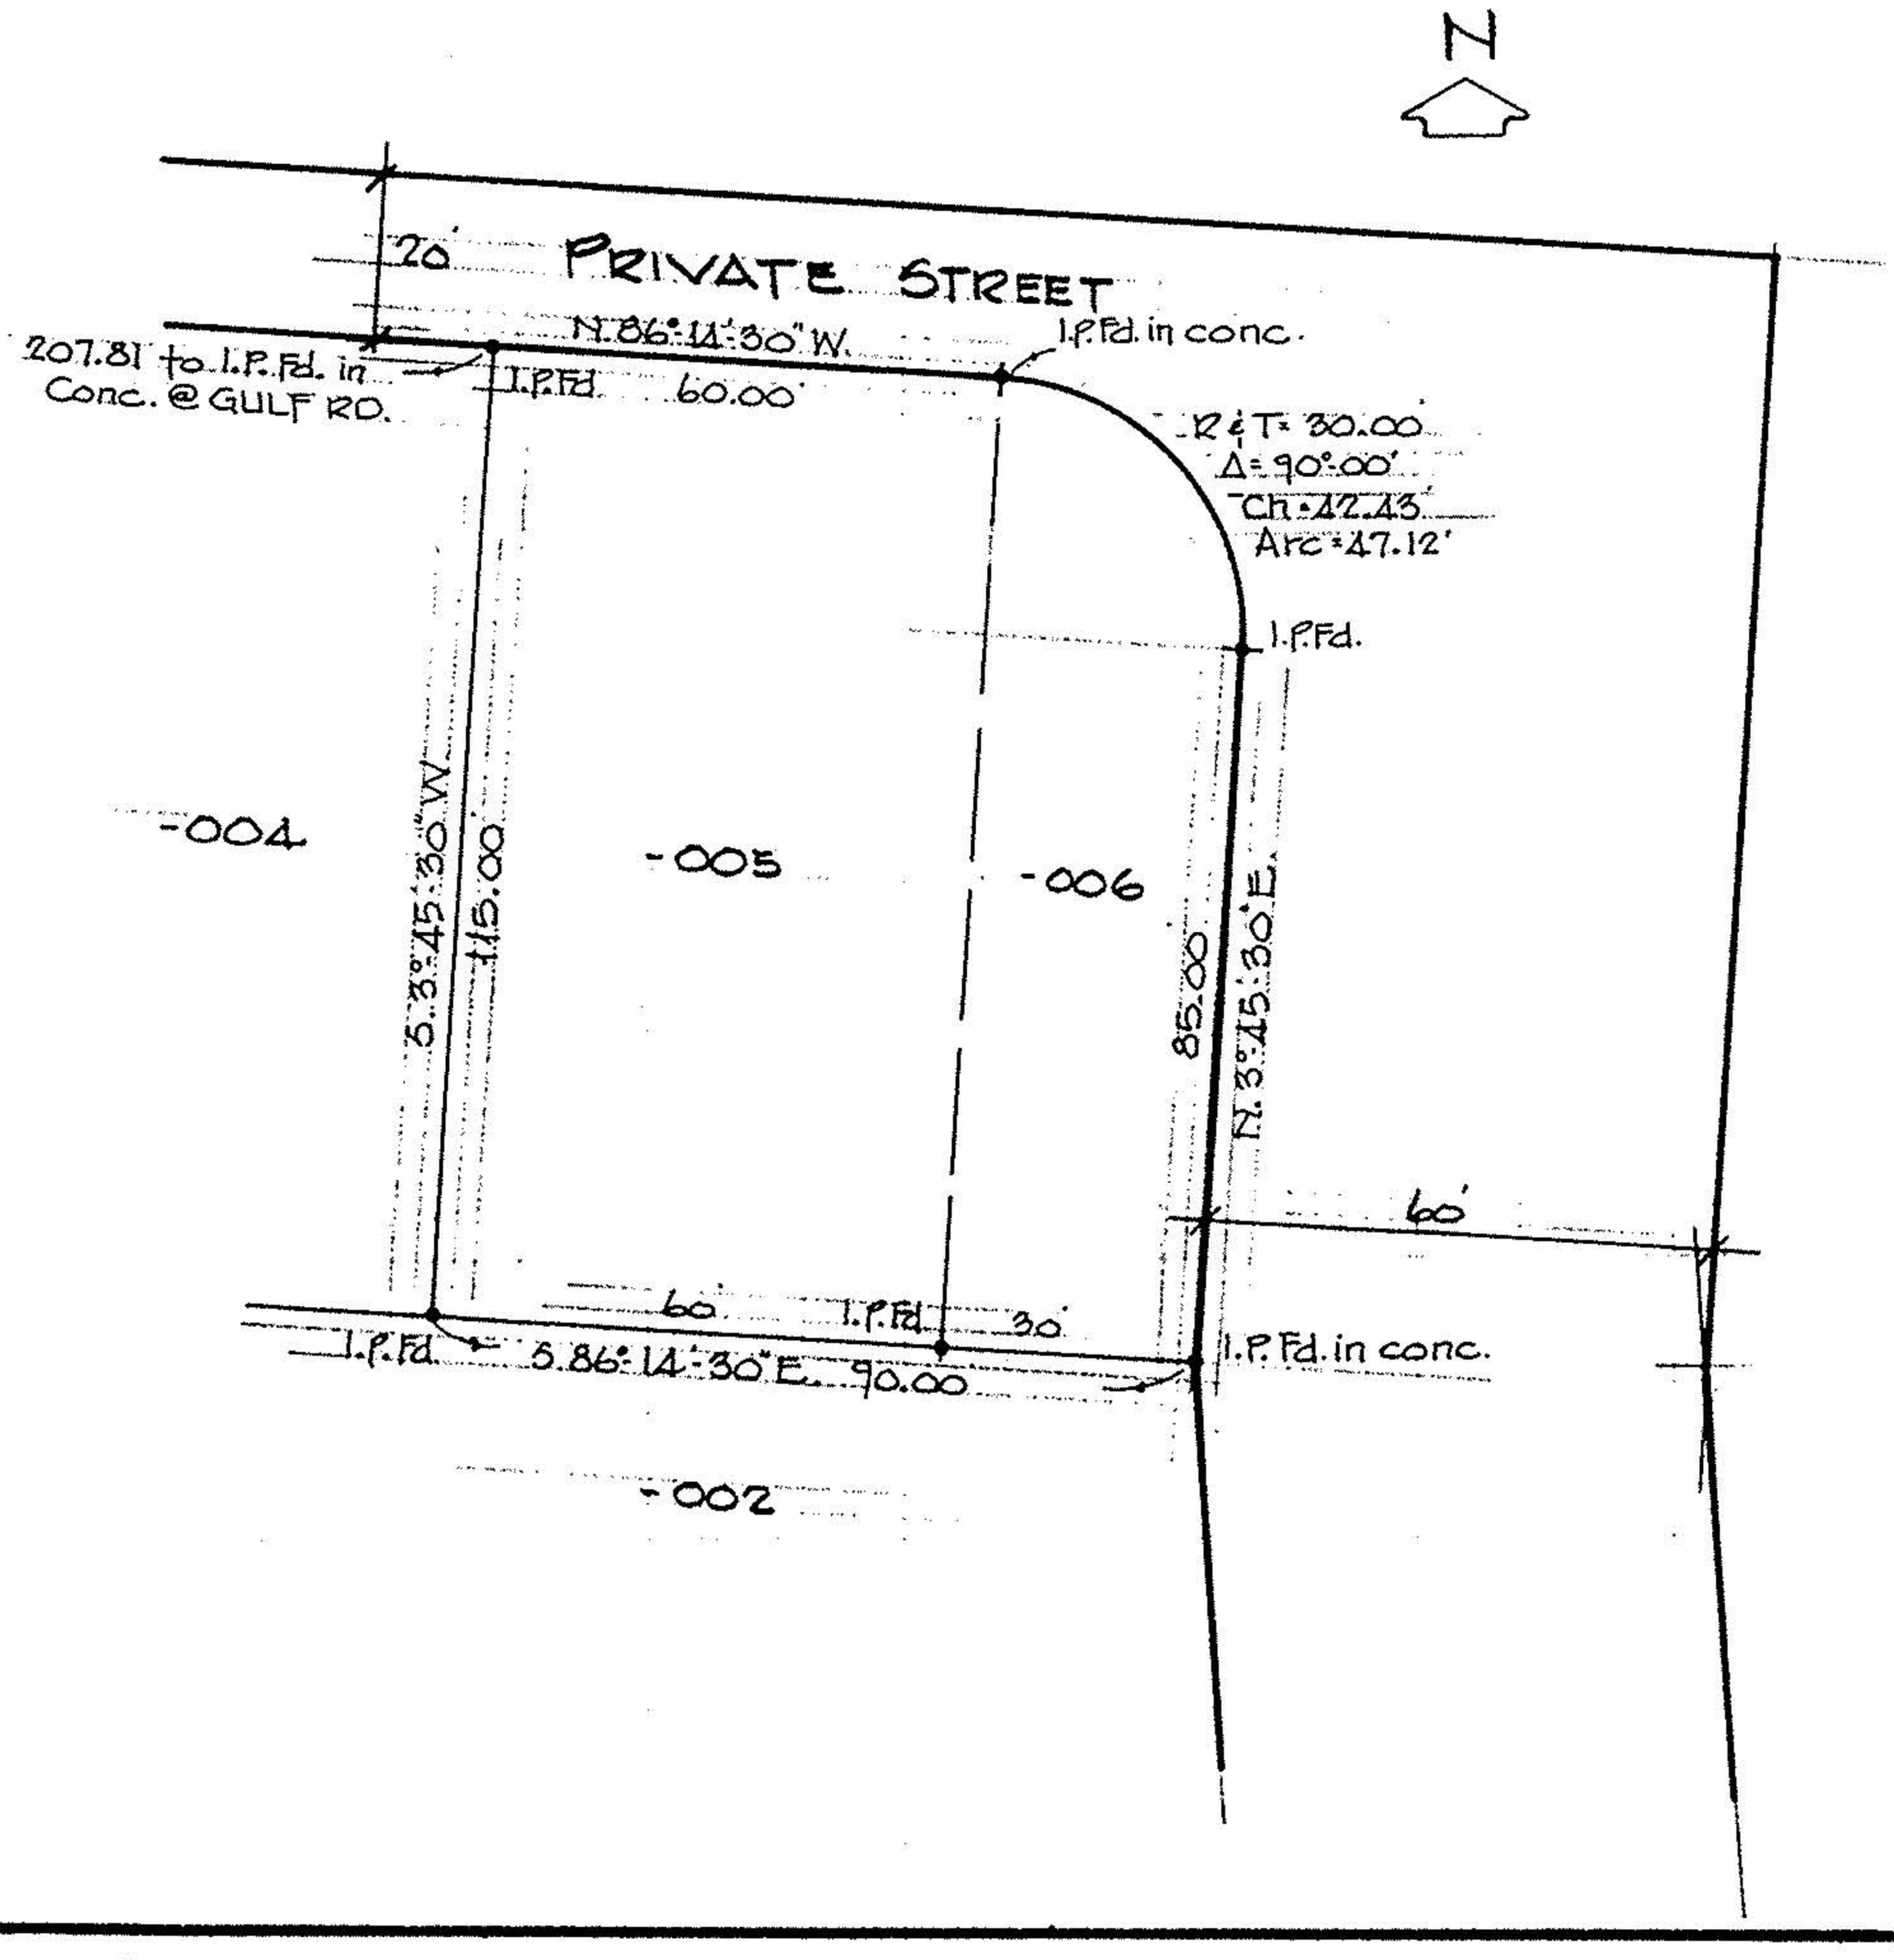
Orig. Lot 174	City of ELYRIA	Date OCT. '90 Scale 1"=30'
Orig. Sec	Village of	Dwn. by R.G.S. Chkd. by K.D.
Tract EAST of RIVER	County of LORAIN	Job No. 90-1975 F.B.
Township of ELYRIA	State of OHIO	Printed